


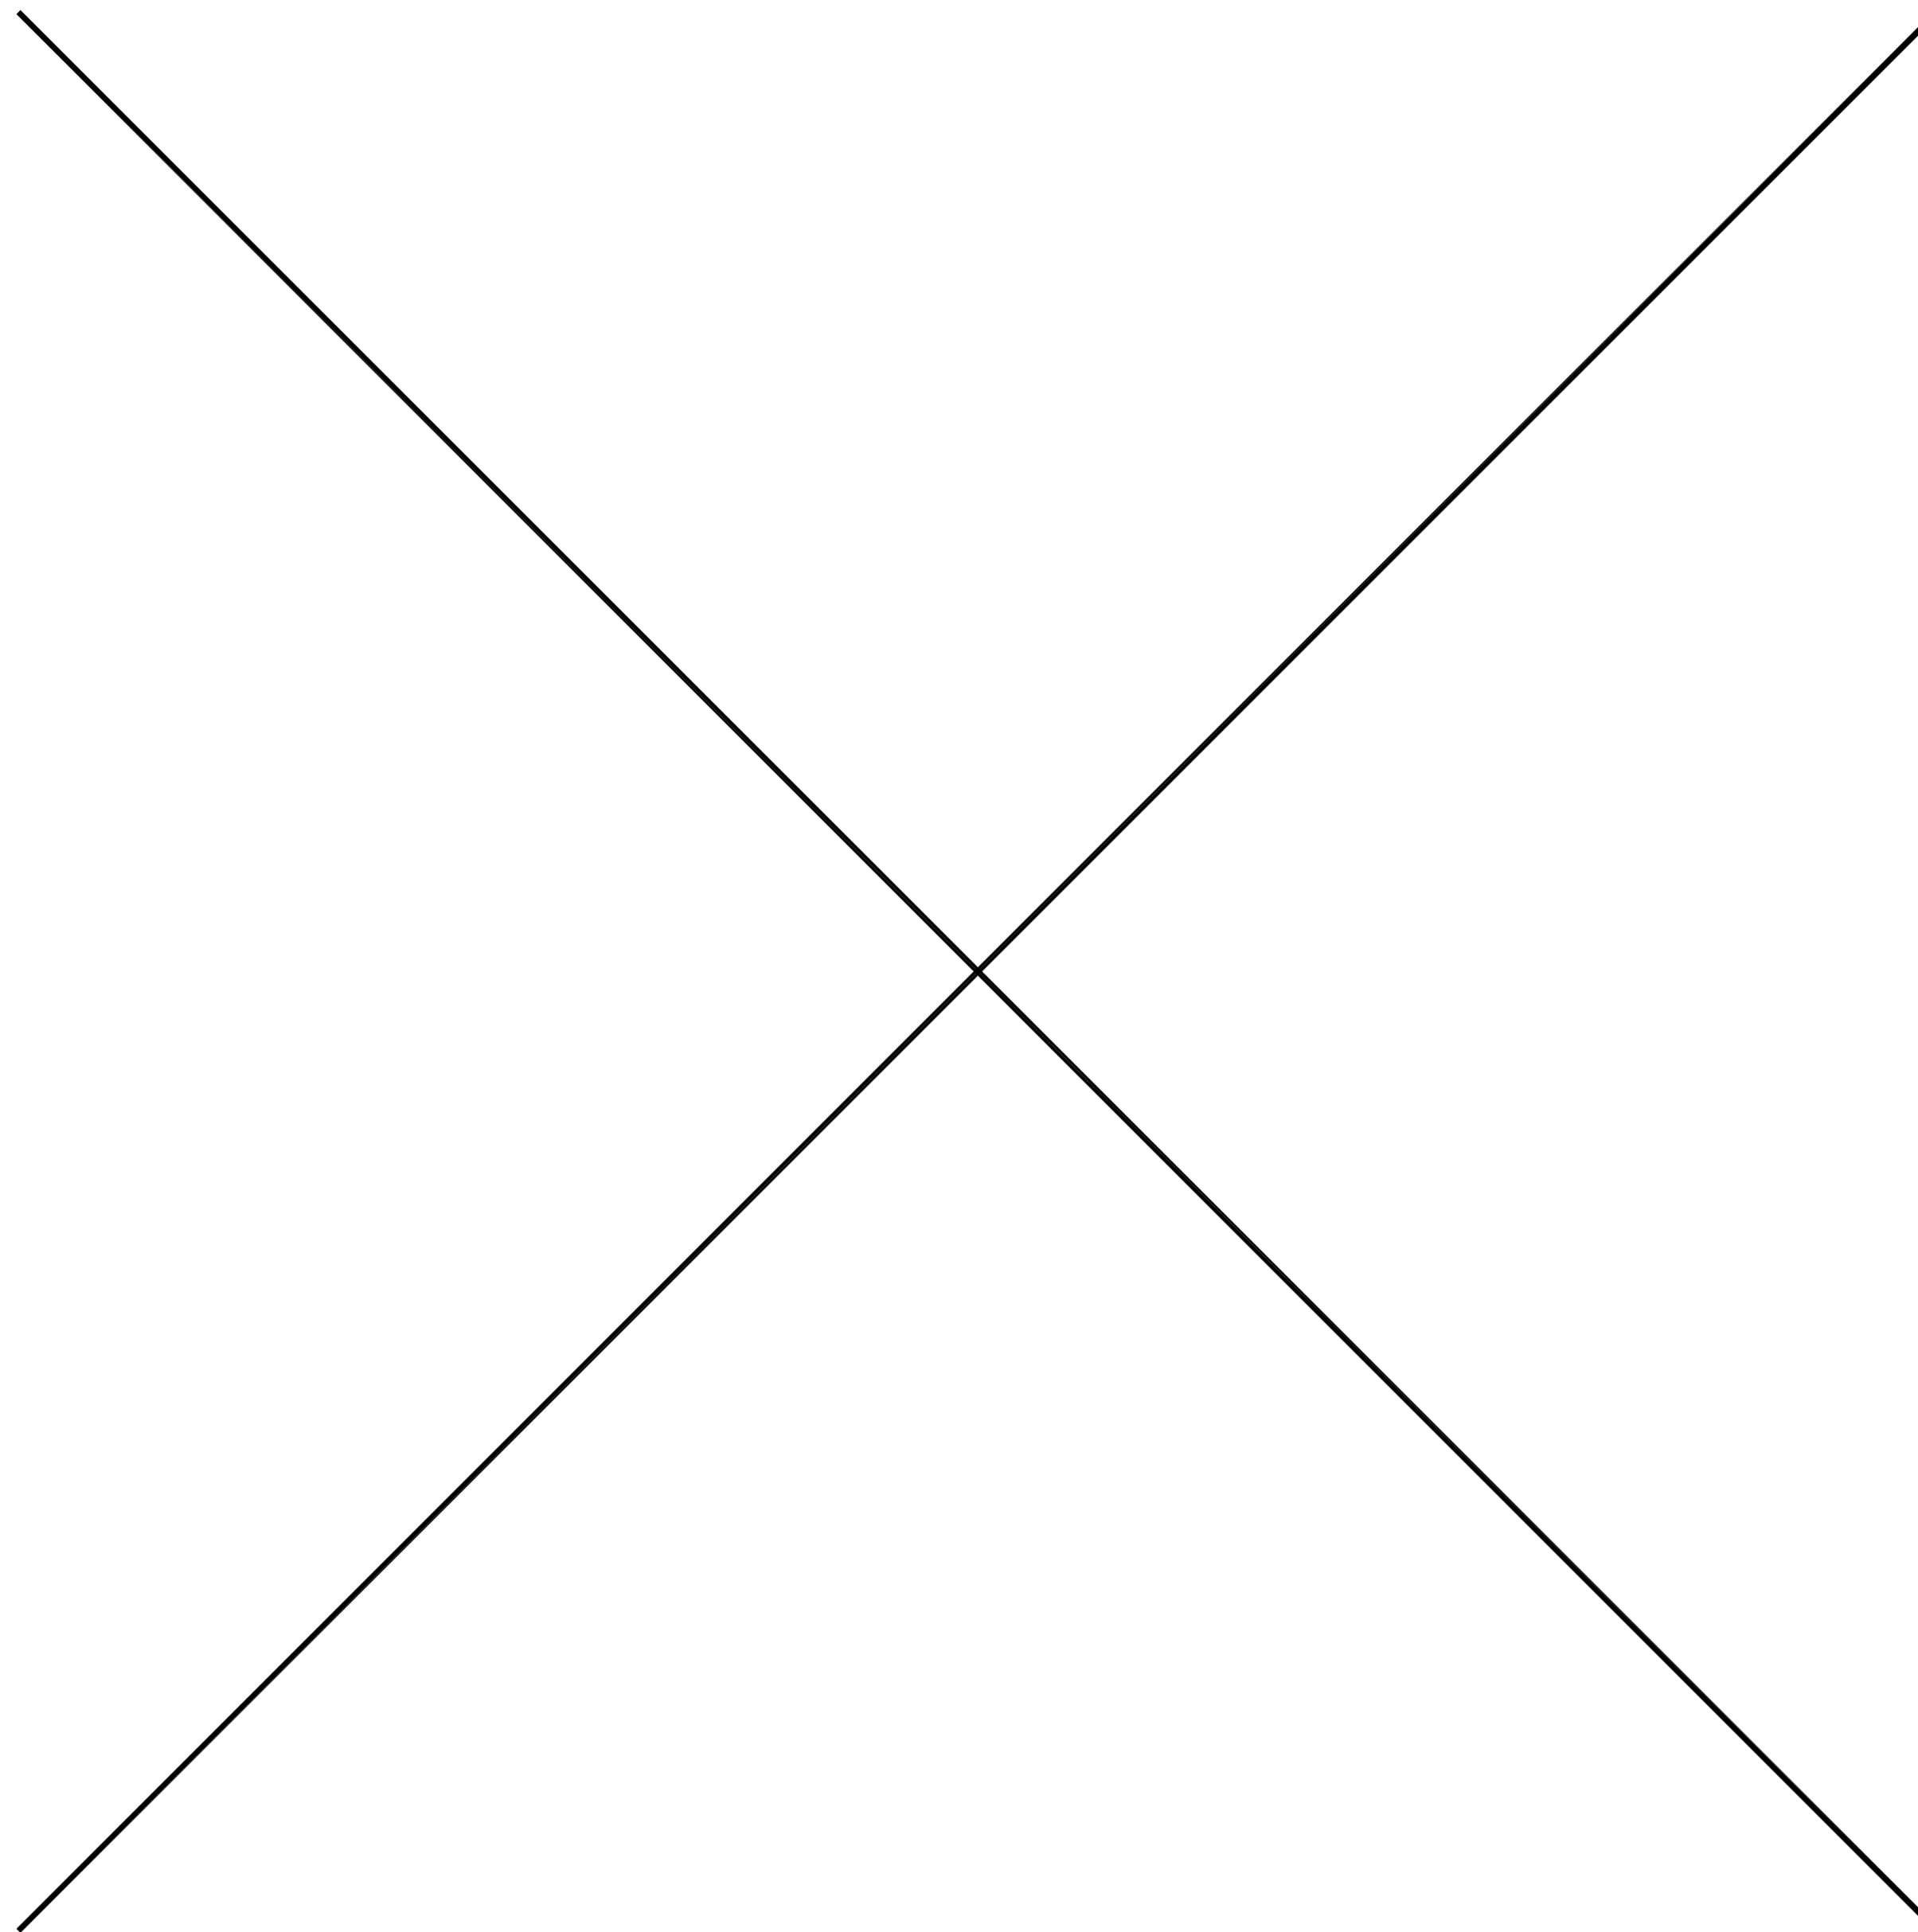

WORK REMOVED FROM OVERALL PROJECT



150 mm W.M.	WATER MAIN	150 mm W.M.	HYDRO M.T.S.	150 mm W.M.	WATER MAIN	150 mm W.M.	UNDERGROUND STRUCTURES SUPV. U/G STRUCTURES COMMITTEE DATE _____ NOTE: LOCATION OF UNDERGROUND STRUCTURES AS SHOWN ARE BASED ON THE BEST INFORMATION AVAILABLE. BUT NO GUARANTEE IS GIVEN THAT ALL EXISTING UTILITIES ARE SHOWN OR THAT THE GIVEN LOCATIONS ARE EXACT. CONFIRMATION OF EXISTENCE AND EXACT LOCATION OF ALL SERVICES MUST BE OBTAINED FROM THE INDIVIDUAL UTILITIES BEFORE PROCEEDING WITH CONSTRUCTION.	B.M. ELEV. 63-026 232.364	DESIGNED BY R.T.P.		ENGINEER'S SEAL	 THE CITY OF WINNIPEG TRANSIT DEPARTMENT	ON STREET TRANSIT PRIORITY IMPROVEMENTS - PHASE 1	CITY DRAWING NUMBER
300 mm L.D.S.	LAND DRAINAGE SEWER	300 mm L.D.S.	CONCRETE	300 mm L.D.S.	LAND DRAINAGE SEWER	300 mm L.D.S.		DRAWN BY P.M.W./A.J.P. CHECKED BY D.B.W. APPROVED BY _____ HOR. SCALE 1:250 VERTICAL 1:10	RELEASED FOR CONSTRUCTION DATE _____		SHEET 7 OF 14			
250 mm W.W.S.	WASTE WATER SEWER	250 mm W.W.S.	ASPHALT	250 mm W.W.S.	WASTE WATER SEWER	250 mm W.W.S.	NO. REVISIONS 2 ISSUED FOR REVIEW 06-28-07 D.B.W. 1 ISSUED FOR REVIEW 06-20-07 D.B.W.	DATE BY DATE JUNE 15 / 2007	CONSULTANT PROJECT NO. 07-7840	ST MARY'S CORRIDOR ST MARY'S RD @ BISHOP GRANDIN BLVD				
	MANHOLE		PLANING		WASTE WATER SEWER									
	CATCH BASIN		PAVING STONES		WASTE WATER SEWER									
	CURB INLET		SIDEWALK		WASTE WATER SEWER									
	JUNCTIONS		PARTIAL DEPTH REPAIR		WASTE WATER SEWER									
	CULVERT		PROPERTY LINE		WASTE WATER SEWER									
	GAS		SURVEY BAR		WASTE WATER SEWER									
EXISTING	LEGEND-PLAN	PROPOSED	PARAPLEGIC RAMP	EXISTING	LEGEND-PROFILE	PROPOSED								