


FILE NAME: F953-001-01_01-M-2002_RK.dwg
 DATE: 2007.02.21
 DESCRIPTION: Main Floor New Construction
 PROJECT No: F953-001-01
 ADDRESS: 999 Sargent St. Winnipeg, Manitoba
 PLOT: 07/08/22 2:37:59 PM

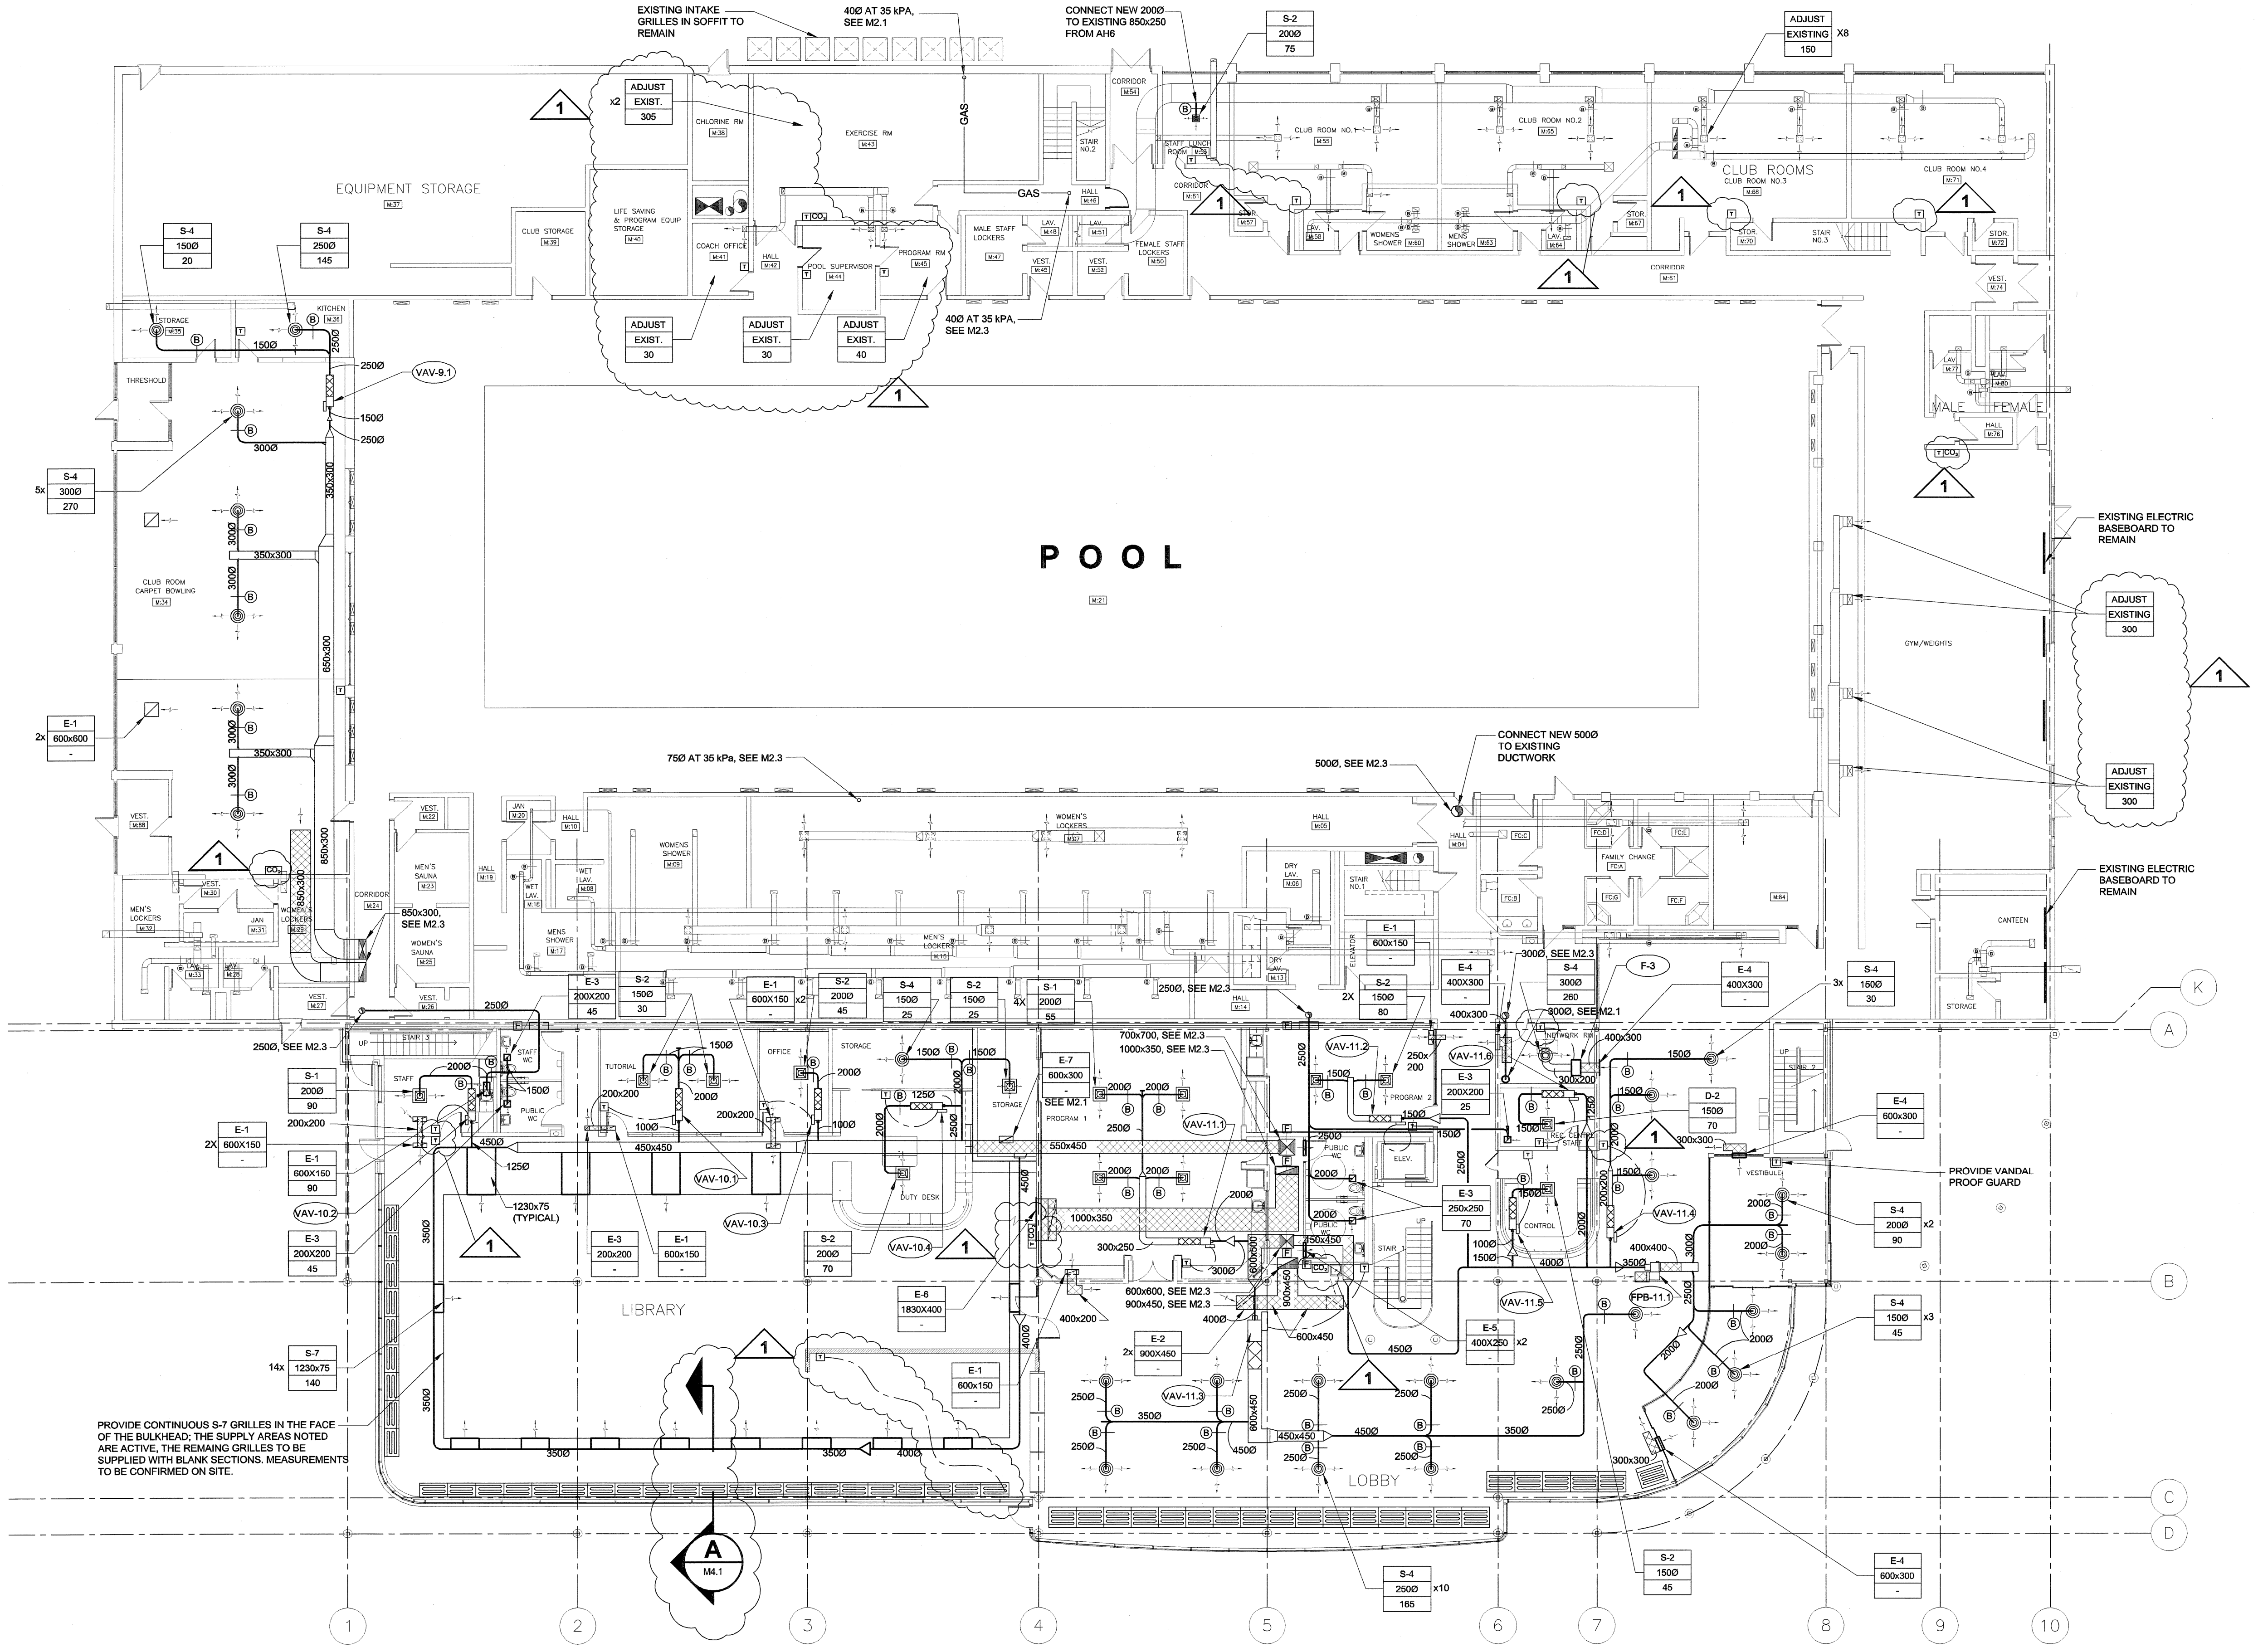

PROVIDE CONTINUOUS S-7 GRILLES IN THE FACE OF THE BULKHEAD; THE SUPPLY AREAS NOTED ARE ACTIVE, THE REMAINING GRILLES TO BE SUPPLIED WITH BLANK SECTIONS. MEASUREMENTS TO BE CONFIRMED ON SITE.

PLAN
 1
 M2.2
 0 1500 3000 4500 mm SCALE 1:150
 MAIN FLOOR HVAC NEW CONSTRUCTION

UMA | AECOM
 © 2007 UMA ENGINEERING LTD. ALL RIGHTS RESERVED.

APEGM
 Certificate of Authorization
 UMA Engineering Ltd. (MB)
 No. 256 Date: 07/08/22

DRN CHK DES/ENG IDR
 UMA | AECOM REVIEW

| NO. | REVISION/DESCRIPTION | BY | DATE |
|-----|------------------------|-----|----------|
| 1 | ISSUED FOR ADDENDUM #2 | RJP | 07/08/21 |
| 0 | ISSUED FOR TENDER | RJP | 07/07/23 |

DRAWN BY: RJP
 CHECKED BY: USER APPROVAL
 DATE: 2007.07.17

CITY OF WINNIPEG
 PLANNING, PROPERTY & DEVELOPMENT DEPARTMENT
 CIVIC ACCOMMODATIONS DIVISION
 300 - 65 GARRY ST. R3C 4K4

PROJECT
Construction of Cindy Klassen Recreation Complex Facility Enhancement Project
 999 Sargent St. Winnipeg, Manitoba

SHEET TITLE
**Mechanical
 Main Floor HVAC
 New Construction**

SCALE: 1:150
 PROJECT NO.: 2005-059
 SHEET NO.: **M2.2**

DRAWING SHEET SIZE: A1 (841mm x 594mm) PLOT 1:1

