



PLAN

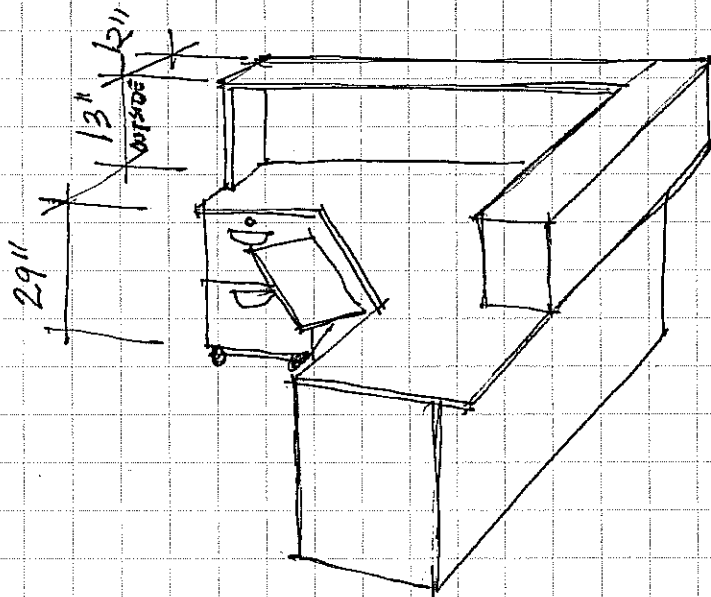

CORNISH LIBRARY
20 WEST GATE

REFERENCE DESK

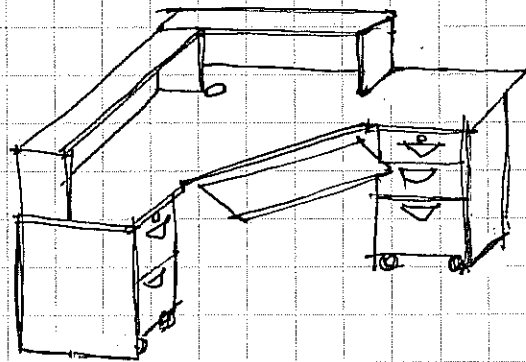

- LAMINATE COLOURS TO FOLLOW
- KEYBOARD TRAY / DRAWER
- LOCKABLE PEDS. KEYPED ASUKE (2) (MOBILE)
- GROMMET
- 6" O/A ON "FRONT" ASU
- DESK TOPPERS 12" DEEP, 13" CLEAR UNDER. NOTE: "FRONT" TOPPER NOT FULL LENGTH

DRAWING A5 R1
SBDH AUG'07