SHEET: TBLOCK-COW-A1 (03/2005)

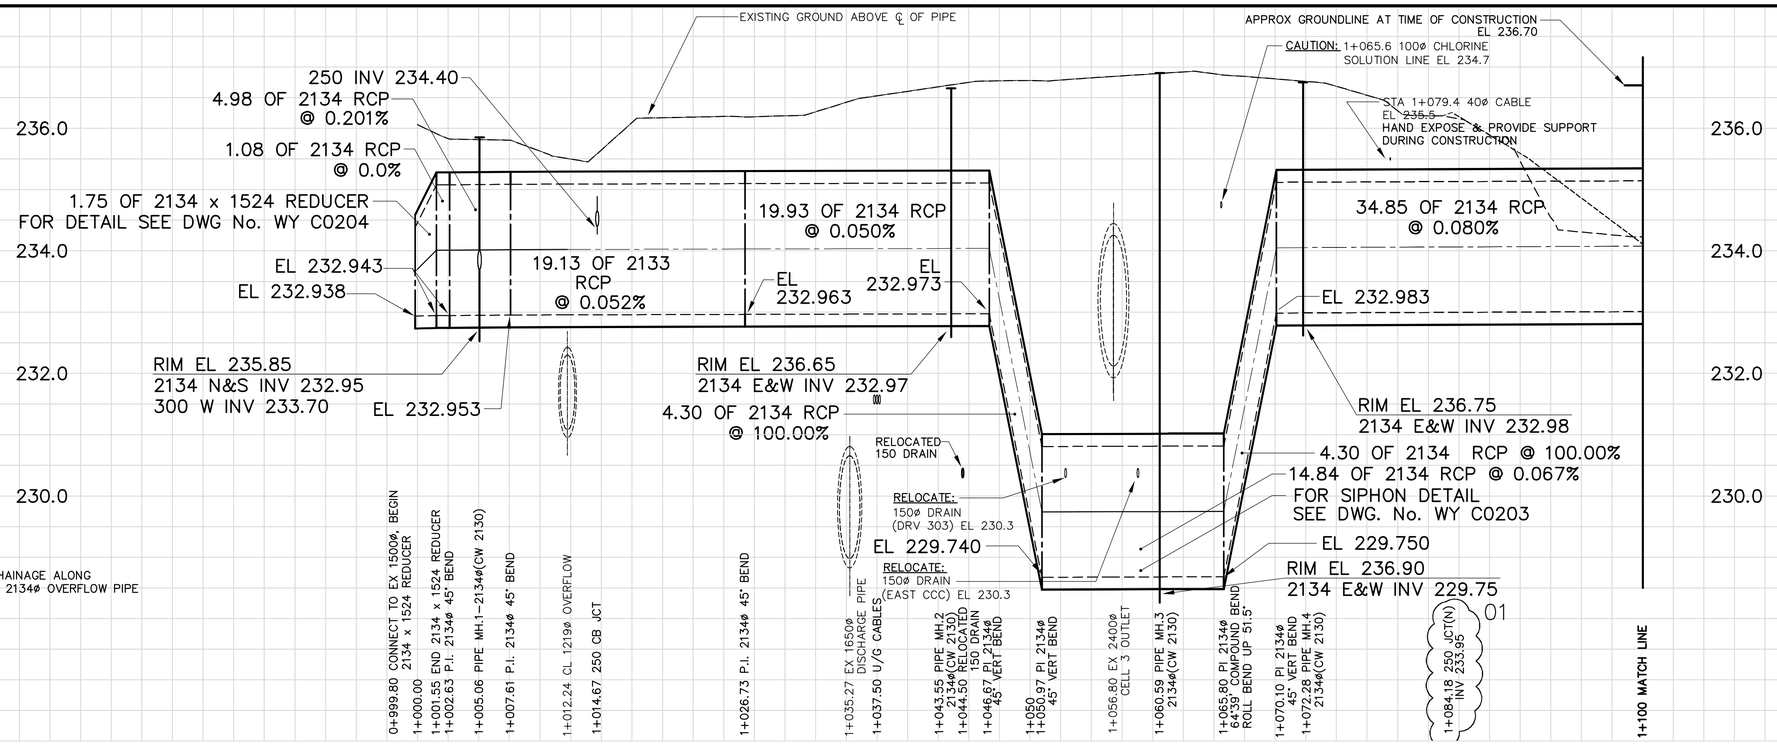

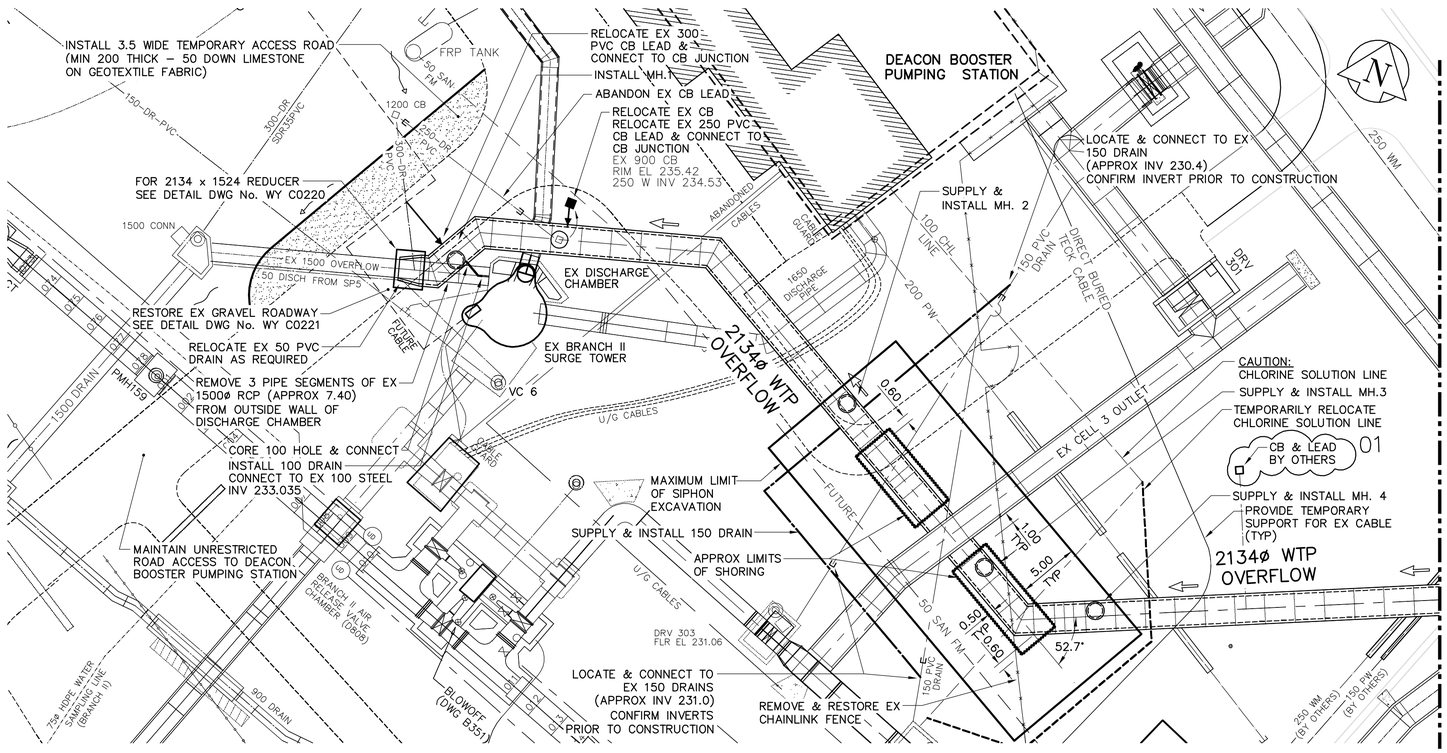

0 10m 20m
SCALE

B.M. ELEV.			
01	681–2007 ADDENDUM 2	07/11/12	WJd
00	681–2007 ISSUED FOR TENDER	07/09/27	WJd
NO.	REVISIONS	DATE	BY

UMA | AECOM

© 2005 UMA ENGINEERING LTD. ALL RIGHTS RESERVED.

DESIGNED BY EDT	CHECKED BY MGM
DRAWN BY WJd	APPROVED BY CCM
HOR. SCALE: 1:250 VERTICAL SCALE: 1:50	RELEASED FOR CONSTRUCTION BY: Ron Sorokowski
DATE 2007/09/27	DATE October 1, 2007

ENGINEER'S SEAL

ORIGINAL SIGNED BY:
E. D. J. TOUPIN
MEMBER 23484
2007/10/01

CONSULTANT DRAWING NO.
WY C0217

Certificate of Authorization
UMA Engineering Ltd. (MB)
No. 256 Date: Nov 14, 2007

Winnipeg

THE CITY OF WINNIPEG
WATER AND WASTE DEPARTMENT
ENGINEERING DIVISION

WINNIPEG WATER TREATMENT PROGRAM
CONSTRUCTION OF WATER TREATMENT PLANT OVERFLOW

CITY FILE NUMBER

SHEET 1 OF 1

CIVIL
W.T.P. OVERFLOW PIPING – PLAN & PROFILE
EXISTING 1500ø OVERFLOW CONN TO MATCH LINE 1+100.00

CITY DRAWING NUMBER
1-0601Y-C-C0217-001-01D

UMA REVIEW | DRFT CHK