


SECTION "A-A"
N.T.S.

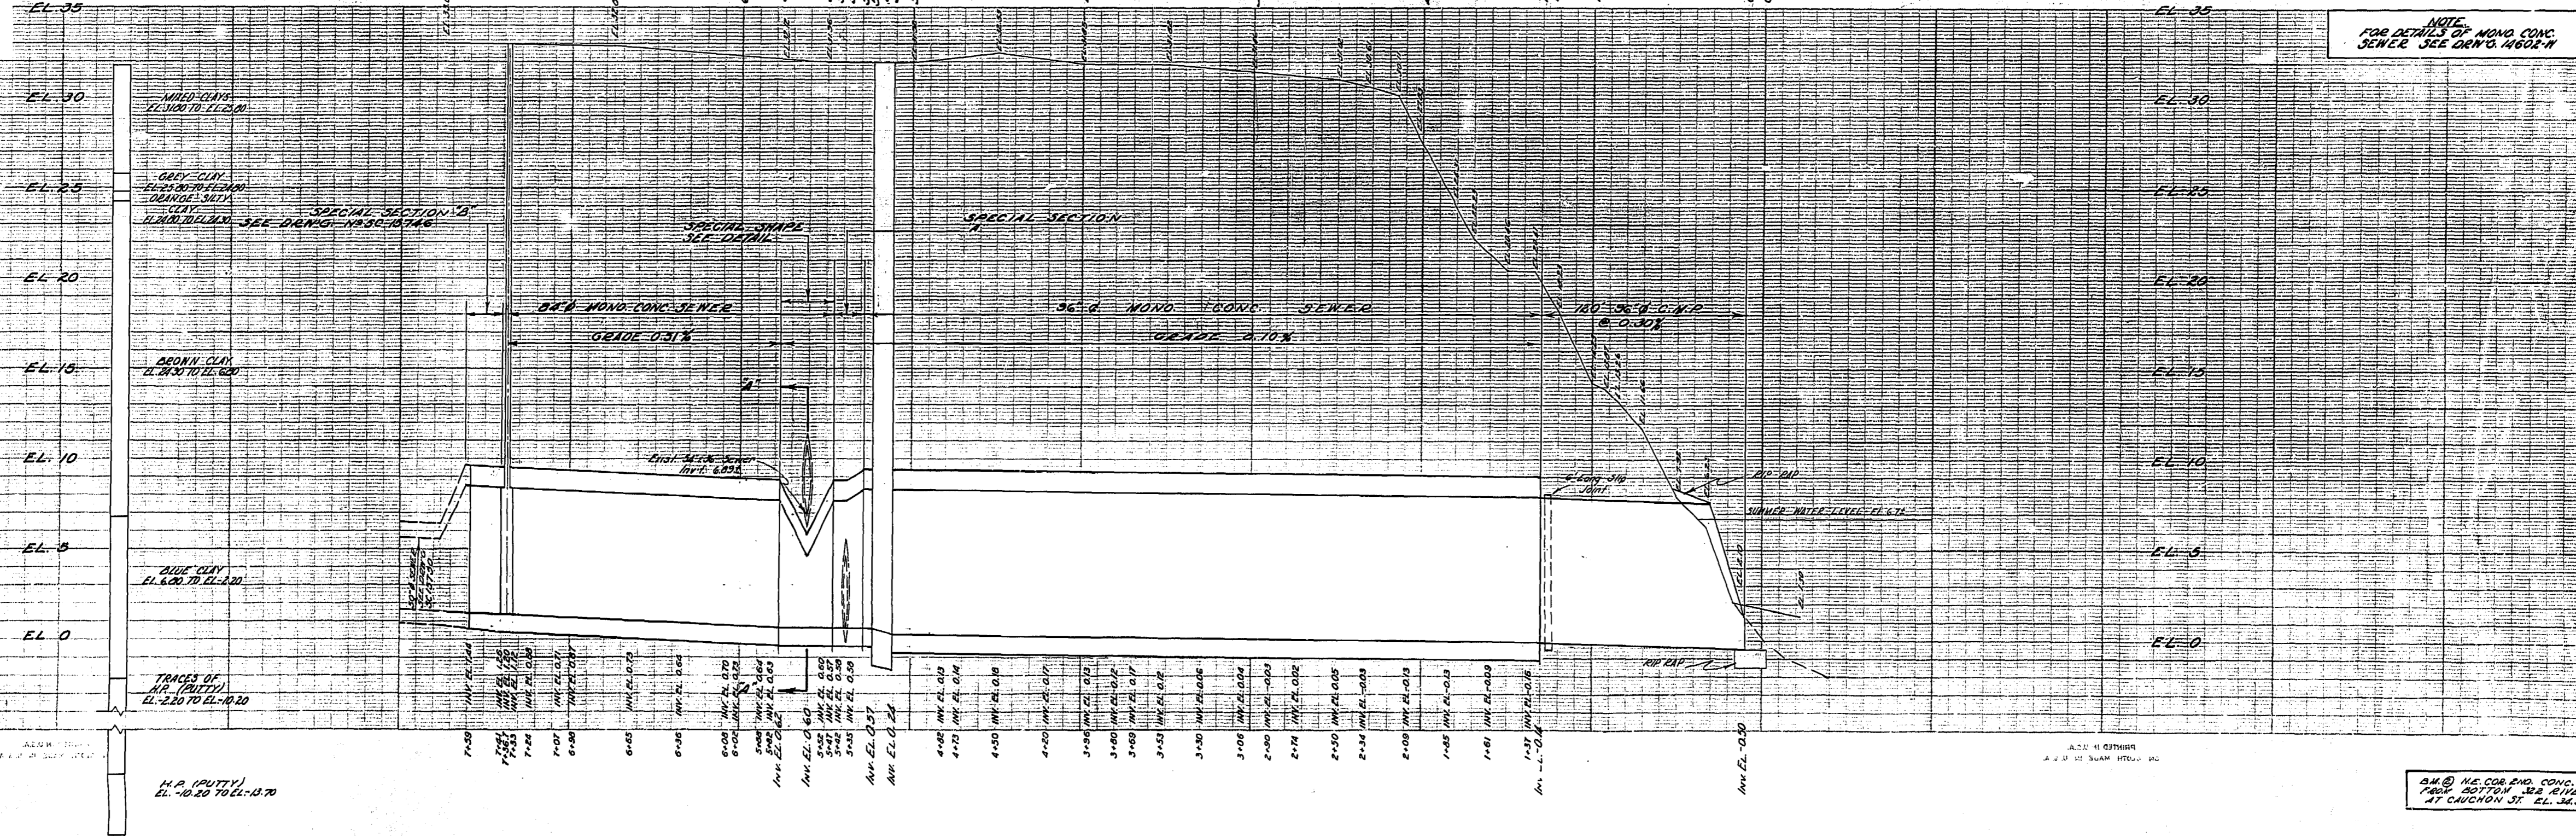

REVISED AS
CONSTRUCTED
BY A DATE 17 OCT 66
CHECKED BY: DATE:

NOTE:
FOR DETAILS OF MONO CONC.
SEWER SEE DRAWING 14602-N


METRO APPROVAL REC'D.
SEWAGE DISPOSAL BRANCH NO. 20/160 DATE: 10 MAY 66

THE CONTRACTOR'S ATTENTION IS HEREBY DRAWN TO CLAUSE 3.11.2 OF THE GENERAL CONDITIONS REGARDING THE CITY'S RESPONSIBILITIES USOPAR AS THE TEST HOLE DATA IS CONCERNED.

LOCATION OF UNDERGROUND STRUCTURES SHOWN ARE BASED ON BEST INFORMATION AVAILABLE. BUT NO GUARANTEE IS GIVEN THAT ALL EXISTING UTILITIES ARE SHOWN AND EXACT LOCATIONS OF ALL UNDERGROUND INCLUDING SERVICE CONNECTIONS, MUST BE CHECKED WITH THE UTILITY CONCERNED BEFORE PROCEEDING WITH CONSTRUCTION.

LOCATION APPROVED
UNDERGROUND STRUCTURES COMMITTEE
2-11-66. *[Signature]*
DATE

METRO APPROVAL REC'D.
WATERWORKS AND WASTE DISPOSAL NO. 20 MAY 66
DRYING COMMISSIONER BY A DATE 26 APR 66

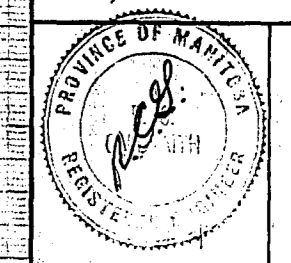

CITY OF WINNIPEG
ENGINEERING DEPARTMENT
W. D. HURST - CITY ENGINEER
J. B. STRIGOSKI - DEPUTY CITY ENGINEER

- 1) 36" STORM RELIEF SEWER GATE CHAMBER AND OUTFALL IN FORT ROUGE PARK FROM ASSINIBOINE RIVER TO RIVER AVENUE
- 2) 36" STORM RELIEF SEWER IN RIVER AVENUE FROM FORT ROUGE PARK TO SCOTT STREET

DRAWN BY: R.D. DATE: MARCH, 1966
CHECKED BY: *[Signature]* DATE:
APPROVED BY: *[Signature]* DATE: 12-16-66

REFERENCES:
B.M. 145 COR. END CONC. STEP FROM SCOTT ST. RIVER AV. AT CAUCHON ST. EL. 34.33
SCALE: PLAN 1"=40' PROFILE 1"=20'
DRAWING NO. SC 15745