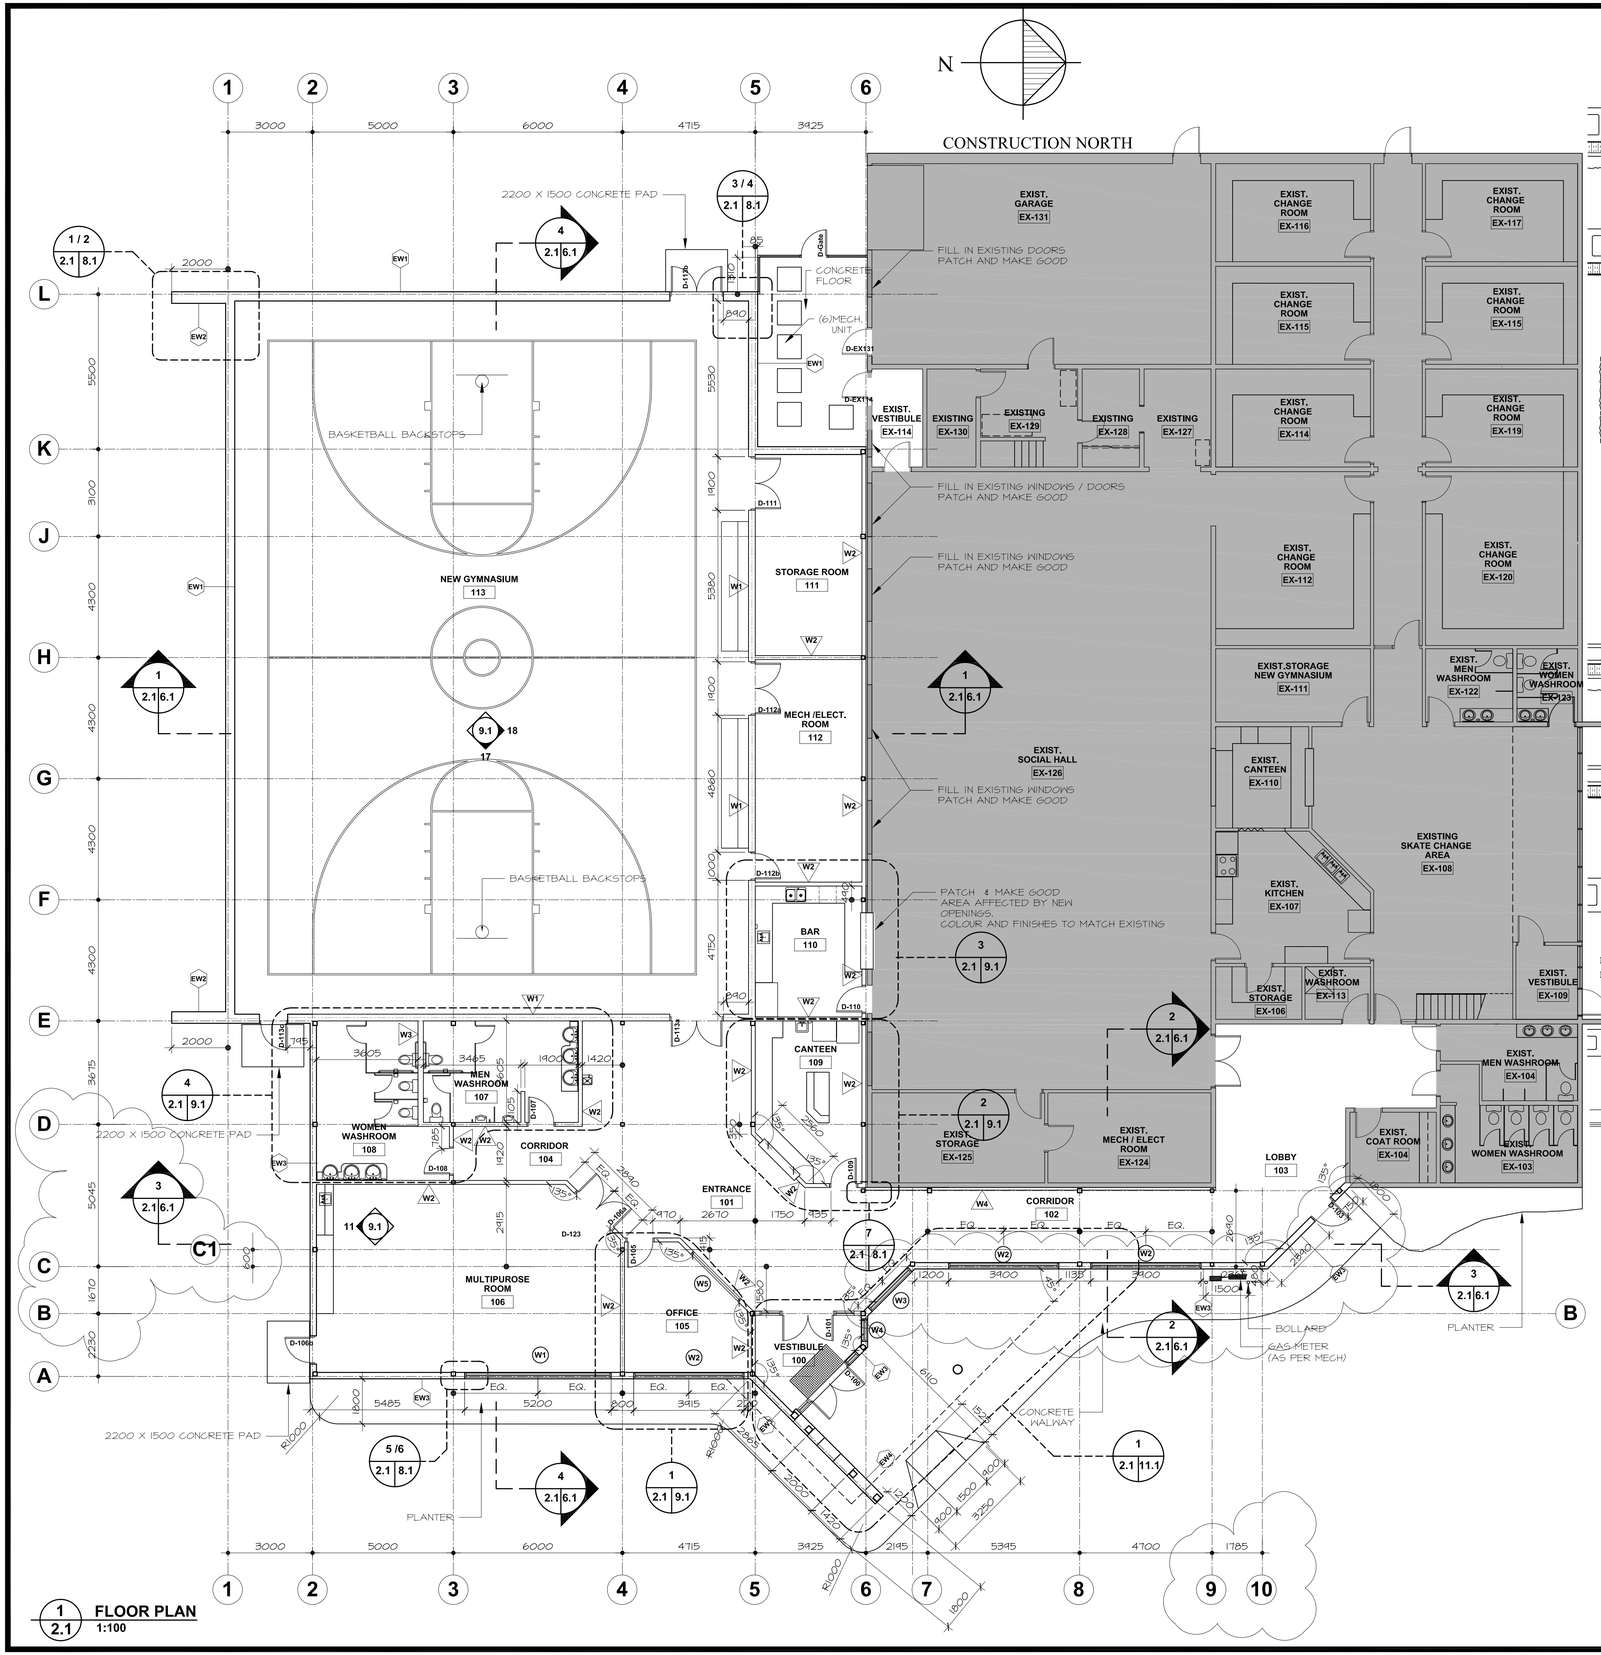

1 / 2.1 — **FLOOR PLAN** 1:100

WALL TYPES

EXTERIOR WALL

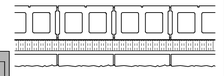

EW1a UP TO 1600mm

FINISH AS PER SCHEDULE
250 CONCRETE BLOCK -SINGLE SCORE
AIR / VAPOUR BARRIER
75 RIGID INSUL. TYPE 4 (R.S.I. 3.52)
90 SPLIT FACE CONCRETE BLOCK

EW1b BALANCE OF WALL

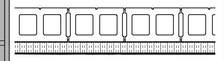

FINISH AS PER SCHEDULE
250 CONCRETE BLOCK -SINGLE SCORE
(PLAIN BLOCK BEHIND TECTUM PANELS)
AIR / VAPOUR BARRIER
75 RIGID INSUL. TYPE 4 (R.S.I. 3.52)
ACRYLIC STUCCO SYSTEM

EW2a UP TO 1600mm

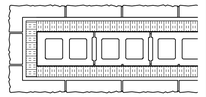

90 SPLIT FACE CONCRETE BLOCK
75 RIGID INSUL. TYPE 4 (R.S.I. 3.52)
AIR / VAPOUR BARRIER
250 CONCRETE BLOCK -SINGLE SCORE
AIR / VAPOUR BARRIER
75 RIGID INSUL. TYPE 4 (R.S.I. 3.52)
90 SPLIT FACE CONCRETE BLOCK

EW2b BALANCE OF WALL

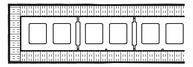

ACRYLIC STUCCO SYSTEM
75 RIGID INSUL. TYPE 4 (R.S.I. 3.52)
AIR / VAPOUR BARRIER
250 CONCRETE BLOCK -SINGLE SCORE
AIR / VAPOUR BARRIER
75 RIGID INSUL. TYPE 4 (R.S.I. 3.52)
ACRYLIC STUCCO SYSTEM

EW3a UP TO 1600mm

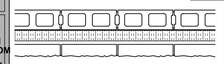

FINISH AS PER SCHEDULE
200 CONCRETE BLOCK
AIR / VAPOUR BARRIER
75 RIGID INSUL. TYPE 4 (R.S.I. 3.52)
90 SPLIT FACE CONCRETE BLOCK

EW3a BALANCE OF WALL

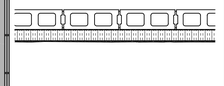

FINISH AS PER SCHEDULE
200 CONCRETE BLOCK
AIR / VAPOUR BARRIER
75 RIGID INSUL. TYPE 4 (R.S.I. 3.52)
ACRYLIC STUCCO SYSTEM

INTERIOR WALL

W1 INTERIOR WALL

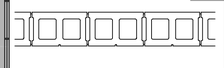

FINISH AS PER SCHEDULE
250 CONCRETE BLOCK -SINGLE SCORE

W2

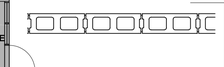

FINISH AS PER SCHEDULE
150 CONCRETE BLOCK

W3

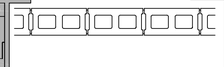

FINISH AS PER SCHEDULE
200 CONCRETE BLOCK

W4

FINISH AS PER SCHEDULE
13 MDF BOARD
13 G.W.B.
92 STEEL STUD 450mm O/C

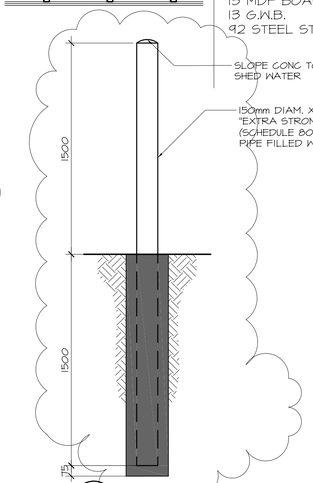

2 / 2.1 2.1 — **EXTERIOR BOLLARD - TYP** 1:20

NOT TO BE USED FOR CONSTRUCTION (Remove when is final)

NO.	REVISION	DATE	BY
2	ADDENDUM 1	18/04/2008	JS
1	ISSUED FOR TENDER	25/03/2008	JS
0	99% ISSUED FOR REVIEW	12/03/2008	JS

THIS DRAWING IS THE EXCLUSIVE PROPERTY OF THE ARCHITECT AND CAN BE REPRODUCED ONLY WITH THE PERMISSION OF THE ARCHITECT IN WHICH CASE THE REPRODUCTION MUST BEAR THE NAME OF THE ARCHITECT.

THIS DRAWING SHALL NOT BE SCALED. FOLLOW GIVEN DIMENSIONS ONLY.

THE CONTRACTOR SHALL SATISFY HIMSELF THAT ALL DIMENSIONS AND INFORMATION SHOWN ARE CORRECT.

PRIOR TO COMMENCEMENT OF WORK REPORT ANY DISCREPANCIES TO THE ARCHITECT.

VARIATIONS AND MODIFICATIONS TO WORK SHOWN WILL NOT BE ALLOWED WITHOUT WRITTEN PERMISSION OF THE ARCHITECT.

CONSULTANT

SEAL

PROVINCE OF MANITOBA — ED CALNITSKY — 8033 — REGISTERED ARCHITECT

CALNITSKY ASSOCIATES ARCHITECTS

ARCHITECTURE
124 Nassau Street North
Tel: (204) 453-6441

INTERIOR DESIGN
Winnipeg, Manitoba R3L 2H1
Fax: (204) 453-3392
E-mail: caa@escape.ca

PROJECT TITLE

NORBERRY GLENLEE COMMUNITY CENTRE EXPANSION

26 Molgat Avenue, Winnipeg, MB
Bid Opportunity No. 931-2007

SHEET TITLE

FLOOR PLAN

DRAWN BY	SCALE	SHEET NUMBER
JS	AS NOTED	A-2.1
CHECKED BY	DATE	
JS	31/01/2008	
PROJECT NUMBER	REVISION	
06-017	0	