

1 PARTIAL PLAN - ADMINISTRATION (THIRD FLOOR LEVEL)
WB-B0139 1:100

2 PARTIAL PLAN - ROOF (THIRD FLOOR LEVEL)
WB-B0139 1:100

3 PARTIAL PLAN - STAIRWELL No.2 @ EL. 251.450
WB-B0139 1:100



NOTES: 1. ALL INTERIOR CMU PARTITION WALLS IN THE ADMIN AREA (LEVEL 245.00) WILL BE UP TO 3000mm AFF.
2. DUCT SHAFT CMU WALLS TO BE UP TO U/S OF CONCRETE SLAB.

WALL TYPES:

- W1 EXISTING CAST-IN-PLACE CONCRETE TYPICAL UNLESS NOTED
- W2 CMU 290mm
- W3 CMU 240mm
- W4 CMU 190mm
- W5 CMU 140mm
- W6 CMU 90mm
- W6B1 CMU 90mm BURNISHED
- W6B2 CMU 90mm BURNISHED (DUAL WHYTHE - BACK TO BACK)
- W7 FROM FIN FLOOR TO 1200mm AFF: CMU 90mm BURNISHED 13mm GYP BD - PT 13mm FURRING BAR @ 400mm O/C FROM 1200mm AFFL TO U/S OF SLAB: USE WALL TYPE 8
- W8 13mm GYP BD - PT 92mm STEEL STUDS @ 400mm O/C 13mm GYP BD - PT ACOUSTICAL BATT INSULATION ACOUSTICAL CAULK ON TOP & BOT PLATE. UP TO U/S OF SLAB EXCEPT IN ROOM 341 (KITCHEN)
- W2B CMU 290mm BURNISHED
- W3A CMU AIR SPACE (VARIES) 92mm METAL STUDS 13mm GYP BD - PT
- W4B CMU 190mm BURNISHED
- W4B1 FROM FIN FLOOR TO 3000mm AFF: CMU 190mm BURNISHED FROM 3000mm AFFL TO U/S OF SLAB: USE WALL TYPE 8
- W5B1 FROM FIN FLOOR TO 3000mm AFF: CMU 140mm BURNISHED FROM 3000mm AFFL TO U/S OF SLAB: USE WALL TYPE 8
- W5B2 CMU 140mm BURNISHED
- W6B CMU 90mm BURNISHED

FIRE RATINGS:

- 2 HR FIRE RATING
- 1 HR FIRE RATING

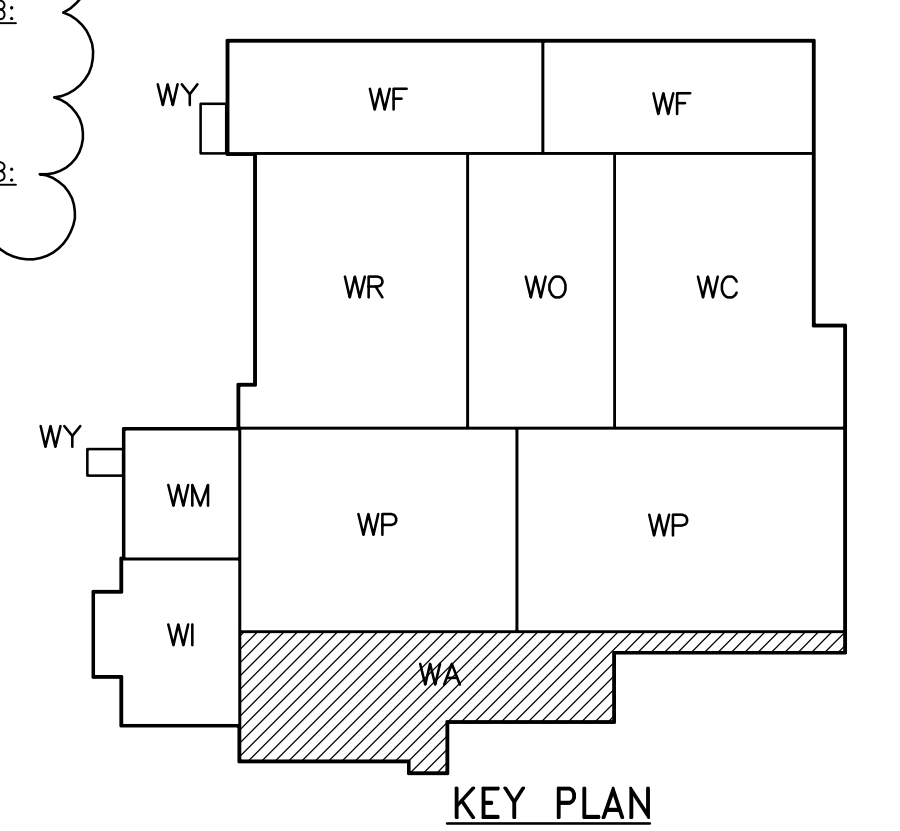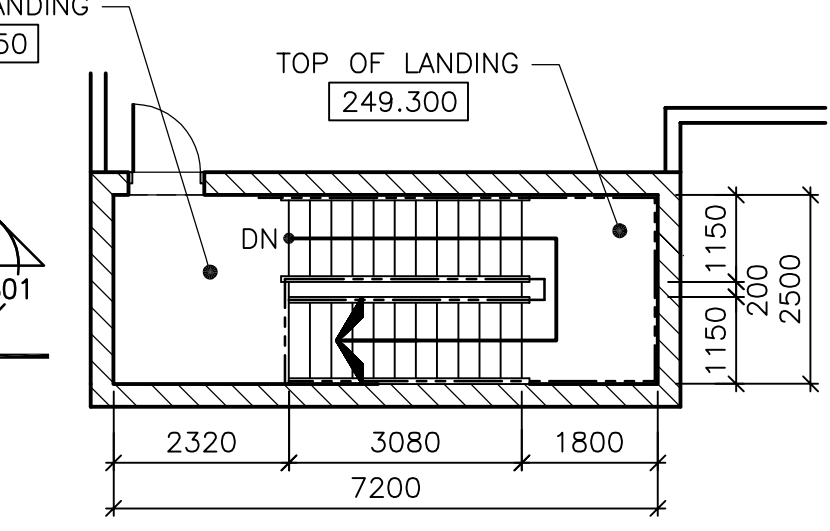

SCALE 1:100 METRES 0 2 4 6 8 10
SCALE 1:1 MILLIMETRES 0 20 40 60 80 100



B.M. ELEV.			
DESIGNED BY	TWS	CHECKED BY	BJS
DRAWN BY	AL/LK	APPROVED BY	AHL
SCALE:	1:100	RELEASED FOR CONSTRUCTION BY:	R. SOROKOWSKI
NO. REVISIONS	DATE	DATE	DATE
01	95-2007 ADDENDUM 02	07/06/XX	LK
00	ISSUED FOR TENDER	07/06/05	LK
		2005/08/03	

DESIGNED BY	TWS
CHECKED BY	BJS
DRAWN BY	AL/LK
APPROVED BY	AHL
RELEASED FOR CONSTRUCTION BY:	R. SOROKOWSKI
DATE	2005/08/03
DATE	2007/06/05

ENGINEER'S SEAL	
ORIGINAL SIGNED BY	NEIL COOPER
	2007/06/05
CONSULTANT DRAWING NO.	WB-B0139

THE CITY OF WINNIPEG
WATER AND WASTE DEPARTMENT
ENGINEERING DIVISION

WATER TREATMENT PLANT
MAIN BUILDING
OFFICE AND PLANT INTERIOR FINISHES

ARCHITECTURAL
PARTIAL PLAN OF ADMINISTRATION AND ROOF
(ELEV. 245.000)

CITY FILE NUMBER
SHEET OF
CITY DRAWING NUMBER
1-060B-A-B0139-001-01D