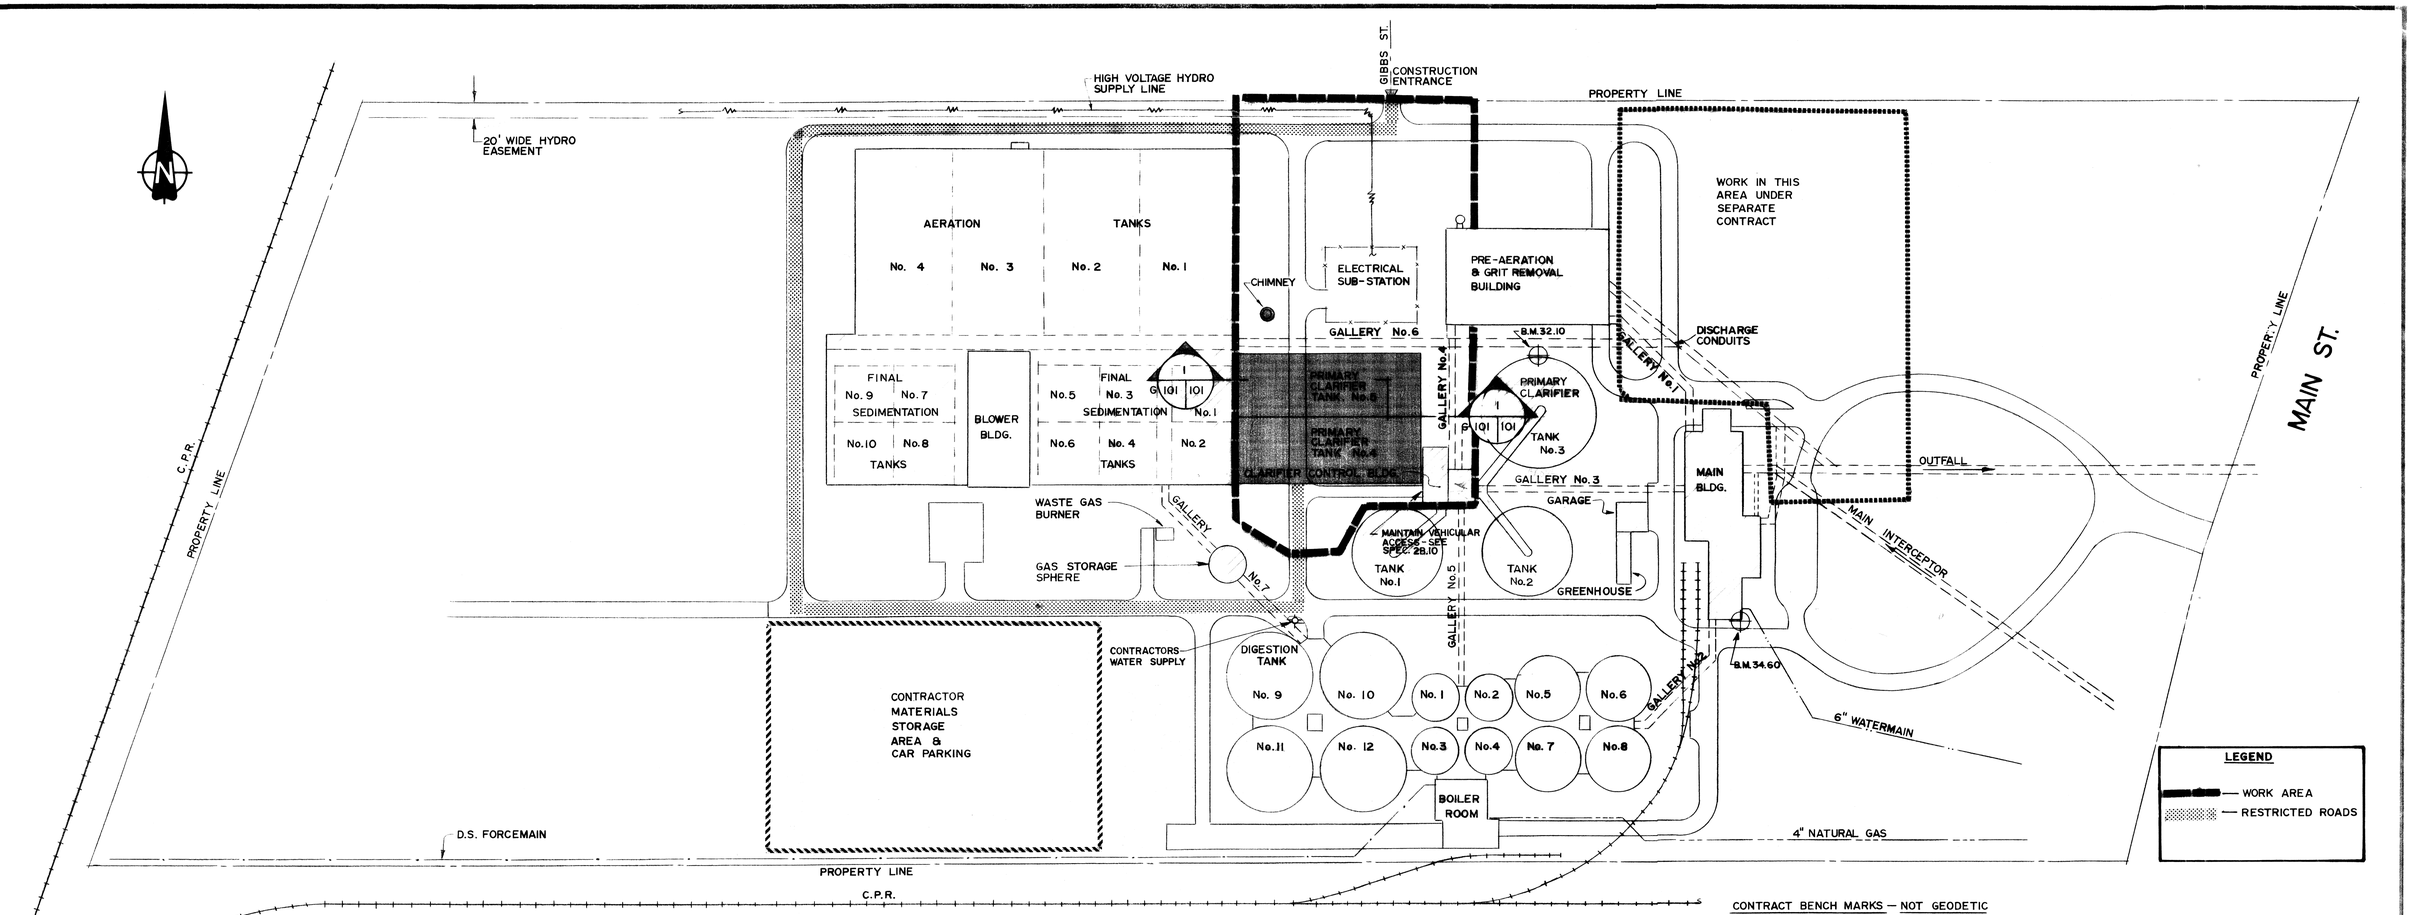

CONTRACT BENCH MARKS — NOT GEODETIC

BM_1 — AT S.E. CORNER OF MAIN BLDG. ——— ELEV. 34.60'

BM_2 — AT NORTH CENTRAL TANGENT POINT OF PRIMARY CLARIFIER TANK No. 3 ——— ELEV. 32.10'

SITE PLAN

SCALE: 1" = 100'

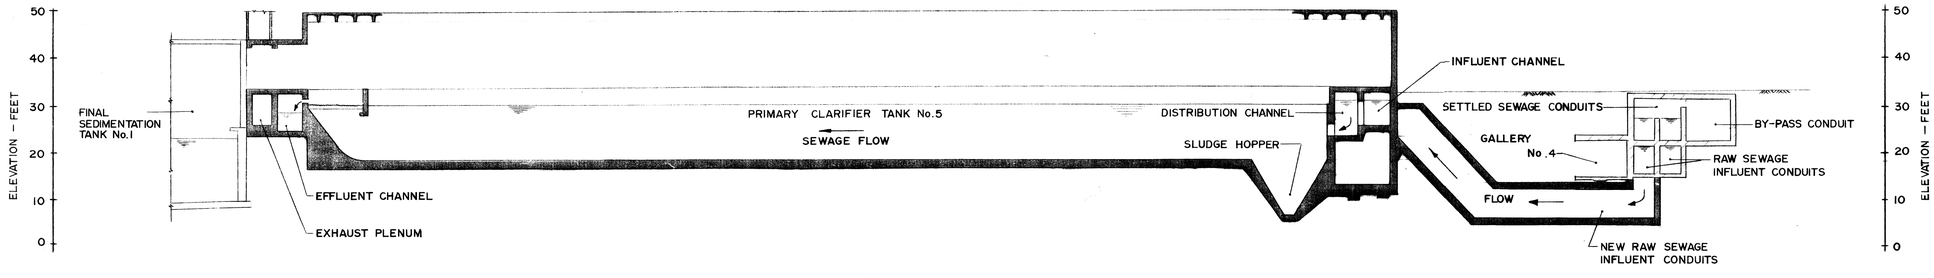

SECTION

SCALE: $\frac{1}{16}$" = 1'-0"

MICROFILMED MAR 31 1980

CONSULTANT	DIV. OF UTIL. ENG. OFFICE	CENTRAL FILE	ENGINEERING FILE	SHEET NO.	NO. OF SHEETS	SIZE	MEDIUM	SECUR.	FRAME NO.	NO. OF FRAMES	REV. NO.	DATE FILMED
		DRAWING FILE NUMBER										

GRID CO-ORDINATES

MICROFILMING WORKS & OPERATIONS DEPT.

PROVINCE OF MANITOBA — G. REMPEL — REGISTERED ENGINEER

REV.	DESCRIPTION	BY	DATE
	AS BUILT CJA		SEPT. 79
	ISSUED FOR TENDER		15/5/78

W. L. WARDROP & ASSOCIATES LTD.
JAMES F. MacLAREN LIMITED
ENGINEERING CONSULTANTS

DRAWN BY: | DESIGNED BY:
CHECKED BY: | APPROVED BY: | DATE:

THE CITY OF WINNIPEG
WORKS & OPERATIONS DEPARTMENT
WATERWORKS, WASTE & DISPOSAL DIVISION

NORTH END WATER POLLUTION CONTROL CENTRE
PRIMARY CLARIFIER ADDITION

SITE PLAN

SCALE: AS SHOWN
DATE: MAY 1978
CONSULTANT DRAWING NO. 76012·05·G101
CITY DRAWING NO. NEP-918

NR11093

FILE 10973-D-10277