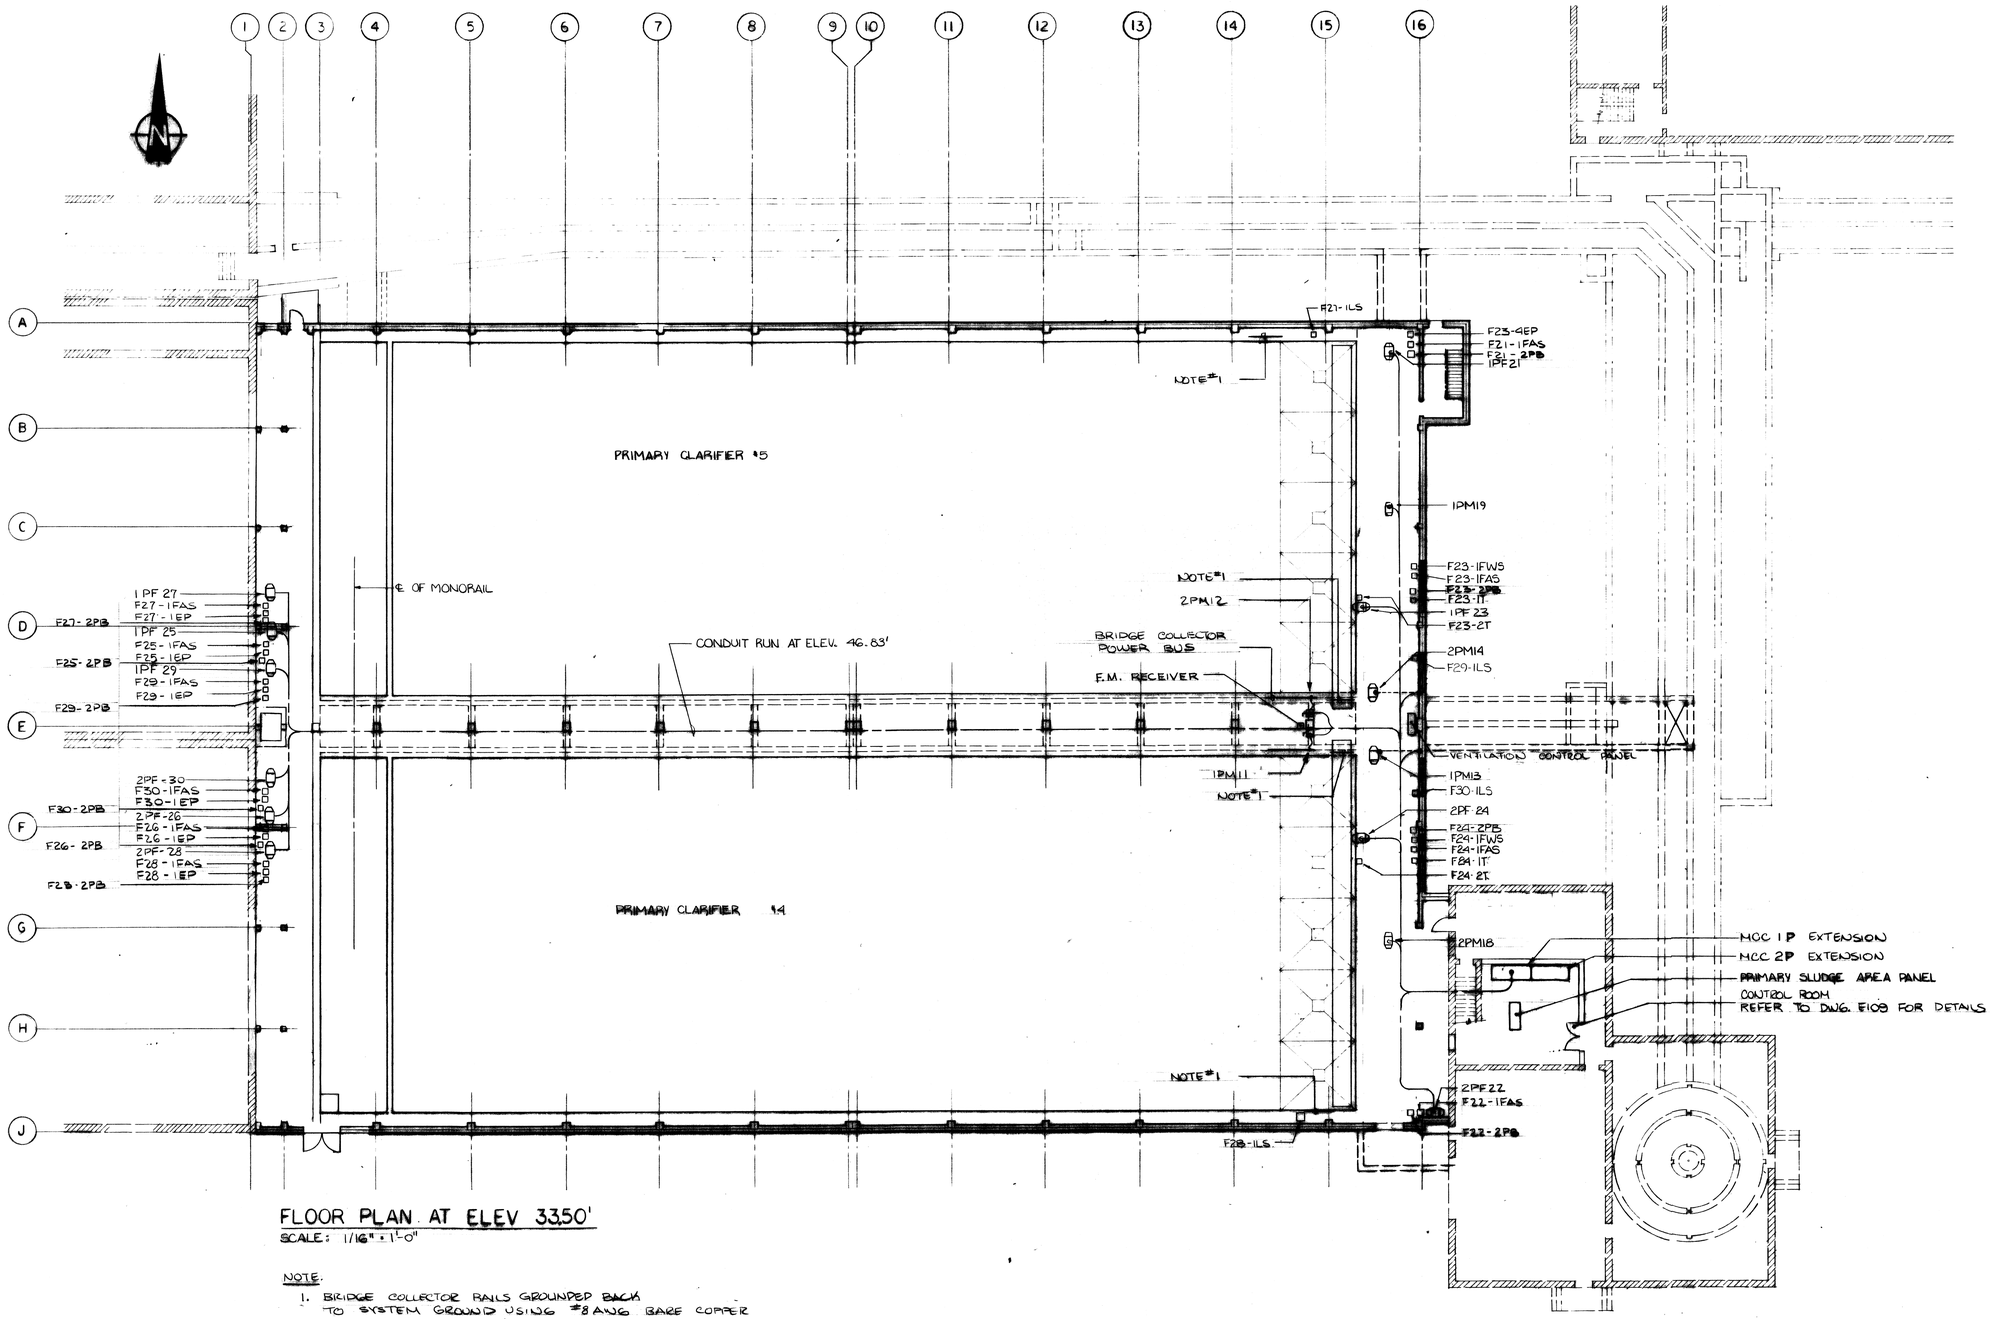

FLOOR PLAN AT ELEV 33.50'

SCALE: 1/16" = 1'-0"

NOTE.

1. BRIDGE COLLECTOR RAILS GROUNDED BACK TO SYSTEM GROUND USING #8 AWG BARE COPPER GROUND WIRE IN 1/2" CONDUIT.
2. ALL PILOT DEVICES WIRED BACK TO PRIMARY SLUDGE AREA PANEL.

MICROFILMED MAR 31 1980

REV.	DESCRIPTION	BY	DATE
	AS-BUILTS		SEPT. 79
0	ISSUED FOR TENDER	LF	MAY 15 78

PROVINCE OF MANITOBA — L. R. FERCHOFF — EXPIRES DEC 31/78 — REGISTERED ENGINEER

CENTRAL FILE	ENGINEERING FILE		DATE FILMED
DRAWING FILE	NUMBER		
GRID CO-ORDINATES			
MICROFILMING	WORKS & OPERATIONS DEPT.		

W. L. WARDROP & ASSOCIATES LTD.
JAMES F. MacLAREN LIMITED
ENGINEERING CONSULTANTS

DRAWN BY: KFML
DESIGNED BY: LF
CHECKED BY: DWR
APPROVED BY: DATE:

THE CITY OF WINNIPEG
WORKS & OPERATIONS DEPARTMENT
WATERWORKS, WASTE & DISPOSAL DIVISION

NORTH END WATER POLLUTION CONTROL CENTRE
PRIMARY CLARIFIER ADDITION
ELECTRICAL — POWER & MOTOR FEEDERS FLOOR PLAN EL. 33.50

SCALE: AS SHOWN
DATE: MAY, 1978
CONSULTANT DRAWING NO. 76012-05-E-102
CITY DRAWING NO.

NR 11 143