


S:\a\17\murray\PROJECTS\2008 Projects\014 - King Street & Old Market Square\Construction\_Rig\Drawings\01-2008-08-01\014\_L4\_SIT-PLAN-RI.dwg  
 8/7/2008 2:25 PM  
 By: SMM

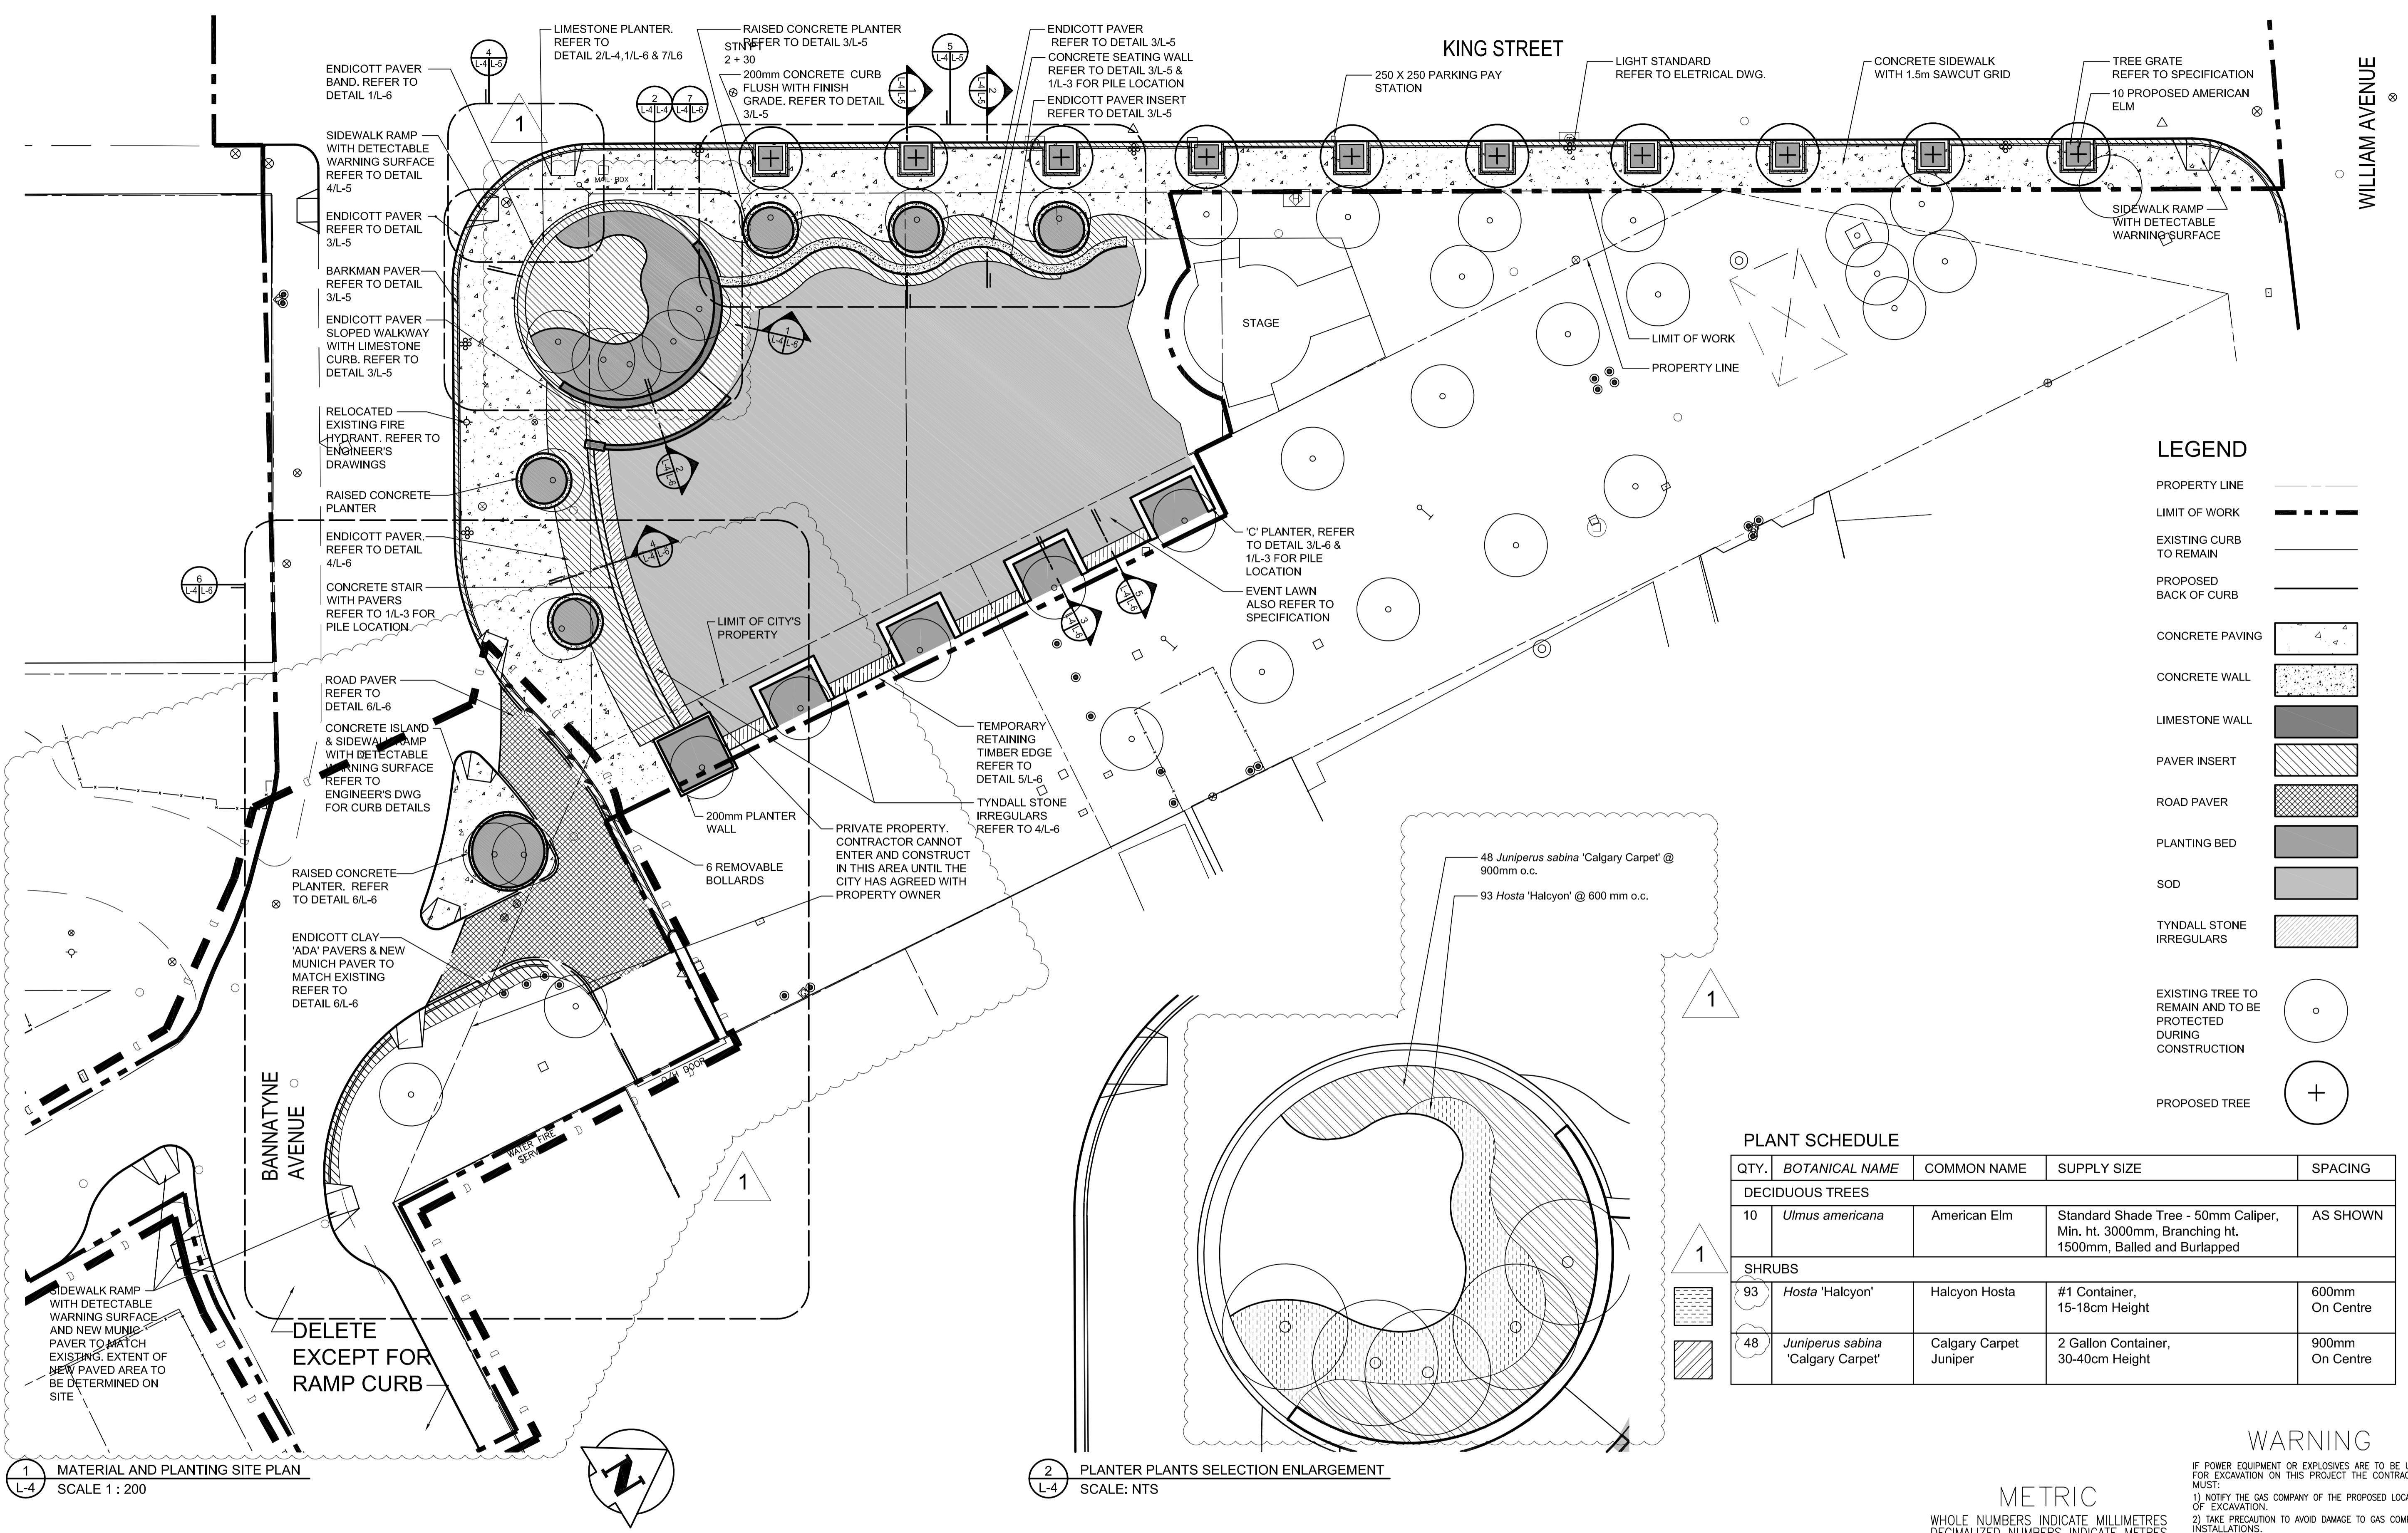

### LEGEND

PROPERTY LINE	---
LIMIT OF WORK	--- ---
EXISTING CURB TO REMAIN	---
PROPOSED BACK OF CURB	---
CONCRETE PAVING	[Pattern]
CONCRETE WALL	[Pattern]
LIMESTONE WALL	[Pattern]
PAVER INSERT	[Pattern]
ROAD PAVER	[Pattern]
PLANTING BED	[Pattern]
SOD	[Pattern]
TYNDALL STONE IRREGULARS	[Pattern]
EXISTING TREE TO REMAIN AND TO BE PROTECTED DURING CONSTRUCTION	(o)
PROPOSED TREE	(+)

### PLANT SCHEDULE

QTY.	BOTANICAL NAME	COMMON NAME	SUPPLY SIZE	SPACING
<b>DECIDUOUS TREES</b>				
10	<i>Ulmus americana</i>	American Elm	Standard Shade Tree - 50mm Caliper, Min. ht. 3000mm, Branching ht. 1500mm, Balled and Burlapped	AS SHOWN
<b>SHRUBS</b>				
93	<i>Hosta 'Halcyon'</i>	Halcyon Hosta	#1 Container, 15-18cm Height	600mm On Centre
48	<i>Juniperus sabina 'Calgary Carpet'</i>	Calgary Carpet Juniper	2 Gallon Container, 30-40cm Height	900mm On Centre

1 L-4 MATERIAL AND PLANTING SITE PLAN SCALE 1 : 200

2 L-4 PLANTER PLANTS SELECTION ENLARGEMENT SCALE: NTS

**WARNING**  
 IF POWER EQUIPMENT OR EXPLOSIVES ARE TO BE USED FOR EXCAVATION ON THIS PROJECT THE CONTRACTOR MUST:  
 1) NOTIFY THE GAS COMPANY OF THE PROPOSED LOCATION OF EXCAVATION.  
 2) TAKE PRECAUTION TO AVOID DAMAGE TO GAS COMPANY INSTALLATIONS.  
 SEE PROVINCIAL REGULATION 140/92 FOR DETAILS

**METRIC**  
 WHOLE NUMBERS INDICATE MILLIMETRES  
 DECIMALIZED NUMBERS INDICATE METRES

150 WM	WATERMAIN	150 WM	HYDRO	150 WM	WATERMAIN	150 WM
Hydrant	HYDRANT	Valve	M.T.S.	Hydrant, Valve	HYDRANT, VALVE	Valve
300 LDS	LAND DRAINAGE SEWER	300 LDS	CONCRETE	300 LDS	LAND DRAINAGE SEWER	300 LDS
250 WWS	WASTE WATER SEWER	250 WWS	ASPHALT	250 WWS	WASTE WATER SEWER	250 WWS
Manhole	MANHOLE	Catch Basin	PROPERTY LINE	Survey Bar	NORTH OR WEST GUTTER	Survey Bar
Catch Basin	CATCH BASIN	Curb Inlet	DITCH	Ditch	SOUTH OR EAST GUTTER	Curb Inlet
Junctions	JUNCTIONS	Culvert	ELEVATION	Elevation	NORTH OR WEST P L	Junctions
Gas	GAS		Sidewalk Ramp	Sidewalk Ramp	SOUTH OR EAST P L	Gas
Existing	LEGEND-PLAN	Proposed	Existing	LEGEND-PLAN	Proposed	Existing

**LOCATION APPROVED UNDERGROUND STRUCTURES**

SUPV. U/G STRUCTURES COMMITTEE DATE

**NOTE:**  
 LOCATION OF UNDERGROUND STRUCTURES AS SHOWN ARE BASED ON THE BEST INFORMATION AVAILABLE BUT NO GUARANTEE IS GIVEN THAT ALL EXISTING UTILITIES ARE SHOWN OR THAT THE GIVEN LOCATIONS ARE EXACT. CONFIRMATION OF EXISTENCE AND EXACT LOCATION OF ALL SERVICES MUST BE OBTAINED FROM THE INDIVIDUAL UTILITIES BEFORE PROCEEDING WITH CONSTRUCTION.

B.M. ELEV.			
1	ISSUED FOR ADDENDUM 3	08.08.07	DM
0	ISSUED FOR TENDER	08.07.14	DM
NO. REVISIONS	DATE	BY	

**SCATLIFF + MILLER + MURRAY Inc.**

DESIGNED BY	CO / DM	CHECKED BY	DM
DRAWN BY	MBP / MB / WF	APPROVED BY	CO
SCALE:	AS NOTED	RELEASED FOR CONSTRUCTION:	
DATE	08.07.14	DATE	08.07.14

LANDSCAPE ARCHITECT'S SEAL  
 ORIGINALLY SEALED BY  
 DEREK MURRAY  
 2008/07/14

**THE CITY OF WINNIPEG**  
 DEPARTMENT OF PLANNING  
 PROPERTY AND DEVELOPMENT

**KING STREET - RECONSTRUCTION  
 OLD MARKET SQUARE - PHASE 1  
 REDEVELOPMENT**

MATERIAL AND PLANTING SITE PLAN

SHEET 9 OF 15  
 CAD FILE DRAWING NUMBER 8014\_L4\_SITE-PLAN-RI.DWG  
 CITY DRAWING NUMBER P-3295-08

CONSULTANT DRAWING NO. L-4