



- 204-1 120 VOLT FROM CONTROL TRANS.
- 204-2 204-M MAGNETIC MOTOR STARTER
- 204-3 204-1R CONTROL RELAY, 204-2, 204-4 204-PE1 PRESS. ELECT SW. SET AT 15 PSIG
- 204-4 204-PE2 PRESS. ELECT. SW. SET AT 7 PSIG
- 204-5
- 204-6 204-EPI SOLENOID VALVE (H.C.)
- 204-7 DRY CONTACT IN ENGINE CONTROL PANEL


ENGINE CONTROL PANEL

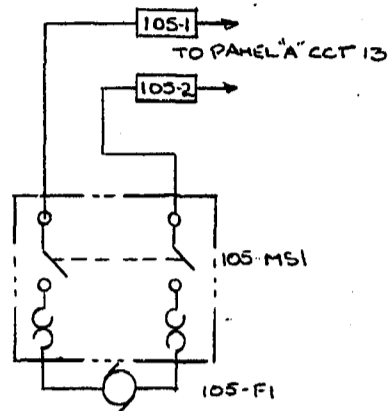


- 105-1 120V SUPPLY
- 105-2
- 105-3
- 105-4 105-MS1 MANUAL MOTOR STARTER
- 105-5
- 105-6 105-F1 FAN MOTOR

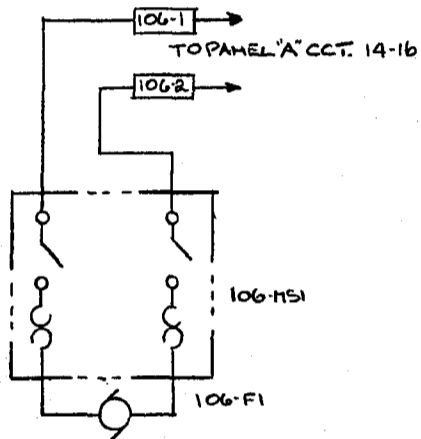


- 106-1 240V SUPPLY
- 106-2
- 106-3
- 106-4 106-MS1 MANUAL MOTOR STARTER
- 106-5
- 106-6 106-F1 FAN MOTOR

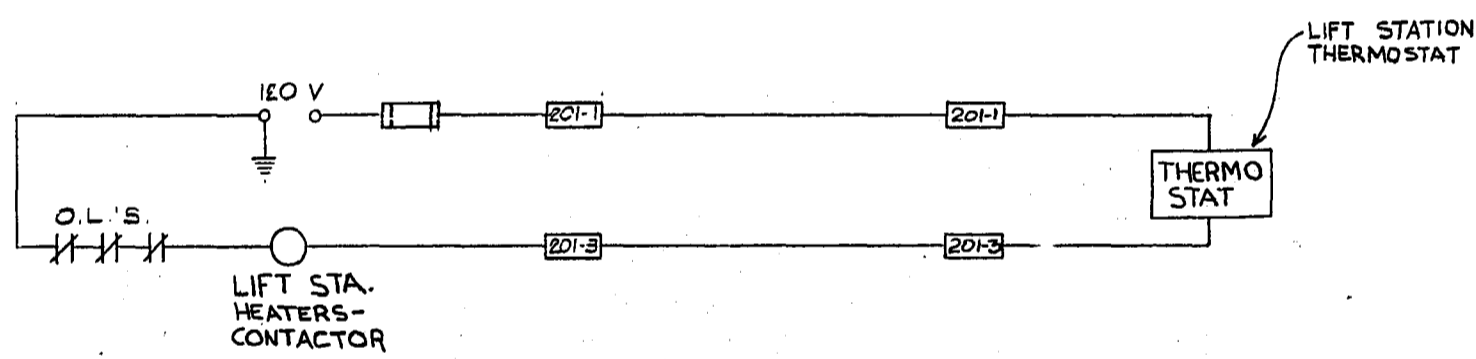

- 201-1 "120V" FROM CONTROL TRANSFORMER
- 201-2
- 201-3
- 201-4
- 201-5
- 201-6
- 201-7
- 201-8
- 201-9
- 201-10
- 201-11

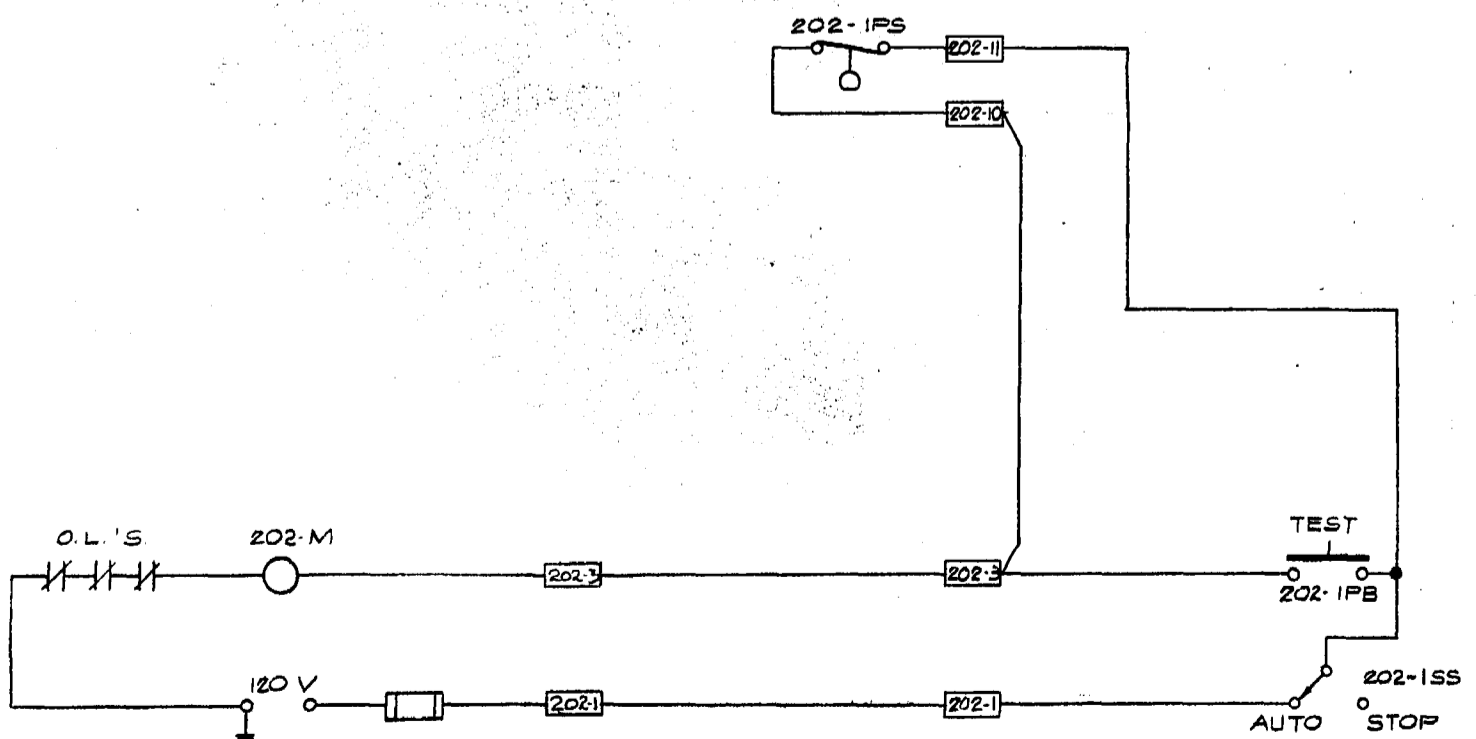

- 202-11 "202-1PS" PRESS. SW. "CYCLE 2ND DUTY COMPRESSOR"
- 202-10
- 202-9
- 202-8
- 202-7
- 202-6
- 202-5
- 202-4 "202-IPB" TEST PUSH BUTTON
- 202-3 "202-M" COMPRESSOR STARTER (201-4, 201-5)
- 202-2
- 202-1 "202-1SS" "AUTO-STOP" SELECTOR SWITCH 120 VOLT FROM CONTROL TRANSFORMER

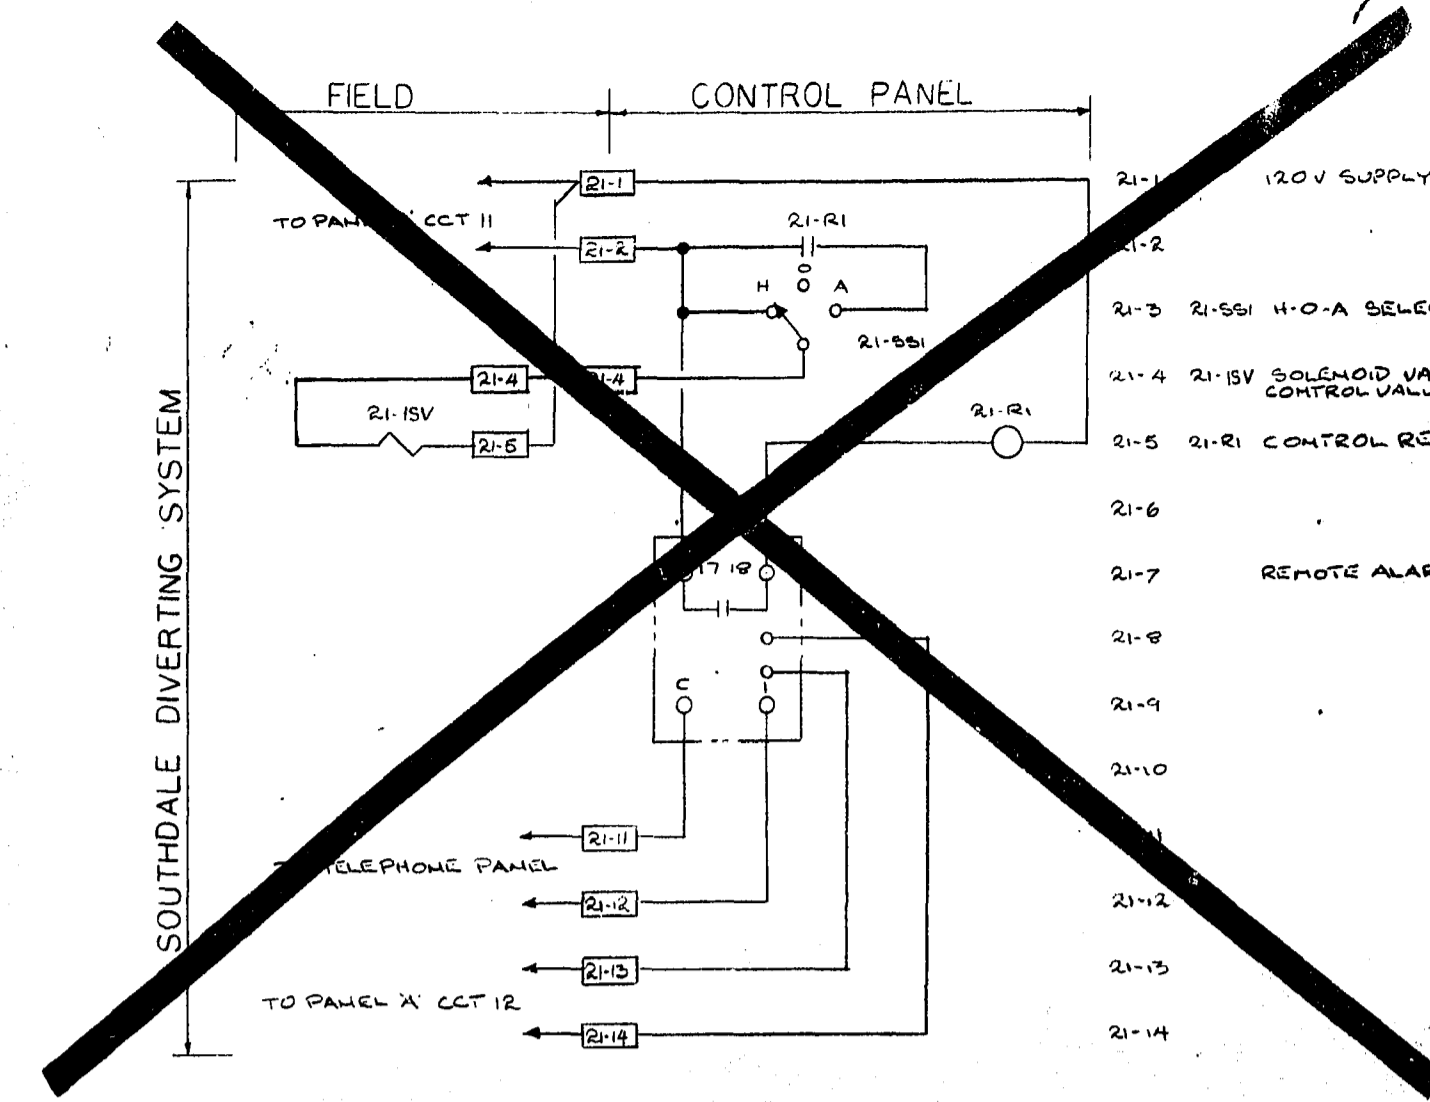

- 21-1 120V SUPPLY
- 21-2
- 21-3 21-5S1 H-O-A SELECTOR SW
- 21-4 21-15V SOLENOID VALVE PERMIT CONTROL VALVE OPERATION
- 21-5 21-R1 CONTROL RELAY (21-2, 20-24)
- 21-6
- 21-7 REMOTE ALARM RECEIVER
- 21-8
- 21-9
- 21-10
- 21-11
- 21-12
- 21-13
- 21-14

VENT FAN # 105

VENT FAN # 106

LIFT STN. HEATERS

AIR COMPRESSOR # 202

1 REVISED TO DATE		30.86 MD
NO.	DESCRIPTION	DATE BY
REVISIONS		
CITY OF WINNIPEG WORKS AND OPERATIONS DIVISION DISTRICT 5		
W.L. WARDROP & ASSOCIATES LTD. ENGINEERING CONSULTANTS WINNIPEG • THUNDER BAY • REGINA • BARRIE • EDMONTON		
WINDSOR PARK LIFT STATION RENOVATION CONTROL SCHEMATICS, AIR COMP., VENTILATION, & SANITARY		
DESIGNED BY: JH	DRAWN BY: KFM	CHECKED BY: [Signature]
APPROVED BY: [Signature]	SCALE: N.T.S.	DATE: 1/76
DRAWING NO: 76012-04-E4		REV: 0

AS - BUILT
DATE: 7/76
FR. NO. []
PAGE []

