
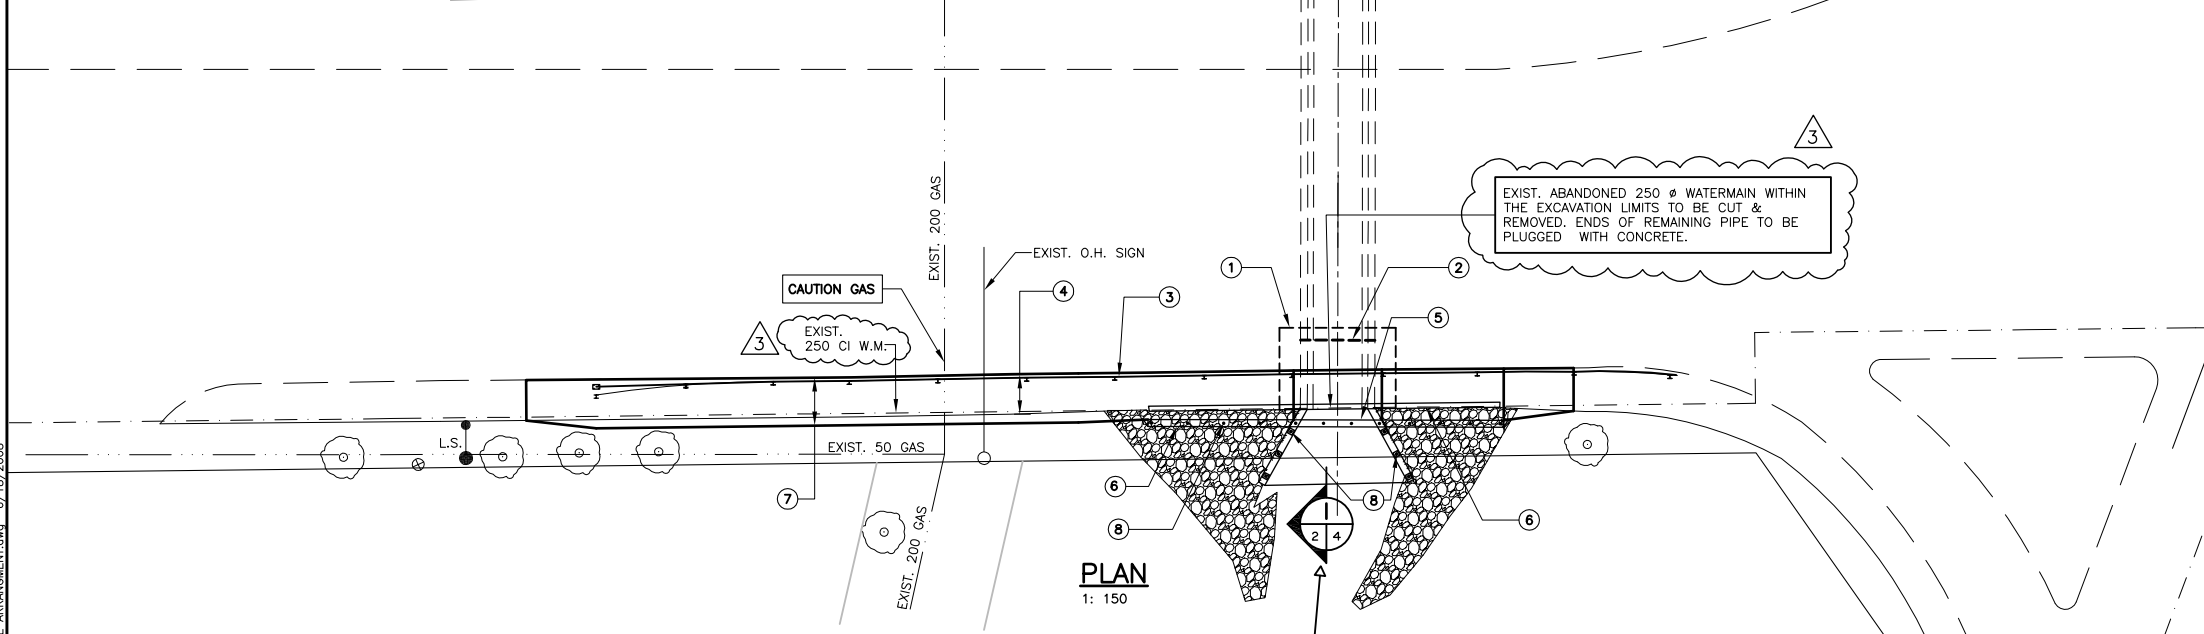


LOCATION PLAN
N.T.S.

TOP OF THE SIDEWALK PROFILE

HORZ. : 150
VERT. : 40

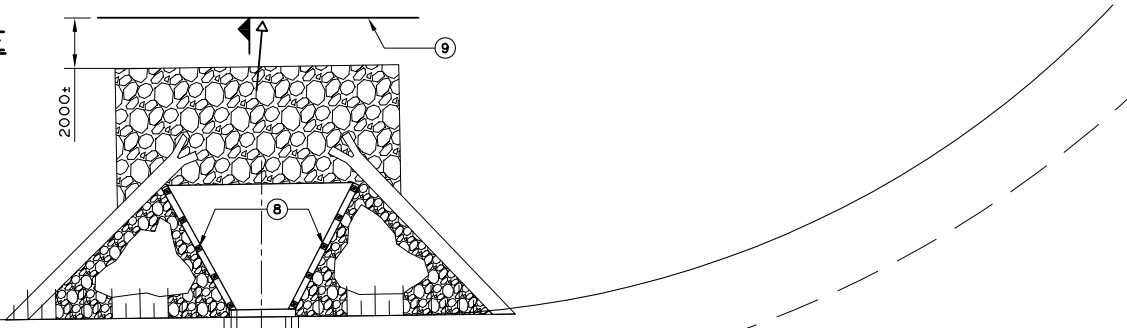

PLAN
1: 150

PROPOSED WORKS	REFERENCE DRAWING NUMBER
1 REMOVE & REPLACE SECTION OF EXISTING ROADWAY CURB & PAVEMENT	C312-08-03, 04, & 05
2 REMOVE & REPLACE SECTION OF EXISTING ROOF OF CONCRETE BOX CULVERT	C312-08-03, 04, & 05
3 REMOVE, MODIFY & REINSTALL EXISTING TRAFFIC BARRIER	C312-08-03, 05, 06 & 07
4 REMOVE EXISTING CONCRETE SIDEWALK	C312-08-03, 04, & 05
5 REMOVE & REPLACE EXISTING CONC. HEADWALL PARAPET	C312-08-04, & 05
6 REMOVE & REPLACE EXISTING CONC. SIDEWALK CURB	C312-08-03
7 CONSTRUCT WIDENED CONCRETE SIDEWALK	C312-08-03, 04, & 05
8 INSTALL CHAINLINK FENCE	C312-08-06
9 INSTALL & MAINTAIN TEMPORARY SILT FENCES	C312-08-02

NOTE:
1. INSTALL SILT FENCE IMMEDIATELY DOWNSTREAM OF RIPRAP AS SHOWN ON THIS DRAWING. SILT FENCE TO BE MAINTAINED DURING CONSTRUCTION AND REMOVED UPON COMPLETION.

B.M. ELEV.	DESIGNED BY JSB				
	DRAWN BY NBG/DDW				
	CHECKED BY JSB				
	APPROVED BY				
3 ADDENDUM 1 06/09/08 JSB	HOR. SCALE AS NOTED	RELEASED FOR CONSTRUCTION	CONSULTANT PROJECT NO. 089072	2008 BRIDGE MAINTENANCE ARCHIBALD STREET BOX CULVERT AT DUGALD DRAIN	
2 ISSUED FOR TENDER 26/08/08 JSB	VERTICAL AS NOTED	ORIGINAL SIGNED BY B.A. NEIRINCK			CITY DRAWING NUMBER C312-08-02
1 ISSUED FOR CITY REVIEW 20/08/08 JSB	DATE AUGUST 2008	DATE AUG. 28, 2008			SHEET 2 OF 7
NO. REVISIONS	DATE	DATE		GENERAL ARRANGEMENT	BID OPPORTUNITY 674-2008

4-DILLON ACAD FILE: G:\CAD_089072\Contract\Current\2 - GENERAL ARRANGEMENT.dwg 6/18/2008