

TE-6000-4  
1000 OHM  
RESISTIVE  
TEMPERATURE  
ELEMENT



**NOTE:**

WHEN USING FM-IUN101-0 IN  
2-WIRE RTD APPLICATION AS SHOWN  
JUMPER TERMINAL 1 TO 4 AND  
2 TO 5 AND SET W1=4 AND W2=1  
TO ELIMINATE TEMPERATURE  
OFFSET CAUSED BY IUN INPUT  
FUSING.


THIS COMPENSATION IS NOT  
REQUIRED WITH THE FM-IUN101-1.

**TEMPERATURE MONITORING**




(TYPICAL OF 6 - REFER Dwg. 1501-37)

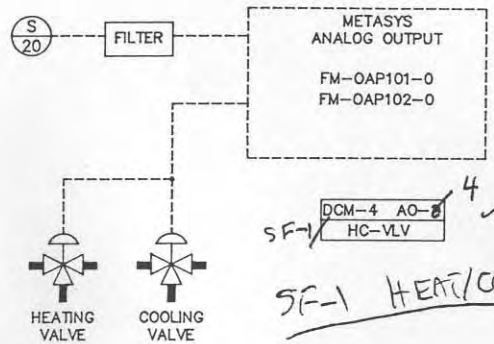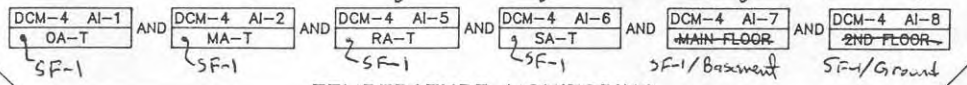



*SF-1 HEAT/COOL COILS*

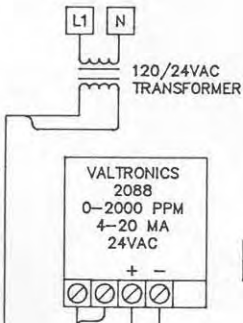


*DCM-4 AI-4 CO2RA SF-1/CO2-RA*

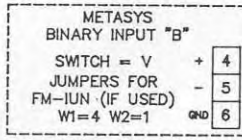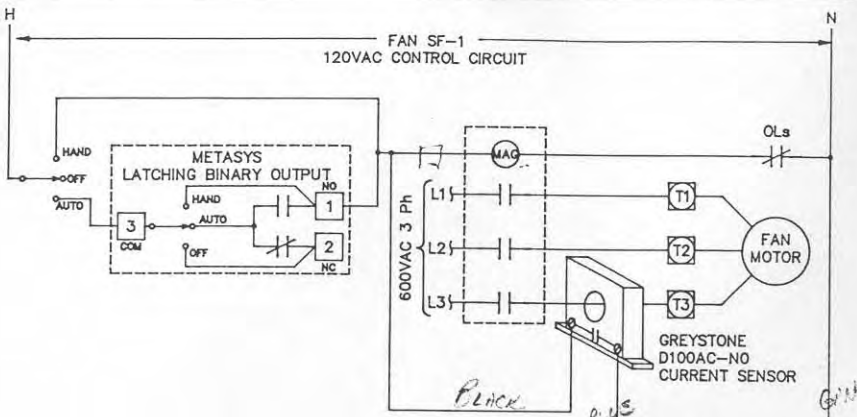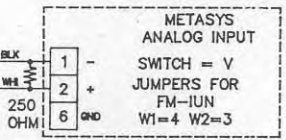




TERMINAL ARRANGEMENT FOR FAN STATUSES WIRED TO INPUT "B"

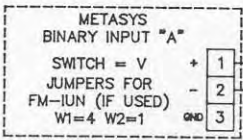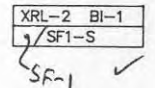

TERMINAL ARRANGEMENT FOR FAN STATUSES WIRED TO INPUT "A"

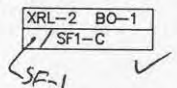

10K OHM/2W  
REQUIRED TO MATCH  
METASYS BI IMPEDANCE  
TO GREYSTONE CURRENT  
SENSOR  
-LOCATED IN M.C.C.

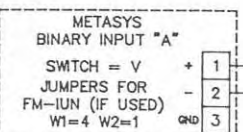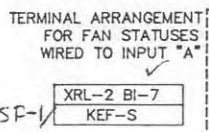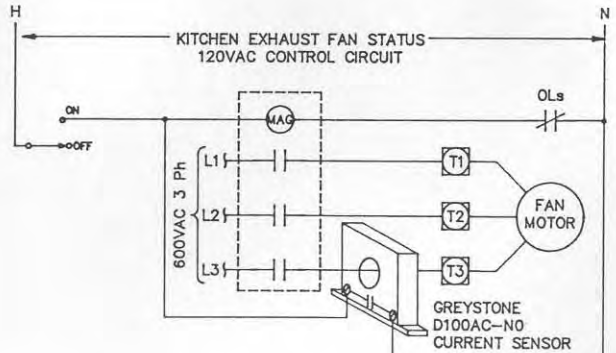


10K OHM/2W  
REQUIRED TO MATCH  
METASYS BI IMPEDANCE  
TO GREYSTONE CURRENT  
SENSOR  
-LOCATED IN M.C.C.



**LEGEND**

(n) EXISTING M.C.C. TERMINALS

(n) METASYS BASEFRAME TERMINALS

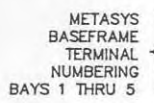

METASYS BASEFRAME TERMINAL NUMBERING BAYS 6 THRU 9

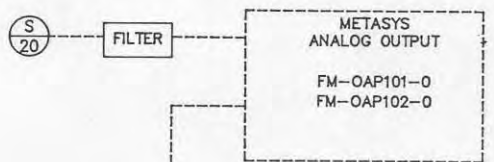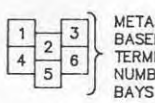

*DCM-4 AO-9 MA-DMP SF-1*

*SF-1 DAMPERS*

DRAWING TITLE SF1 WIRING DETAILS		FILE: SF1WRE	
PROJECT WINNEPEG TRANSIT ADMINISTRATION AND G SECTION METASYS FACILITY MANAGEMENT SYSTEM	CONTRACT NUMBER 91098-5006 DRAWING NUMBER 1501-38	DATE BY 04/10/04 EON	
REFERENCE DRAWING NO. SALES ENGR PROJECT WORK/APPL ENGR REV	REVISION-LOCATION NO. DATE	DATE BY EON	
JOHNSON CONTROLS Systems & Services Division		204-985-9380	