


PLAN OF DIGESTION GALLERIES NO. 1, 2, 3 ELEV. 34.0
SCALE 1/8" = 1'-0"

REVISIONS		
No.	DATE	DETAIL

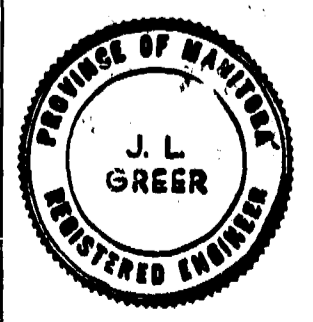

FOR ACTUAL ELEV. SUBTRACT 0.37 FT. **AS BUILT**

THE METROPOLITAN CORPORATION OF GREATER WINNIPEG
WATERWORKS AND WASTE DISPOSAL DIVISION

NORTH END SEWAGE TREATMENT PLANT
CONTRACT A-DIGESTION GALLERIES 1 TO 3 - MECHANICAL
GAS SYSTEM PLAN & SECTIONS

APPROVED <i>J.W. MacLaren</i> JAMES F. MACLAREN LIMITED ENGINEERS TORONTO	APPROVED <i>J.L. Greer</i> J.L. GREER REGISTERED ENGINEER
DESIGNED BY <i>J.P. MacLaren</i>	ENGINEER OF WASTE DISPOSAL <i>A. Brown</i>
W.L. WARDROP ASSOCIATES (MANAGEMENT) LIMITED ENGINEERING CONSULTANTS WINNIPEG	DIRECTOR & CHIEF ENGINEER <i>J.P. Sullivan</i>

DATE: MARCH 11, 1963
SCALE: AS SHOWN
DWG. No. 125 OF 217
NEP-125