## NOTES:

1. ALLEN BRADLEY:
   ORDER No. 0398090/006
   DWG. DD2039-006-92
2. DISCONNECT AND REMOVE CABLE FROM MCC BUCKET THROUGH TO THE MOTOR. REMOVE AND DISPOSE OF EXISTING DRIVE. RE-LABEL BUCKET AS 'SPARE'.
3. SUPPLY AND INSTALL A NEW MCC BUCKET COMPLETE WITH A 200A CIRCUIT BREAKER TO FEED THE NEW 100HP ODOUR DISPERSION STACK EXHAUST FAN VFD.
4. SUPPLY AND INSTALL A NEW MCC BUCKET STARTER AS PER STARTER SCHEMATIC.

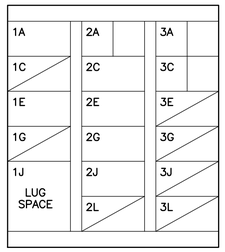


1 — MCC-1U ELEVATION
SCALE: N.T.S.

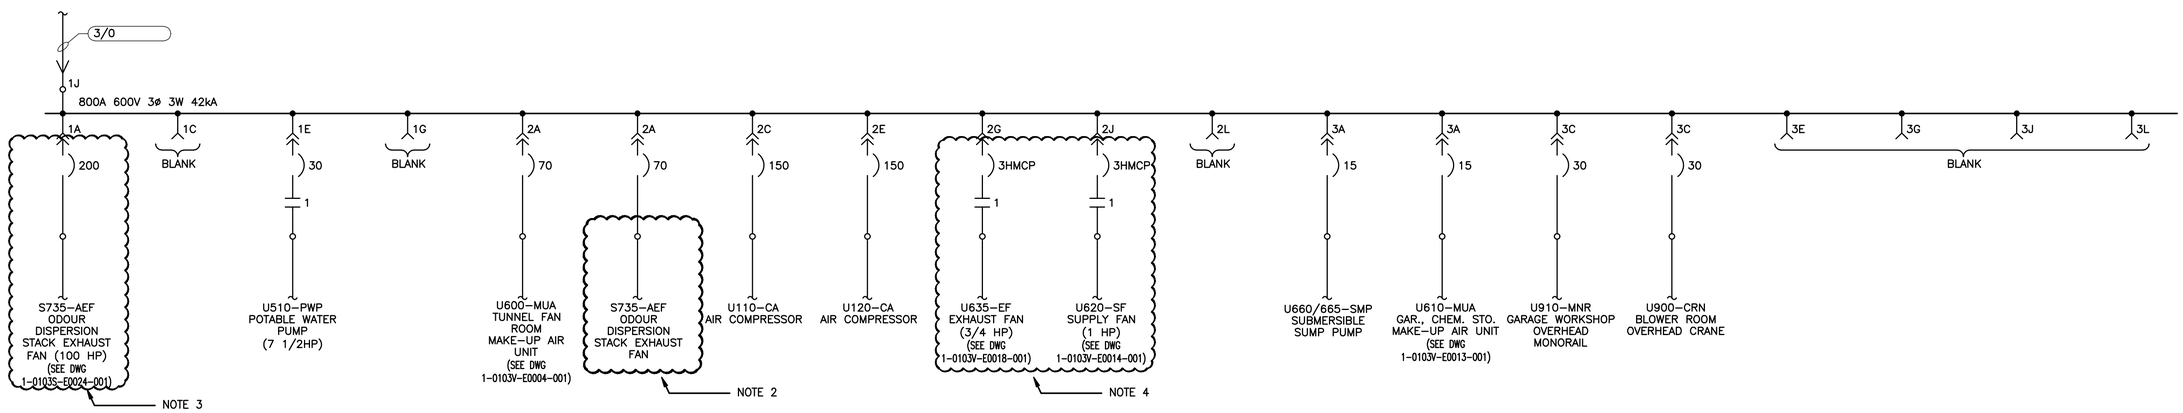


2 — MCC-1U SINGLE LINE DIAGRAM
SCALE: N.T.S.

APEGM Certificate of Authorization KGS Group No. 245 Date: 2010/12/21

KGS GROUP CONSULTING ENGINEERS

| B.M. ELEV. | FIELD BOOK #: | | |
|---|---|---|---|
| POSTED TO LBIS | | | |
| 00 | ISSUED FOR TENDER | 2010-12-21 | REW |
| NO. | REVISIONS | DATE | BY |

ALLIANCE Engineering Services Inc.

| | | | |
|---|---|---|---|
| DESIGNED BY | REW/AP | CHECKED BY | REW |
| DRAWN BY | GCN | APPROVED BY | REW |
| HOR. SCALE | N.T.S. | RELEASED FOR CONSTRUCTION | |
| VERTICAL | N.T.S. | | |
| DATE | 2009 09 29 | DATE | |

ENGINEER'S SEAL: PROVINCE OF MANITOBA — R.E. WILLMS Member 3833 — REGISTERED PROFESSIONAL ENGINEER

TENDER No. LE2.4
FILENAME: 1-0103A-E0010-001-Rev 00.dwg
PLOT DATE: 2010/12/16

Winnipeg — THE CITY OF WINNIPEG
WATER AND WASTE DEPARTMENT

2010 HVAC REPLACEMENT AND ASSOCIATED WORKS
WEWPCC
MCC-1U SINGLE LINE DIAGRAM AND PHYSICAL LINE UP

SHEET 1 OF 1
CITY DRAWING NUMBER
1-0103A-E0010-001

CW-9-M564-1
FileName: P:\Projects\2009\09-0754-08\Doc.Control\ToBeIssued\DWG\ELECTRICAL\1-0103A-E0010-001-Rev 00.dwg – Tab: 1-0103A-E0010-001 Plotted By: GNelson 12/16/2010 [Thu 5:24pm]