


File Name: P:\Projects\2009\09-0754-08\DocControl\ToBeIssued\DWG\ELECTRICAL\1-0103A-E0011-001-Rev 00.dwg - Tab: 1-0103A-E0011-001-001 Plotted By: G.Nelson 12/16/2010 [Thu 5:23pm]


CW-9-M564-1

NOTES:

1. ALLEN BRADLEY:
ORDER No. 0398090/007
DWG. DD2039-007-92
2. DISCONNECT AND REMOVE CABLE FROM MCC BUCKET THROUGH TO THE MOTOR. REMOVE AND DISPOSE OF EXISTING DRIVE. RE-LABEL BUCKET AS 'SPARE'.
3. SUPPLY AND INSTALL A NEW MCC BUCKET COMPLETE WITH A 200A CIRCUIT BREAKER TO FEED THE NEW 100HP ODOUR DISPERSION STACK EXHAUST FAN VFD.
4. SUPPLY AND INSTALL A NEW MCC BUCKET STARTER AS PER STARTER SCHEMATIC.

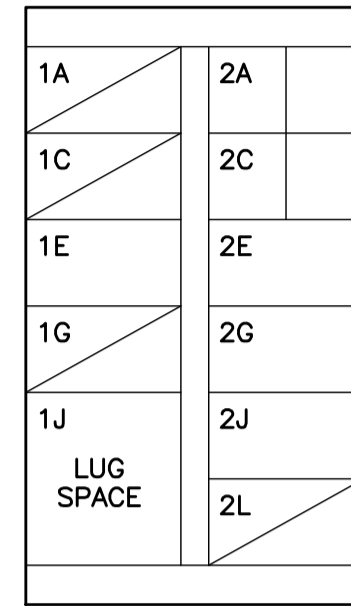

1 MCC-2U ELEVATION
SCALE: N.T.S.

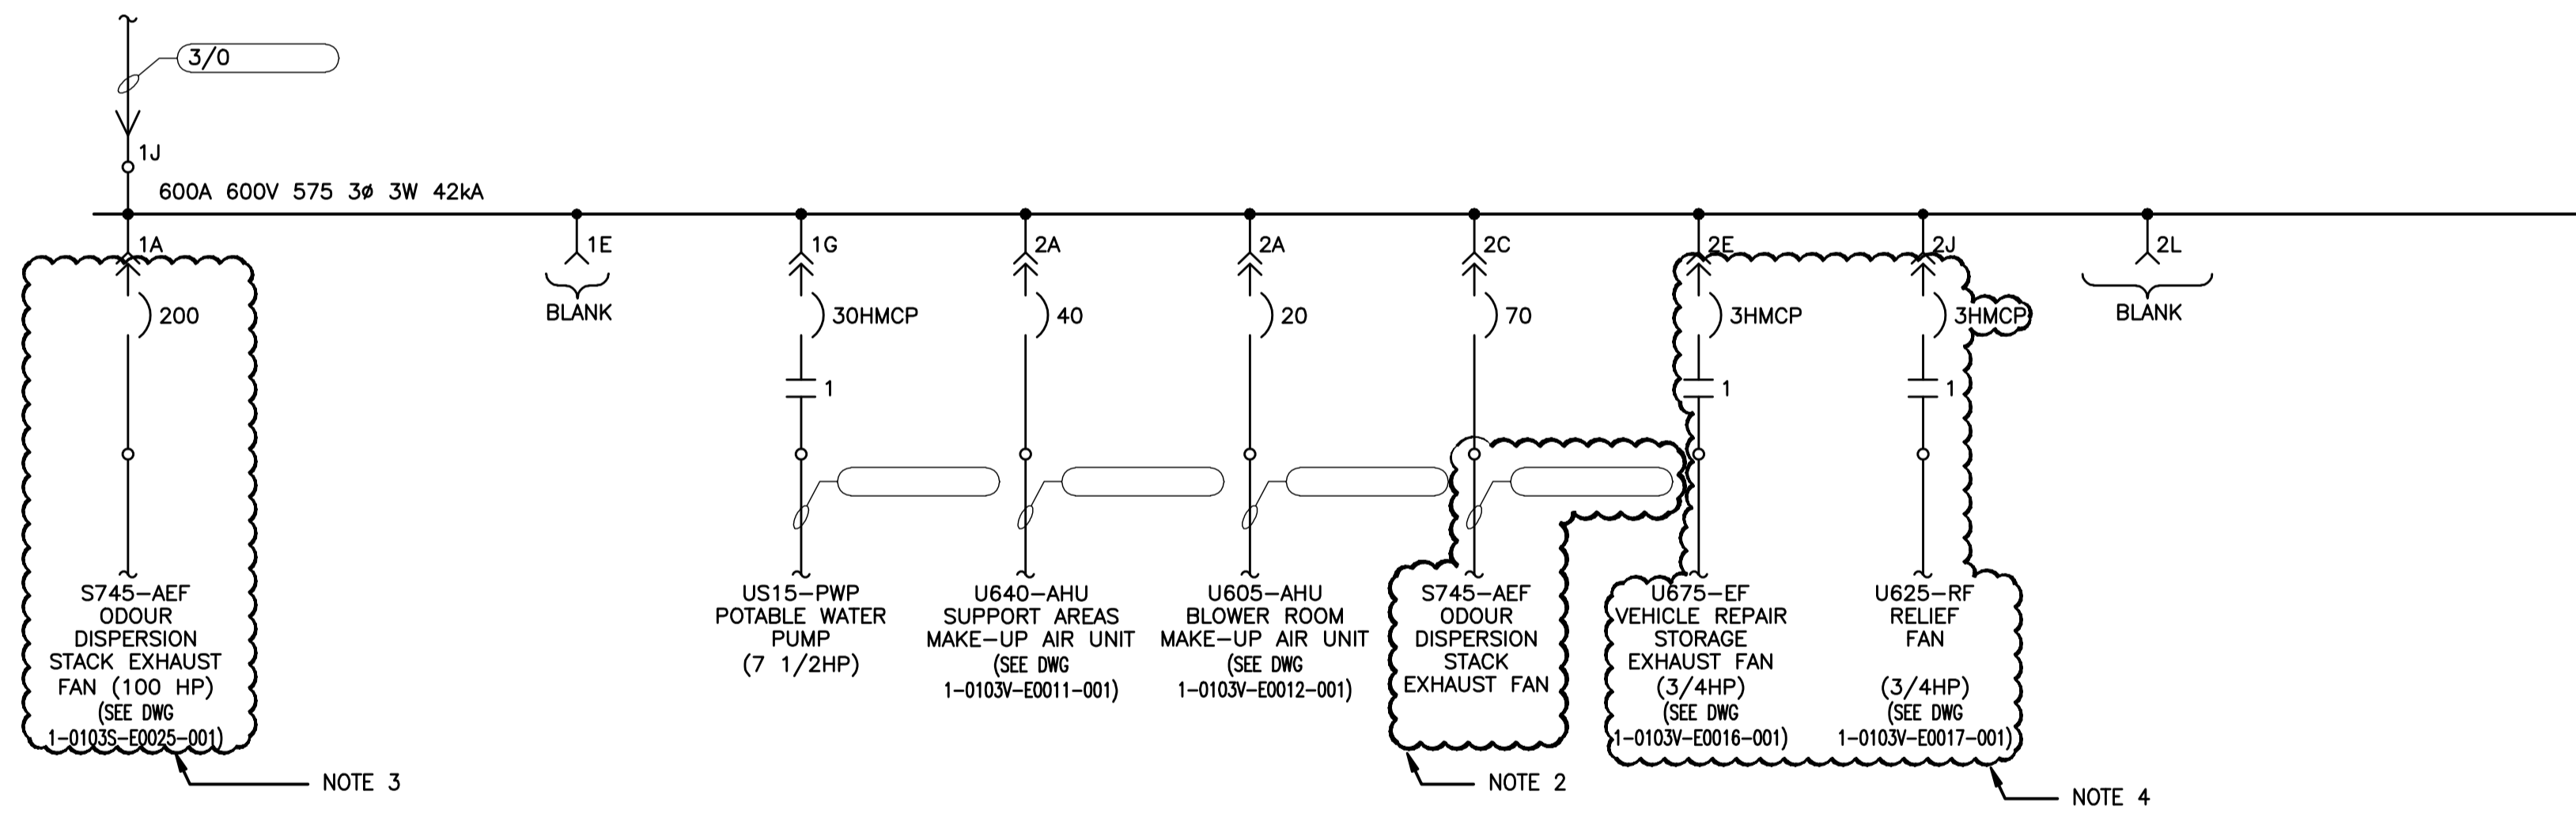

2 MCC-2U SINGLE LINE DIAGRAM
SCALE: N.T.S.

APEGN
Certificate of Authorization
KGS Group
No. 245 Date: 2010/12/21

KGS GROUP
CONSULTING ENGINEERS

B.M. ELEV.	FIELD BOOK #:
POSTED TO LBIS	
DESIGNED BY	REW/DDW
DRAWN BY	GCN
HDR. SCALE	N.T.S.
VERTICAL	N.T.S.
00 ISSUED FOR TENDER	2010-12-21 REW
NO. REVISIONS	DATE BY

ALLIANCE
Engineering Services Inc.

DESIGNED BY	REW/DDW	CHECKED BY	REW
DRAWN BY	GCN	APPROVED BY	REW
HDR. SCALE	N.T.S.	RELEASED FOR CONSTRUCTION	
VERTICAL	N.T.S.		
DATE	2009 09 29	DATE	

ENGINEER'S SEAL

R.E. WILLMS
Member 3833

TENDER No. LE25
FILENAME: 1-0103A-E0011-001-Rev 00.dwg
PLDT DATE: 2010/12/16

THE CITY OF WINNIPEG
WATER AND WASTE DEPARTMENT

2010 HVAC REPLACEMENT AND ASSOCIATED WORKS
WEWPC
MCC-2U SINGLE LINE DIAGRAM AND PHYSICAL LINE UP

SHEET 1 OF 1
CITY DRAWING NUMBER
1-0103A-E0011-001