


File Name: P:\Projects\2009\09-0754-08\DocControl\ToBeIssued\DWG\ELECTRICAL\1-0103A-E0013-001-Rev 00.dwg - Tab: 1 - 0103A-E0013-001 Plotted By: G.Nelson 12/16/2010 [Thu 5:22pm] CW-9-M564-1

**NOTES:**

1. DISCONNECT AND REMOVE CABLE FROM MCC BUCKET THROUGH TO THE MOTOR. RE-LABEL STARTER BUCKET AS 'SPARE'.
2. SUPPLY AND INSTALL A NEW MCC BUCKET COMPLETE WITH TWO (2) 30A CIRCUIT BREAKERS; ONE TO FEED THE NEW 15HP SECONDARY CLARIFIER AXIAL EXHAUST FAN VFD AND ONE AS SPARE.

1A	2A	3A
1D	2C	3E
1F	2E	3G
1J	2G	3J
LUG SPACE	2J	3L

**1 MCC-2S ELEVATION**  
SCALE: N.T.S.

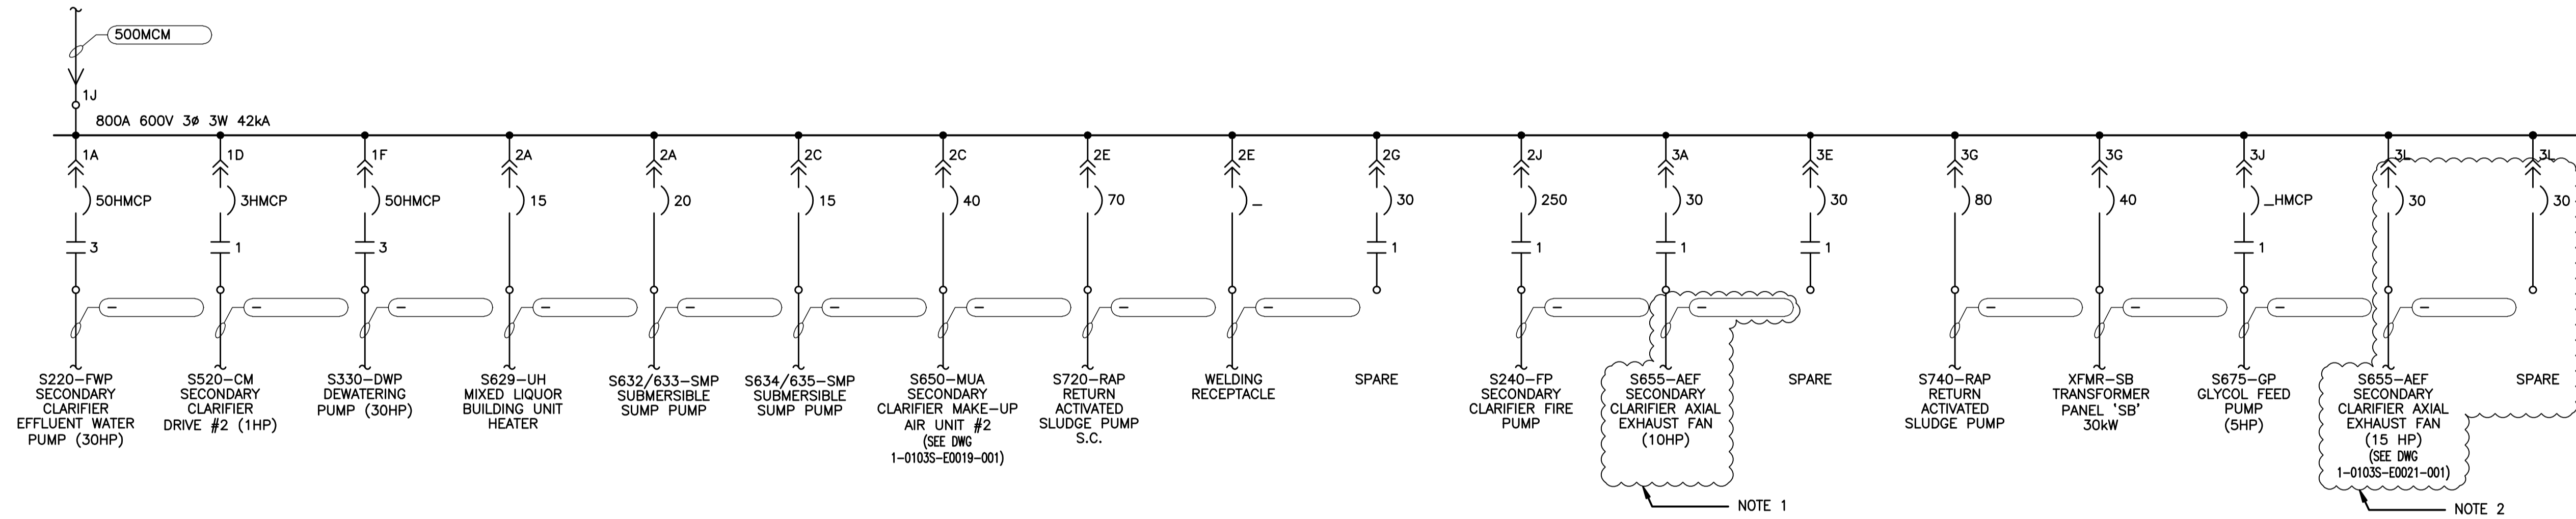

**2 MCC-2S SINGLE LINE DIAGRAM**  
SCALE: N.T.S.

 Certificate of Authorization KGS Group No. 245 Date: 2010/12/21		B.M. ELEV. .	FIELD BOOK #:		ENGINEER'S SEAL	 2010 HVAC REPLACEMENT AND ASSOCIATED WORKS <b>WEWCC</b> MCC-2S SINGLE LINE DIAGRAM AND PHYSICAL LINE UP	SHEET 1 OF 1
		POSTED TO LBIS			DESIGNED BY: REW/DDW CHECKED BY: REW DRAWN BY: GCN APPROVED BY: REW HDR. SCALE: N.T.S. VERTICAL: N.T.S. 00 ISSUED FOR TENDER 2010-12-21 REW 00 REVISIONS DATE BY DATE		 TENDER No. LE2.7 FILENAME: 1-0103A-E0013-001-Rev 00.dwg PLDT DATE: 2010/12/16