
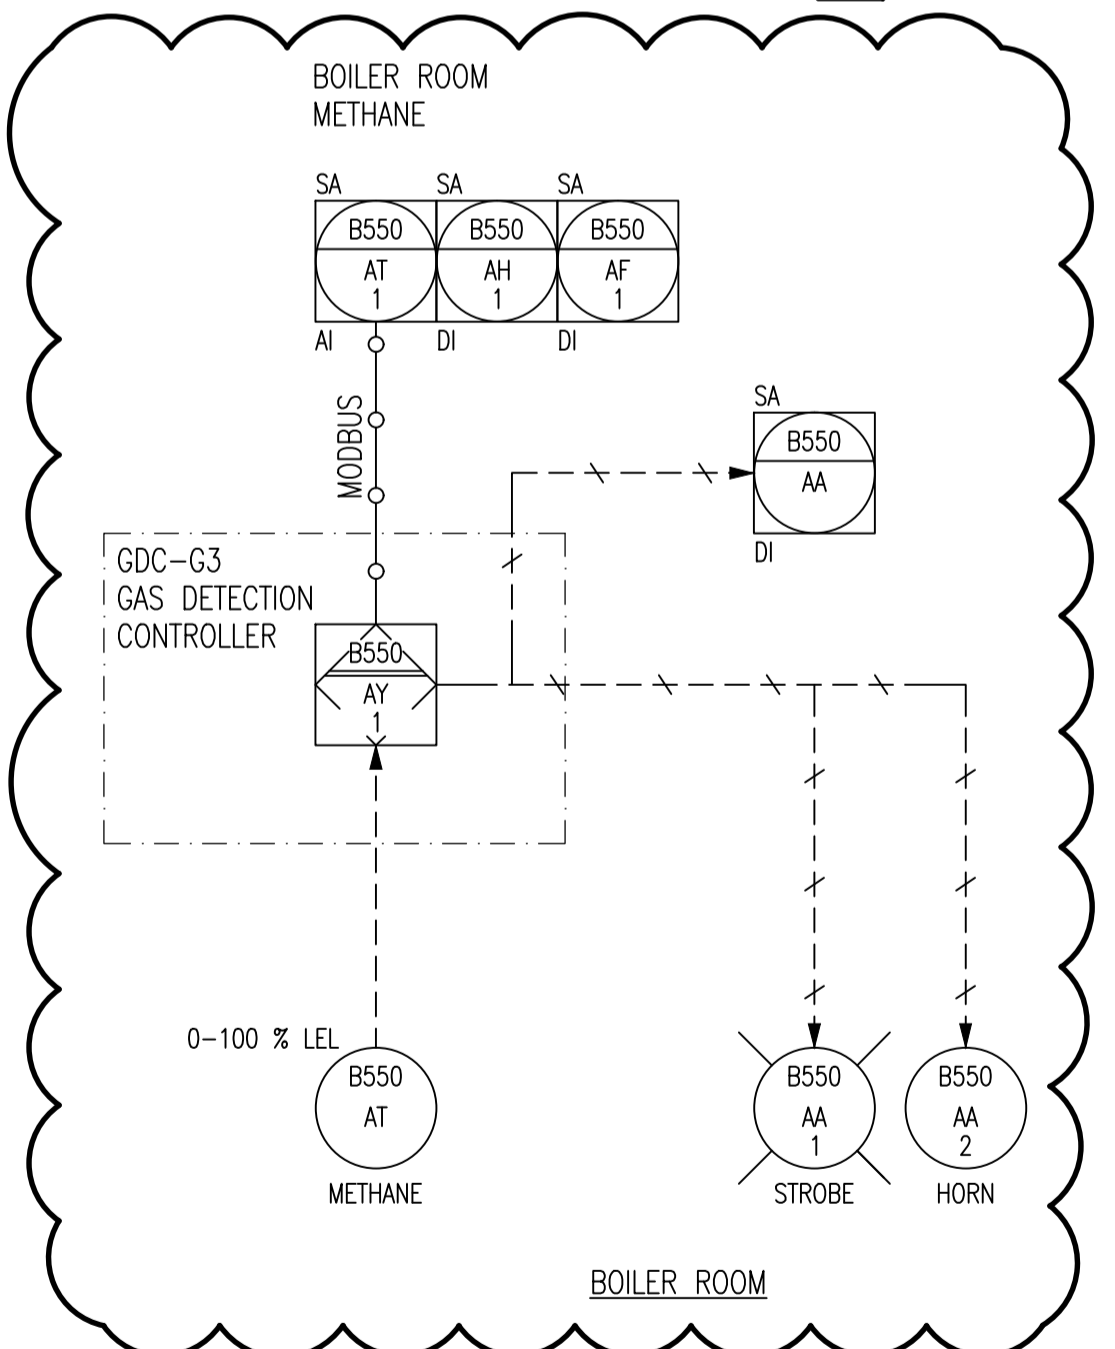
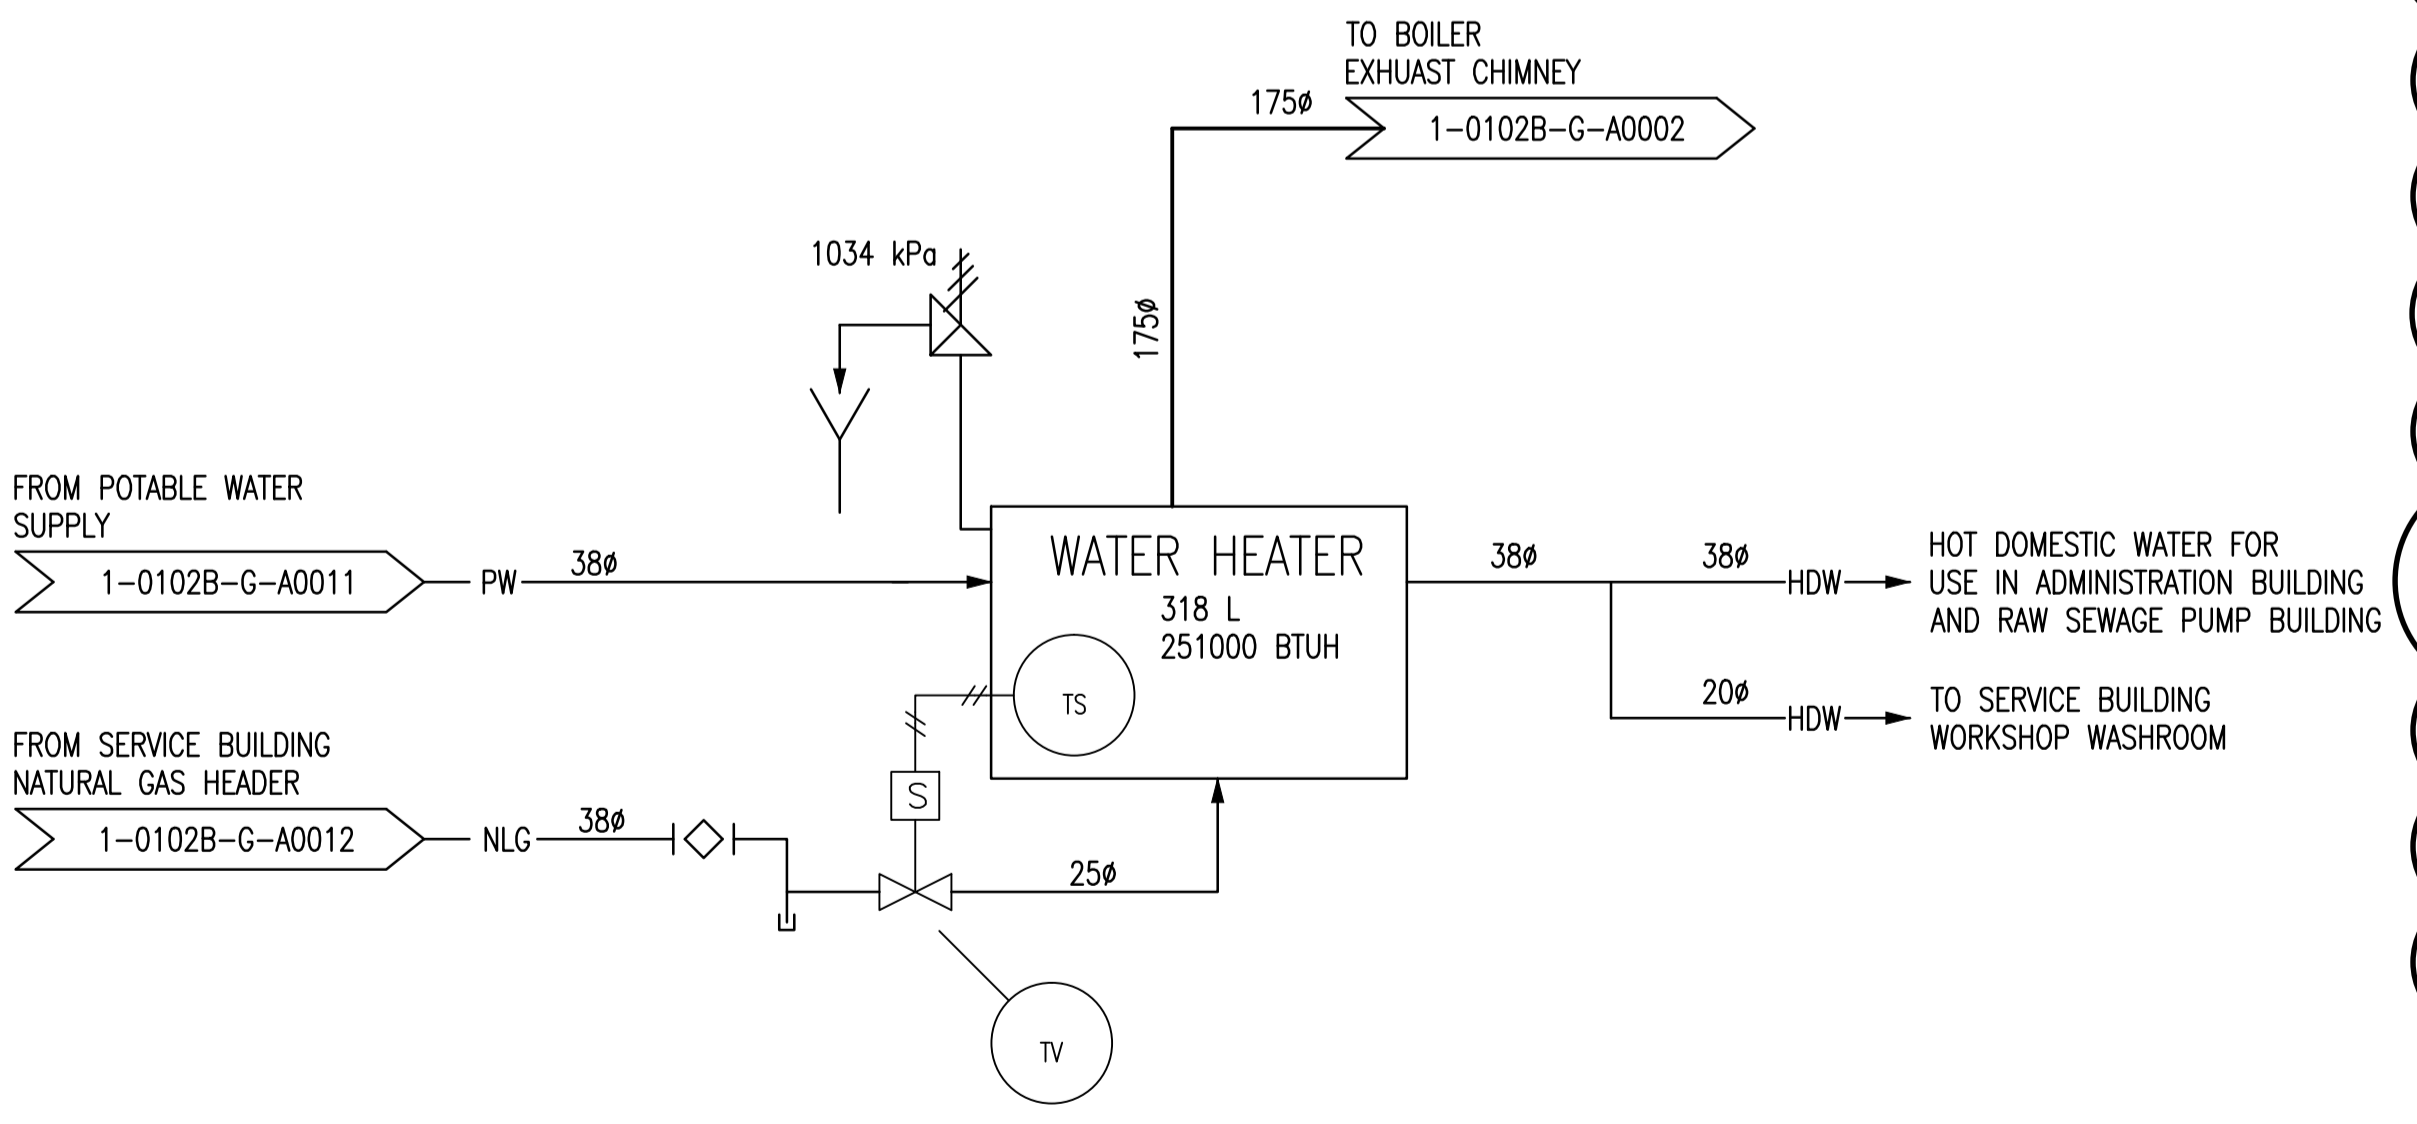
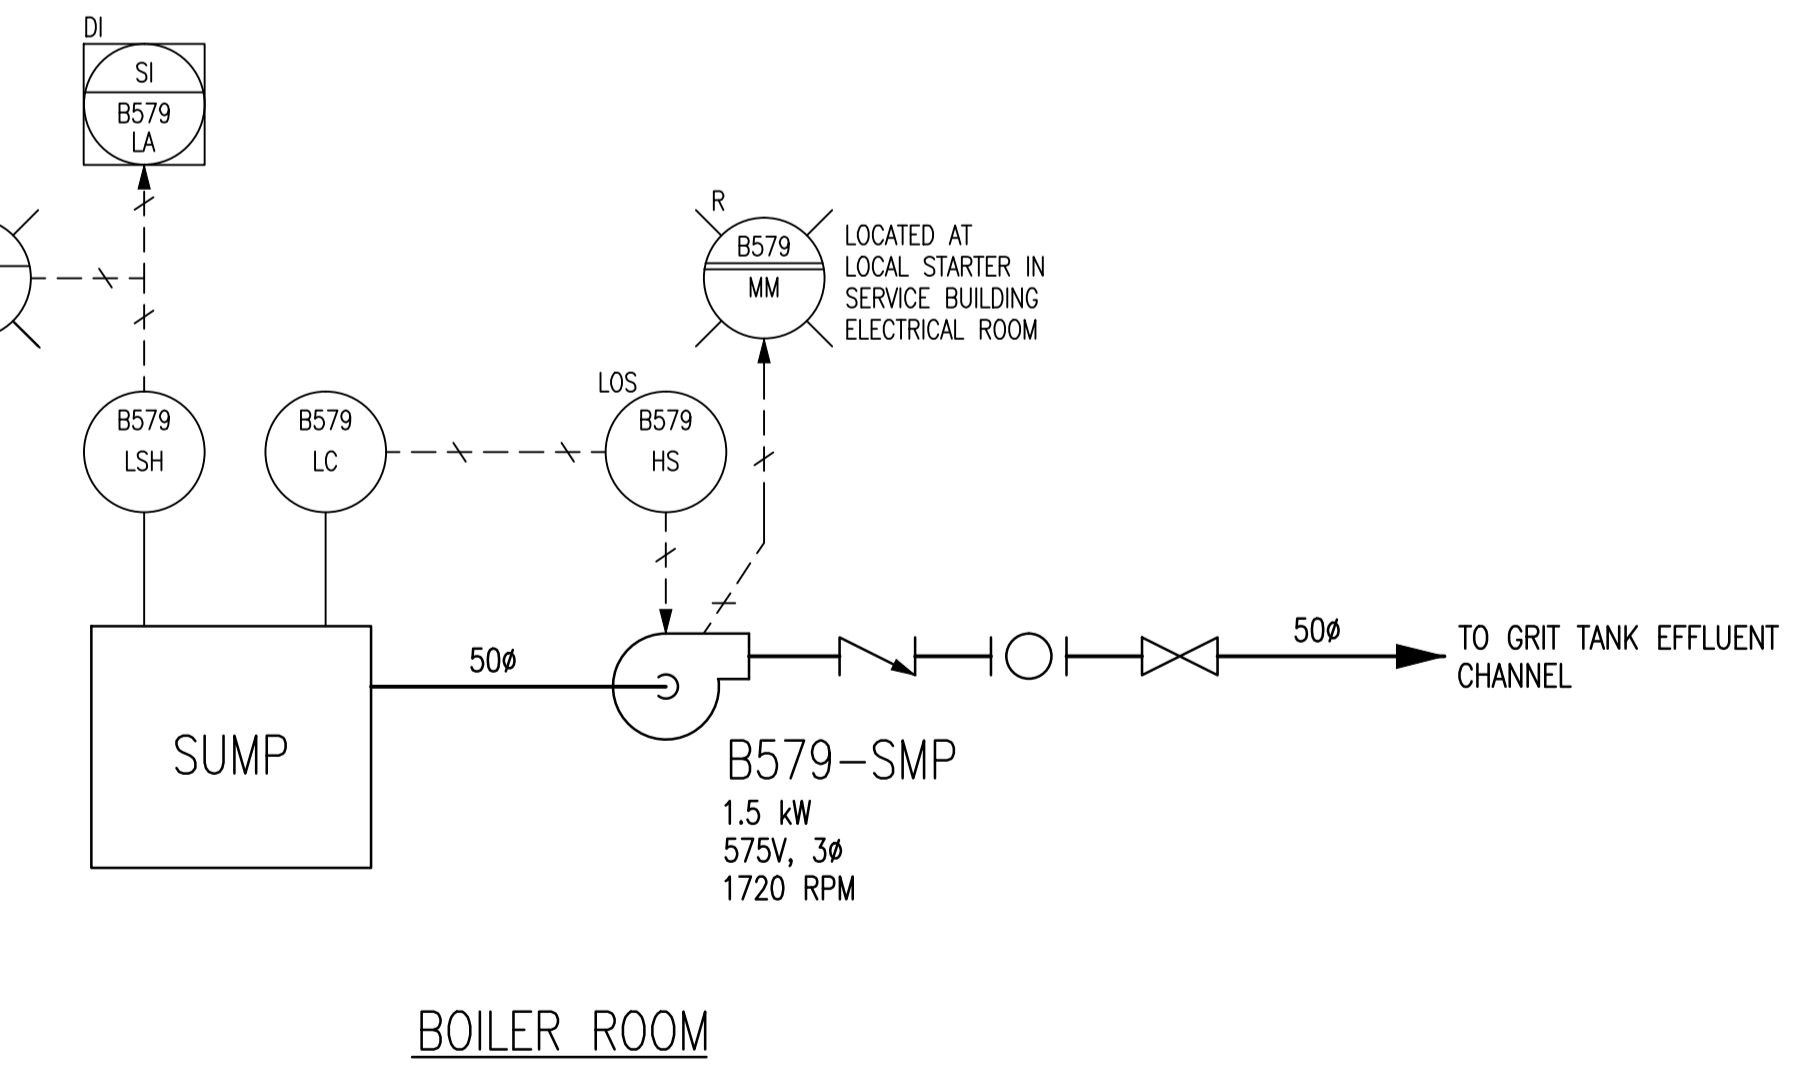
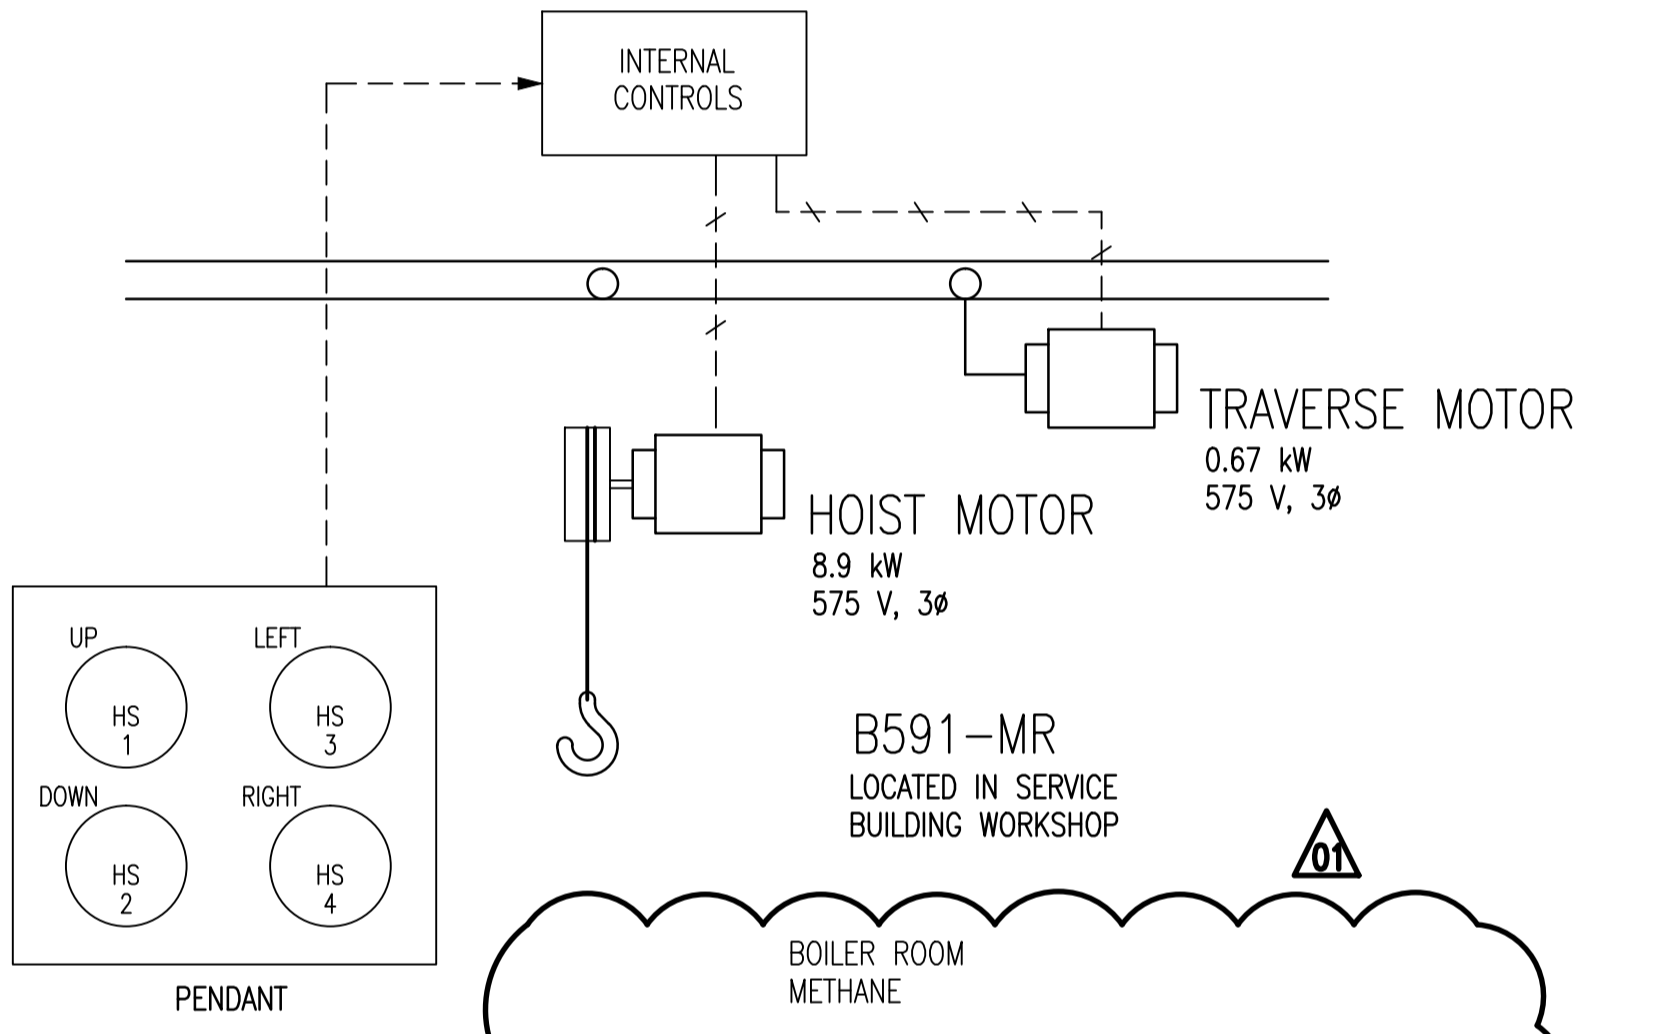
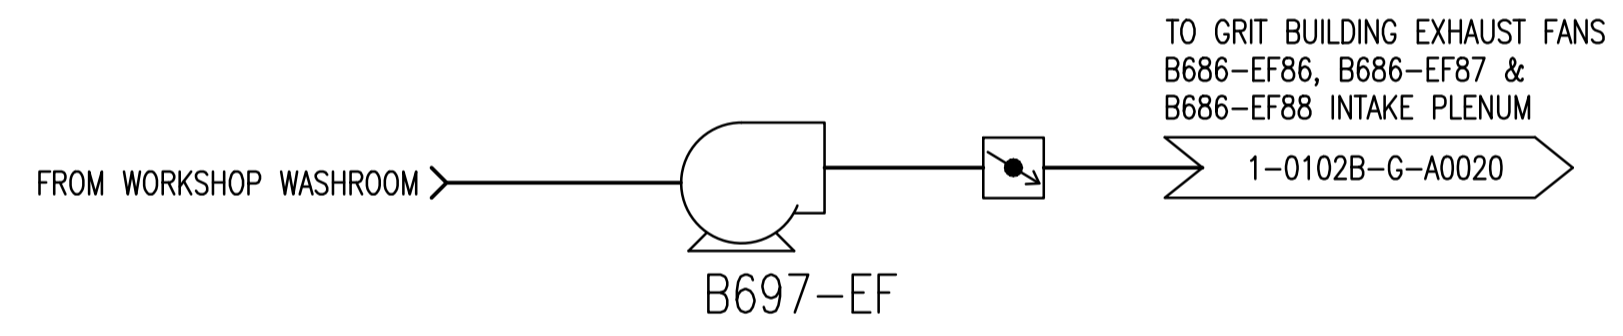
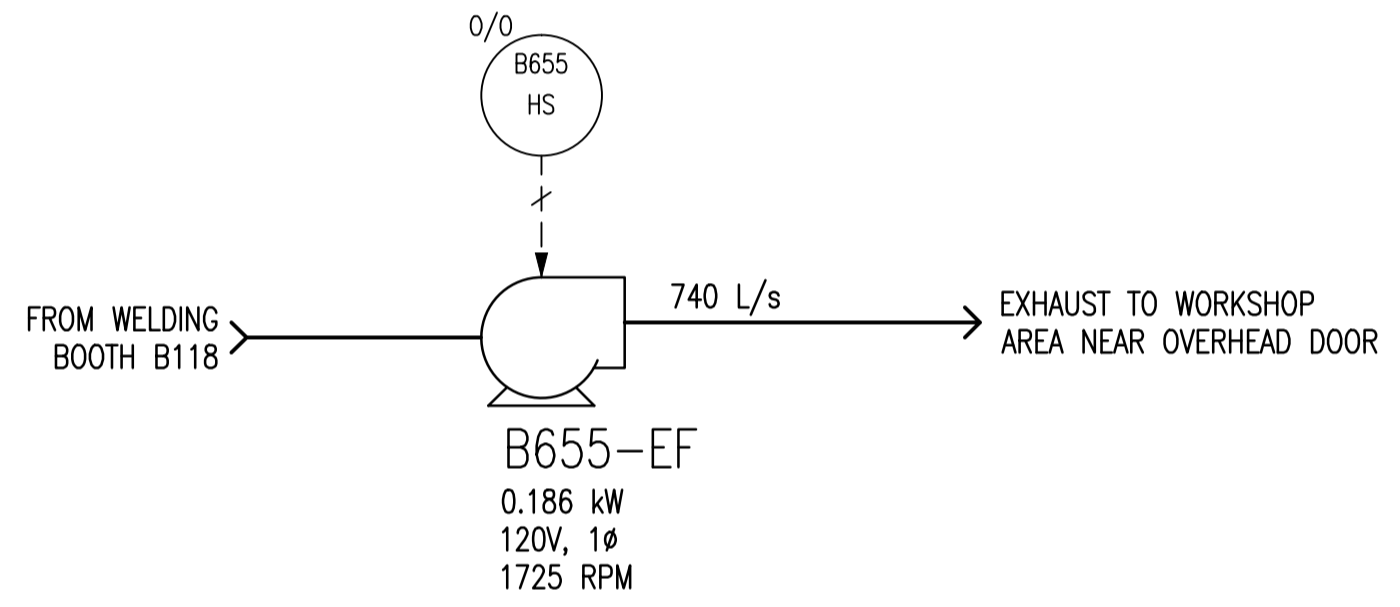


INCONSISTENCIES

- I-1 SMOKE DETECTOR B542-AE IS LABELLED AS B504-ZSD AT SITE.
- I-2 SMOKE DETECTORS B507-AE AND B508-AE ARE LABELLED AS B507-ZSD AND B508-ZSD RESPECTIVELY AT SITE.
- I-3 MOTION DETECTORS B505-XS AND B506-XS ARE CURRENTLY DESIGNATED AS B505-AE AND B506-AE RESPECTIVELY.

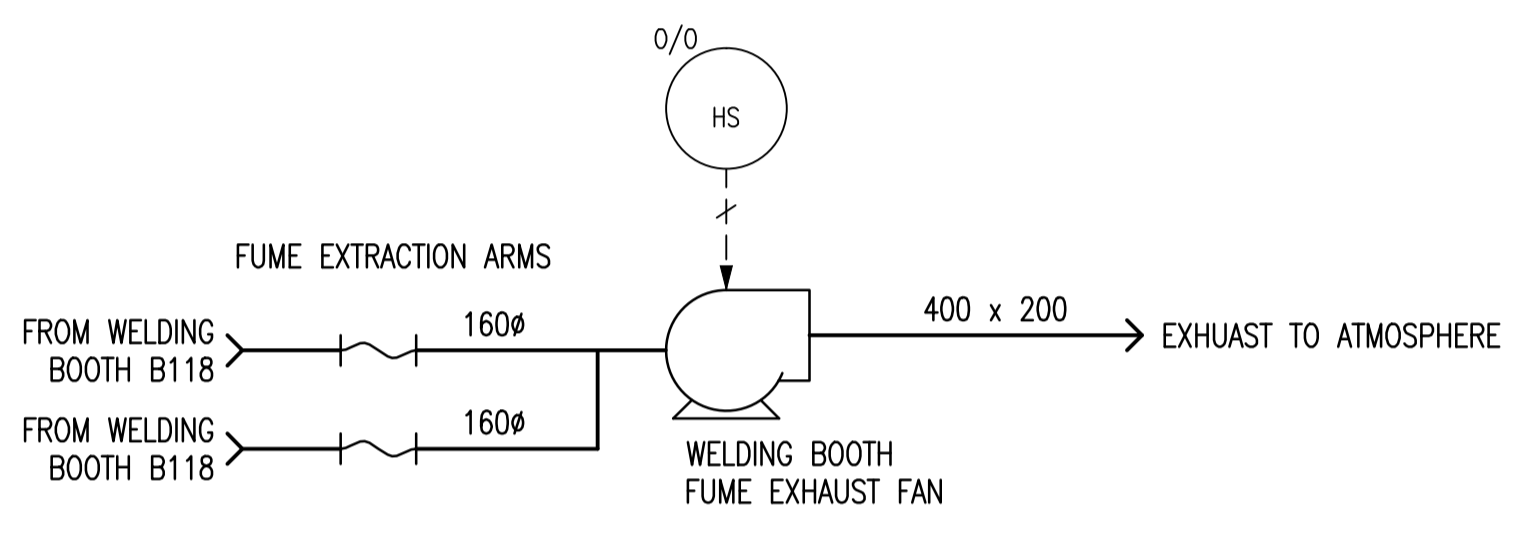

NOTES:
1. THIS DRAWING SUPERSEDES PORTIONS OF DRAWING SEP-919, SEP-921, SEP-922, AND SEP-925.

1-0102A-D-A0001	PROCESS & INSTRUMENT DIAGRAMS LEGEND & DETAILS
DRAWING NUMBER	REFERENCE DRAWINGS

NO.	REVISIONS	DATE	DESIGN	CHECK
01	ADDED GAS ALARM AND FIRE ALARM PANEL	2011/03/11	TMC	CJR
00	ISSUED FOR CITY USE	2007/02/26	-	EFB

		SNC-LAVALIN INC. 148 Nature Park Way Winnipeg, MB, Canada R3P 0X7 204-786-8080	
DESIGNED BY:	EXISTING	CHECKED BY:	EFB
DRAWN BY:	EFB	APPROVED BY:	CJR
SCALE:	NTS	RELEASED FOR CONSTRUCTION BY:	N. HARRINGTON
DATE:	2005/11/09	DATE:	2011/03/11
CONSULTANT NO.:	112577-0106-49DD-0009		

ENGINEER'S SEAL
ORIGINAL DRAWING SEALED BY:
T. M. CHURCH
SNC-LAVALIN MEMBER #32682
2011/03/25
REV. 01
CHANGES ONLY

		THE CITY OF WINNIPEG WATER AND WASTE DEPARTMENT					
SOUTH END WATER POLLUTION CONTROL CENTRE SERVICE BUILDING PROCESS & INSTRUMENTATION DIAGRAM MISCELLANEOUS							
CITY DRAWING NUMBER	1-0102B-A0024	SHEET	001	REV.	01	SIZE	D