




1/5 BUILDING SECTION

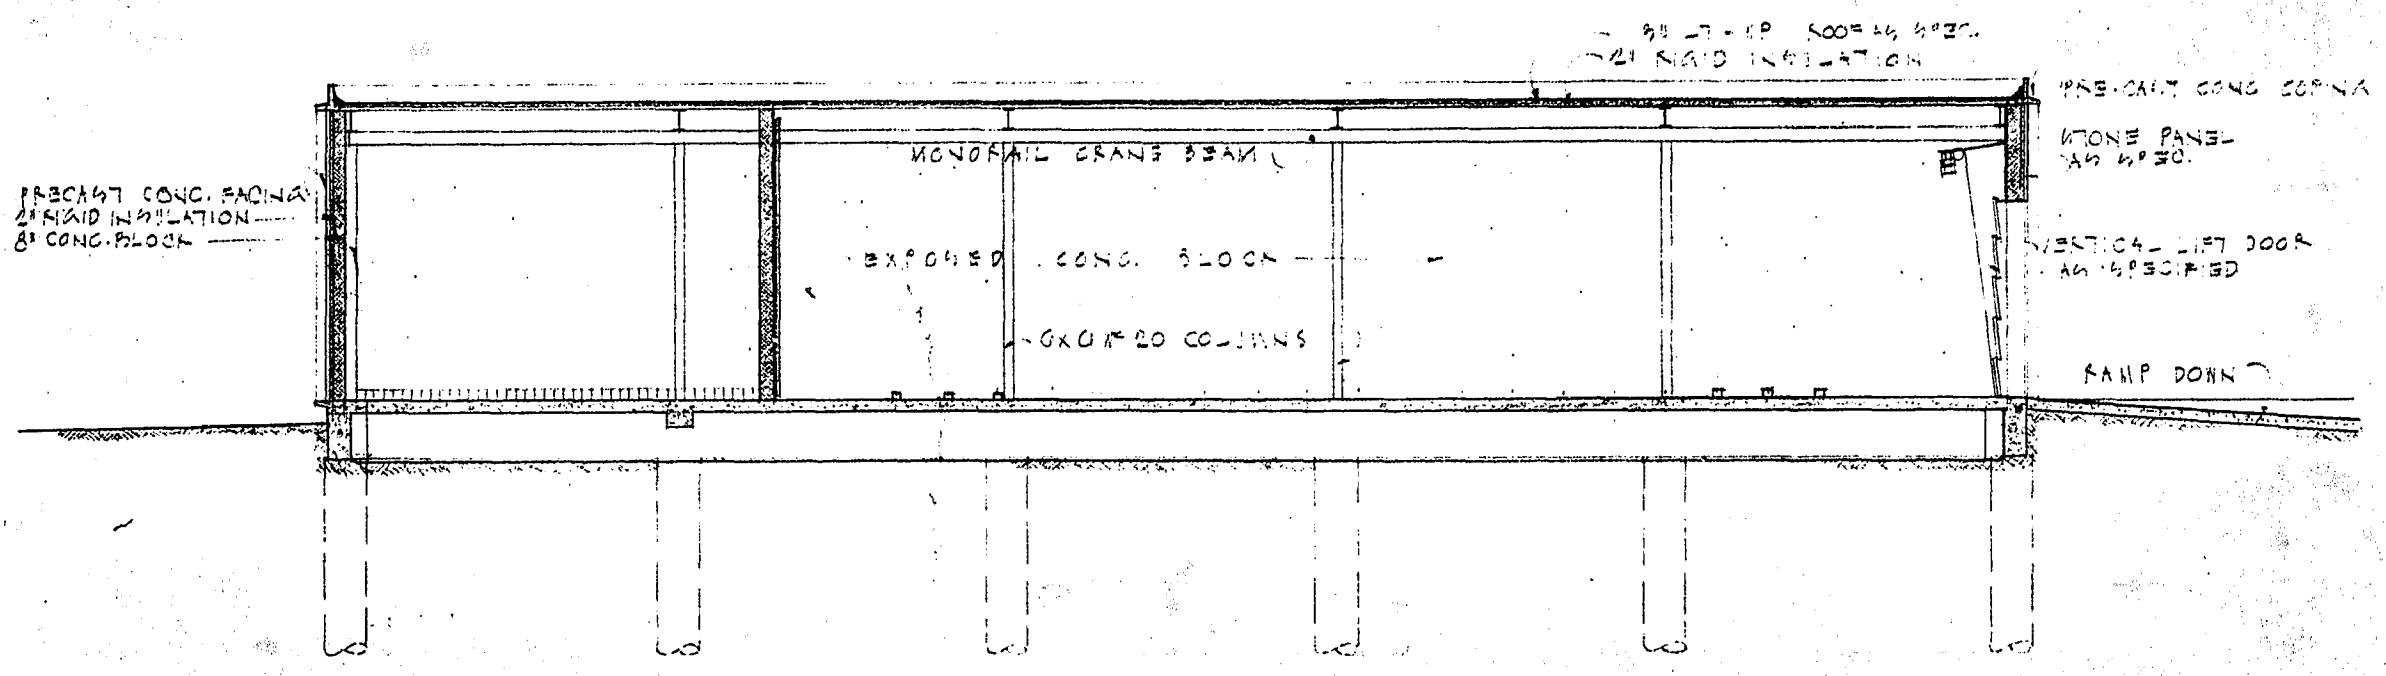

3/5 BUILDING SECTION

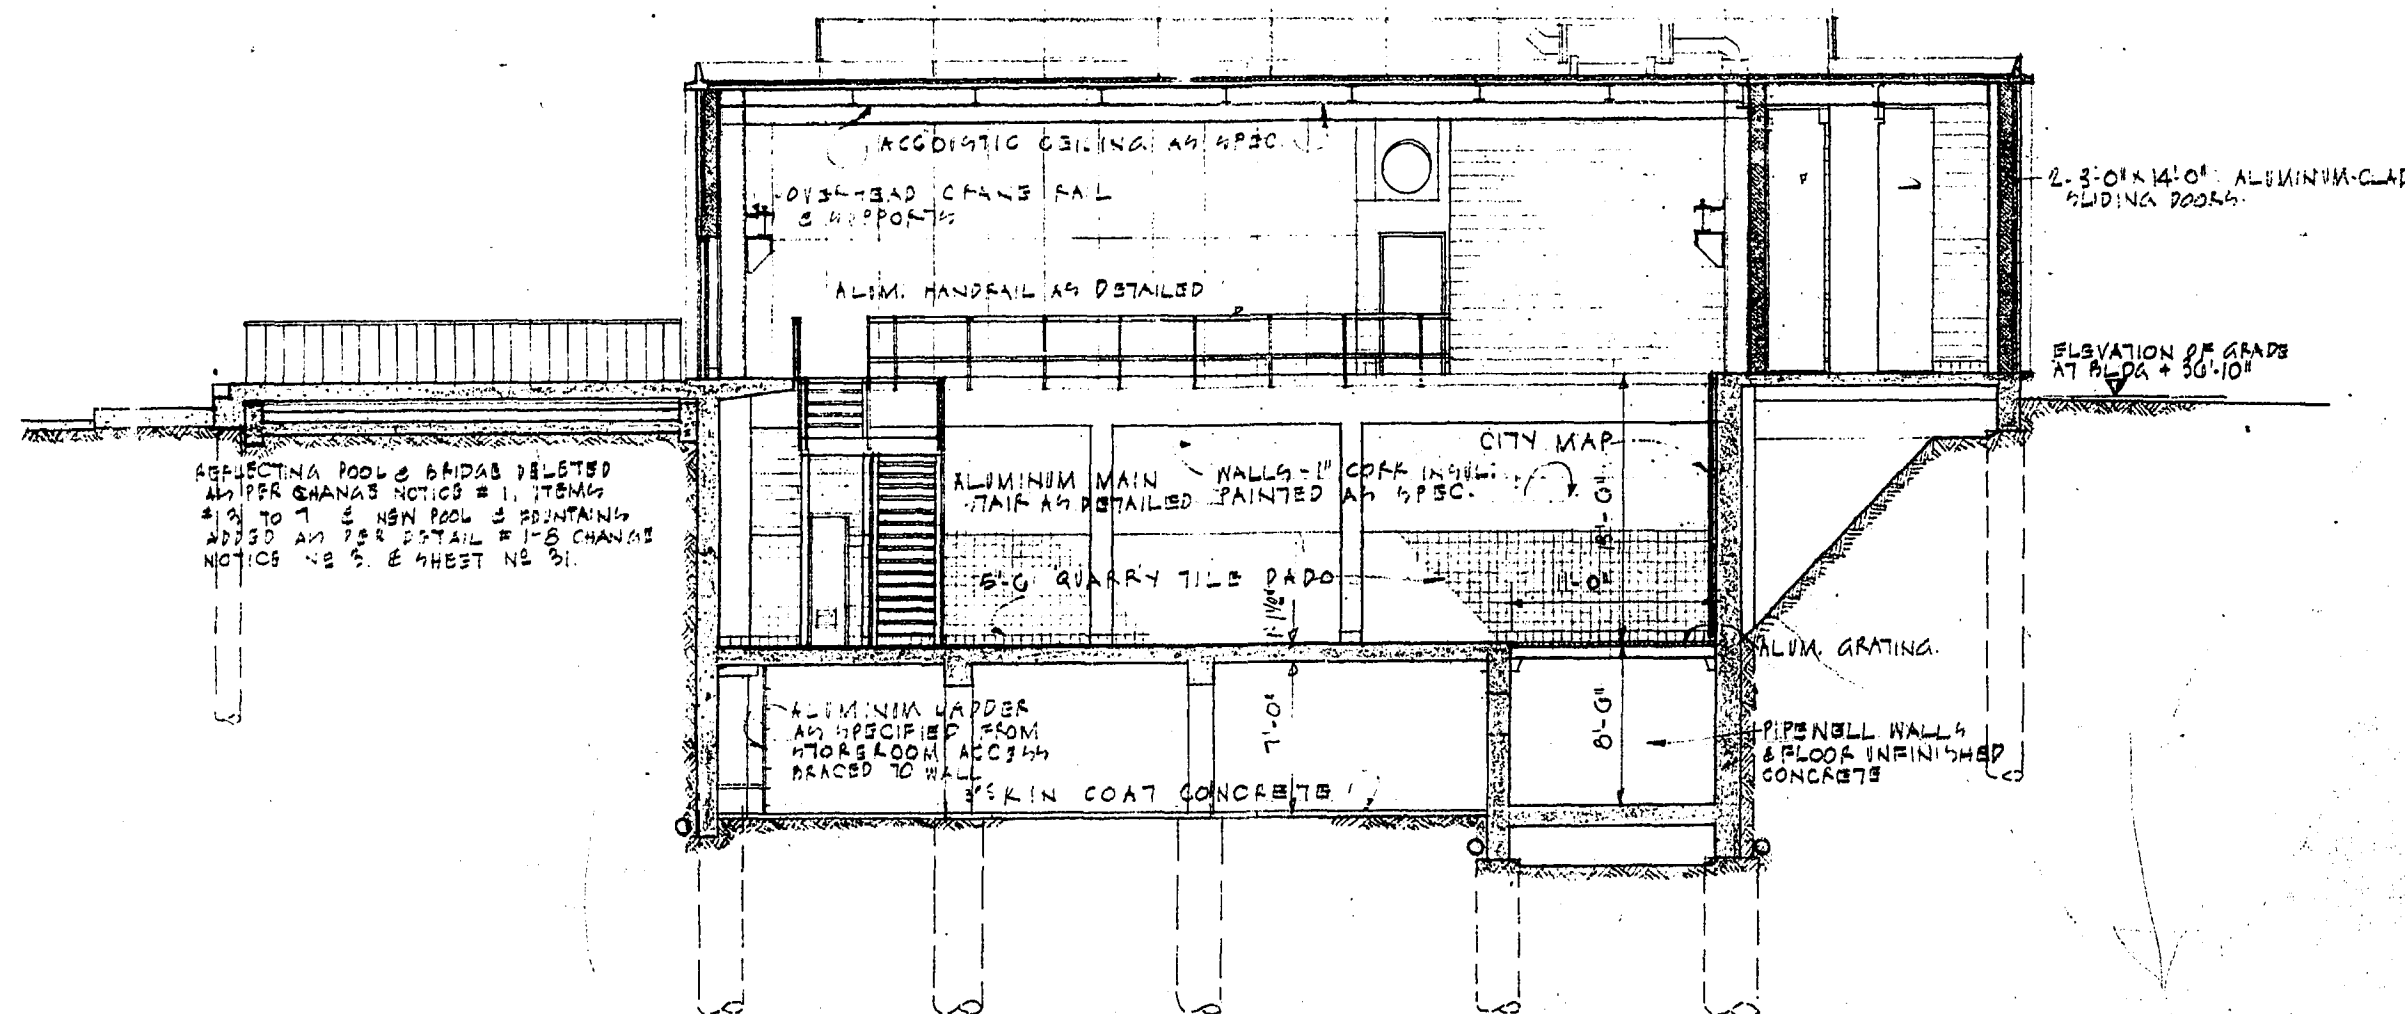

2/5 BUILDING SECTION

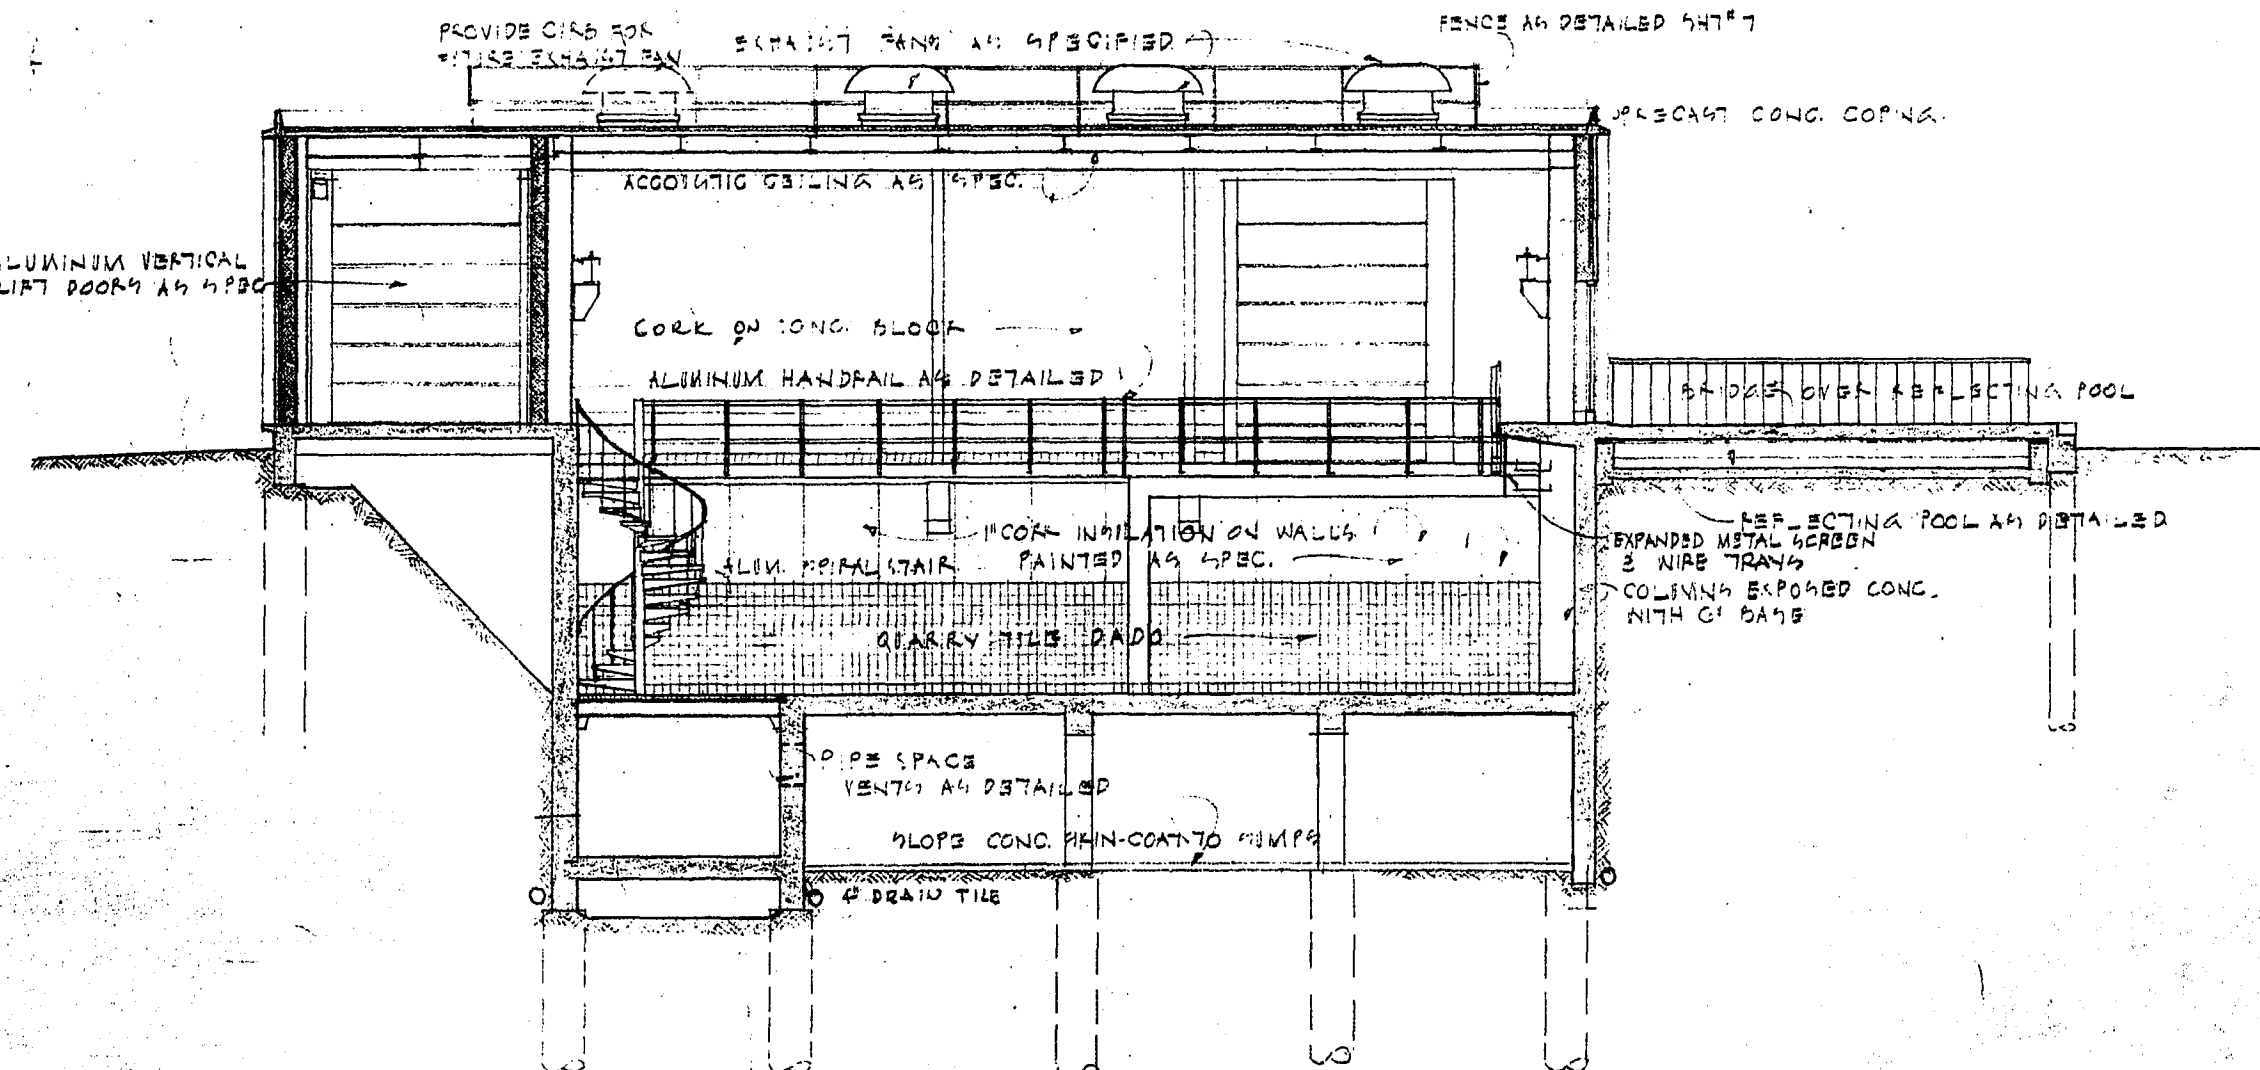

4/5 BUILDING SECTION

No.	REF.	DESCRIPTION	DATE	BY
1		CONC. ON WALLS	25.11.59	

REVISIONS (READ UP)

DRAWN BY
B. T.
CHECKED BY
APPROVED BY
DATE
NOV. 10, 1959
CITY FILE NO.
WH5622-5

Ernest Smith

SMITH CARTER SEARLE ASSOCIATES
ARCHITECTS AND ENGINEERS
WINNIPEG AND BRANDON
CITY OF WINNIPEG
WILKES AVE. PUMPING STATION
WINNIPEG, MANITOBA
BUILDING SECTIONS
SCALE:
1/8" = 1'-0"
FILE NUMBER 59151 SHEET NUMBER 5