


- NOTES:
- MAKE PIPING CONNECTIONS TO EXISTING Ø250 mm CR. NEW CONDENSER PIPING FROM THIS POINT AND BETWEEN CH-3 AND INDIRECT HOT WATER TANKS TO BE INSULATED.
  - MAKE PIPING CONNECTIONS TO EXISTING Ø250 mm CHWR.
  - CH-1 & CH-2 TRANSFORMERS. SUPPLIED WITH CHILLERS (DIV 23) AND ELECTRICAL WIRING BY DIVISION 26.
  - Ø 40 CR PIPES TO HP-1. SEE DETAIL FOR REMAINING PIPE CONNECTIONS.
  - NEW PIPE TO TIE INTO EXISTING Ø250 mm CS PIPE FROM BELOW.
  - NEW CHEMICAL TREATMENT SYSTEM MOUNTED ON COLUMN AS SHOWN IN PHOTO 'A'. NEW SS Ø 20 PIPE FROM CHEMICAL TREATMENT SYSTEM PANEL TO EXISTING INJECTION POINT ABOVE ON Ø 250 CR PIPE.
  - REPLACE EXISTING POT FEEDER, MICRON FILTER AND REPLACE EXISTING Ø 20 PIPE WITH NEW Ø 25 PIPE WITH TWO TIE-IN POINTS IN CHWR. REFER TO PHOTO ON DWG. M-002 FOR NEW WORK.
  - CHECK ALL TRIPLE DUTY VALVES (TYP. OF 4) TO ENSURE CHECK VALVES HOLD.
  - FIRE STOPPING REQUIRED AT ALL WALL PENETRATIONS INTO FUEL STORAGE ROOM.
  - NEW Ø 20 INJECTION PIPE FROM CHEMICAL TREATMENT SYSTEM PANEL TO TIE INTO EXISTING Ø 250 CS PIPE AT THIS LOCATION.

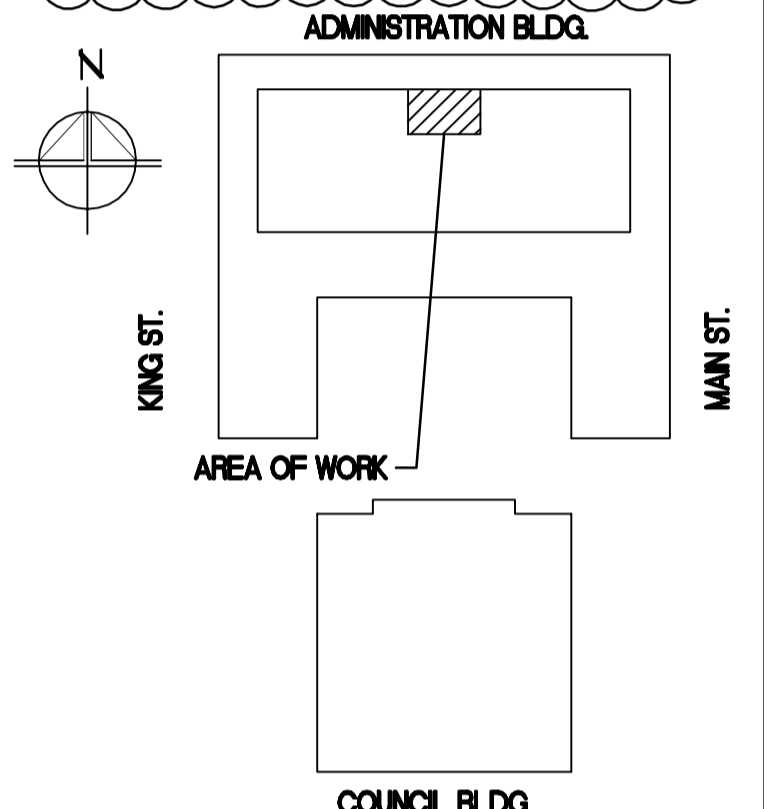

**AECOM**

This drawing has been prepared for the use of AECOM's client and may not be used, reproduced or relied upon by third parties, except as agreed by AECOM and its client, as required by law or for use by governmental reviewing agencies. AECOM accepts no responsibility, and denies any liability whatsoever, to any party that modifies this drawing without AECOM's express written consent. Do not scale this document. All measurements must be obtained from stated dimensions.

No.	REVISION/DESCRIPTION	BY	DATE
1	ISSUED FOR ADDENDUM 1	DL	2011.11.16
0	ISSUED FOR TENDER	GT	2011.11.03

DRAWN	GT	CHECKED	DC	DESIGNED	DC	APPROVED	PVL
DATE	2011.09.02	USER					

Winnipeg  
 THE CITY OF WINNIPEG  
 PLANNING, PROPERTY AND  
 DEVELOPMENT DEPARTMENT  
 MUNICIPAL ACCOMMODATIONS DIVISION  
 3-65 GARRY STREET, R3C 4K4

PROJECT  
 ADMINISTRATION & COUNCIL BUILDING  
 REPLACEMENT OF COOLING PLANT - 510 MAIN STREET  
 BID OPPORTUNITY NO. 673-2011  
 510 MAIN STREET, WINNIPEG, MANITOBA

SHEET TITLE  
 MECHANICAL  
 SUB-BASEMENT MECHANICAL ROOM  
 HYDRONIC PLAN

SCALE	PROJECT No:	SHEET No:
NTS	60220937	M-003



- REMOVE EXISTING PUMP AND UNISTRUT
- REMOVE EXISTING CONTROL PANEL. (REUSE EXISTING MAKE-UP METER WIRING)
- LOCATE NEW PACKAGED CHEMICAL TREATMENT SYSTEM PANEL ON COLUMN.
- LOCATE NEW BATCH TANKS UNDER NEW PANEL
- TURN OVER EXISTING BATCH TANK TO CITY

PHOTO  
 SCALE: NTS  
 CHEMICAL TREATMENT SYSTEM

**APEGM**  
 Certificate of Authorization  
 AECOM Canada Ltd.  
 No. 4671 Date: \_\_\_\_\_

DRN	CHK	DES	ENG	IDR

AECOM REVIEW

PLAN  
 SCALE 1:50  
 SUB-BASEMENT HYDRONIC PLAN