


1
PROPOSED PLAN OSBORNE STREET BRIDGE
 1:250
 -REFER TO ROADWORK DRAWINGS FOR HORIZONTAL GEOMETRY

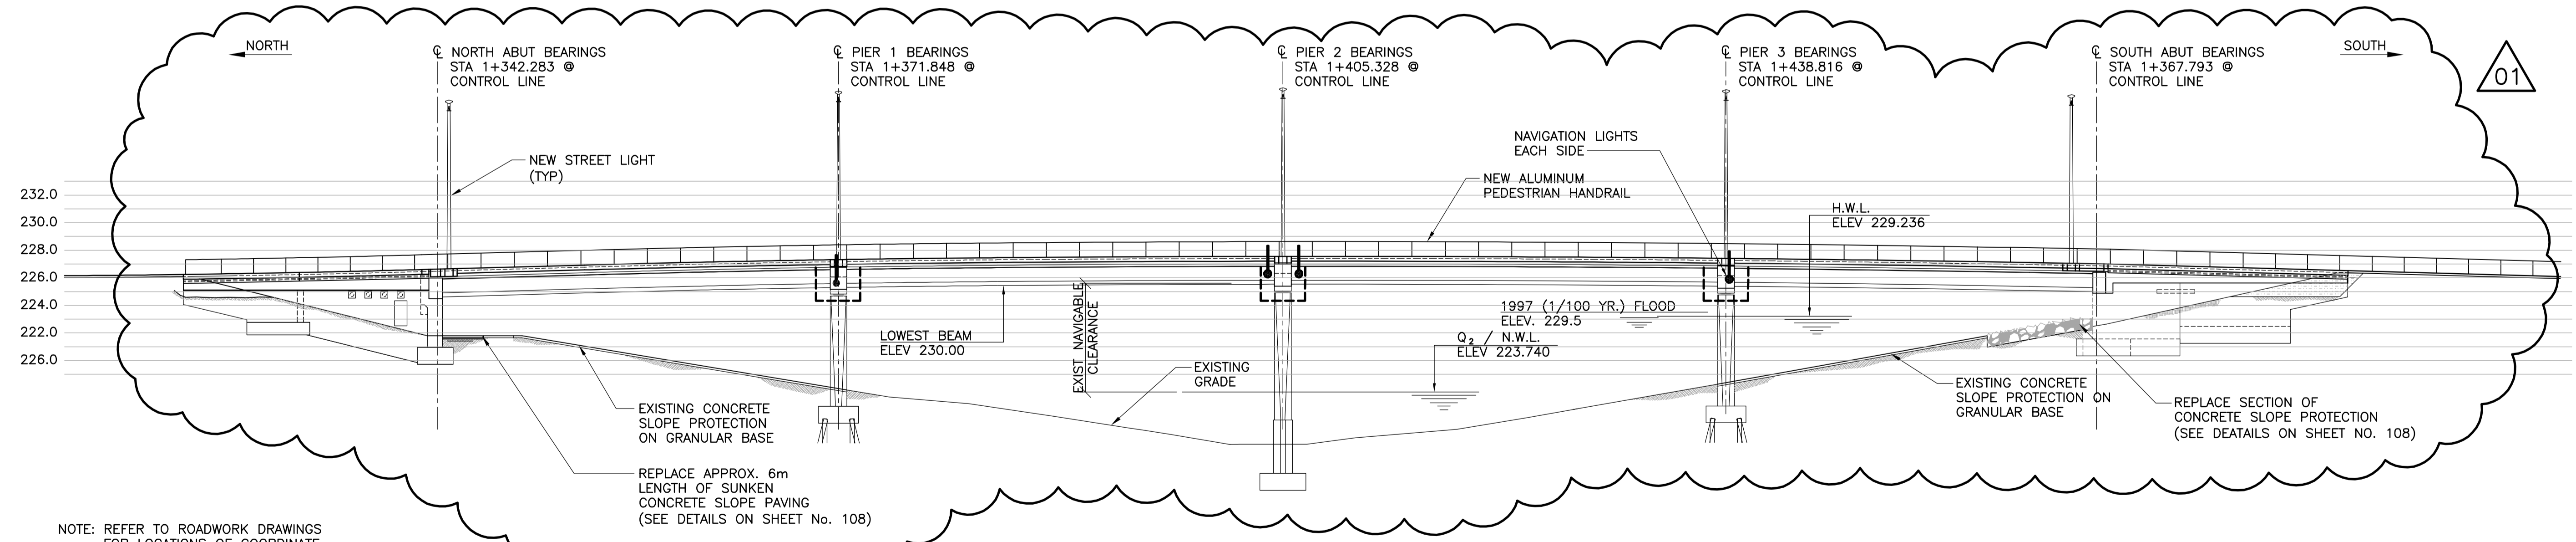

2
LONGITUDINAL BRIDGE SECTION
 1:250

NOTE: REFER TO ROADWORK DRAWINGS FOR LOCATIONS OF COORDINATE CONTROL SURVEY MONUMENTS



| B.M. ELEV. | F.B. | DATE | BY |
|------------|-----------------------|----------|----|
| 01 | ISSUED FOR ADDENDUM 1 | 11.03.07 | VB |
| 00 | ISSUED FOR TENDER | 11.02.18 | VB |
| NO. | REVISIONS | DATE | BY |

WARDROP
 A TETRA TECH COMPANY

DESIGNED BY: S.Y. CHECKED BY: V.B.
 DRAWN BY: B.M. APPROVED BY: R.H.W.

HOR. SCALE: AS NOTED DATE: 10.10.20
 VERTICAL: AS NOTED DATE: 11.02.16

RELEASED FOR CONSTRUCTION ORIGINAL SIGNED: MATT CHELSETT, P. ENG. BRIDGE PROJECTS ENGINEER



THE CITY OF WINNIPEG
 PUBLIC WORKS DEPARTMENT
 ENGINEERING DIVISION

OSBORNE STREET BRIDGE
 REHABILITATION & RELATED WORKS

GENERAL ARRANGEMENT
 PLAN AND ELEVATION

CITY DRAWING NUMBER: B109-11-009
 SHEET 4 OF 131

CONSULTANT DRAWING NO.: 0900070502-DWG-S0004