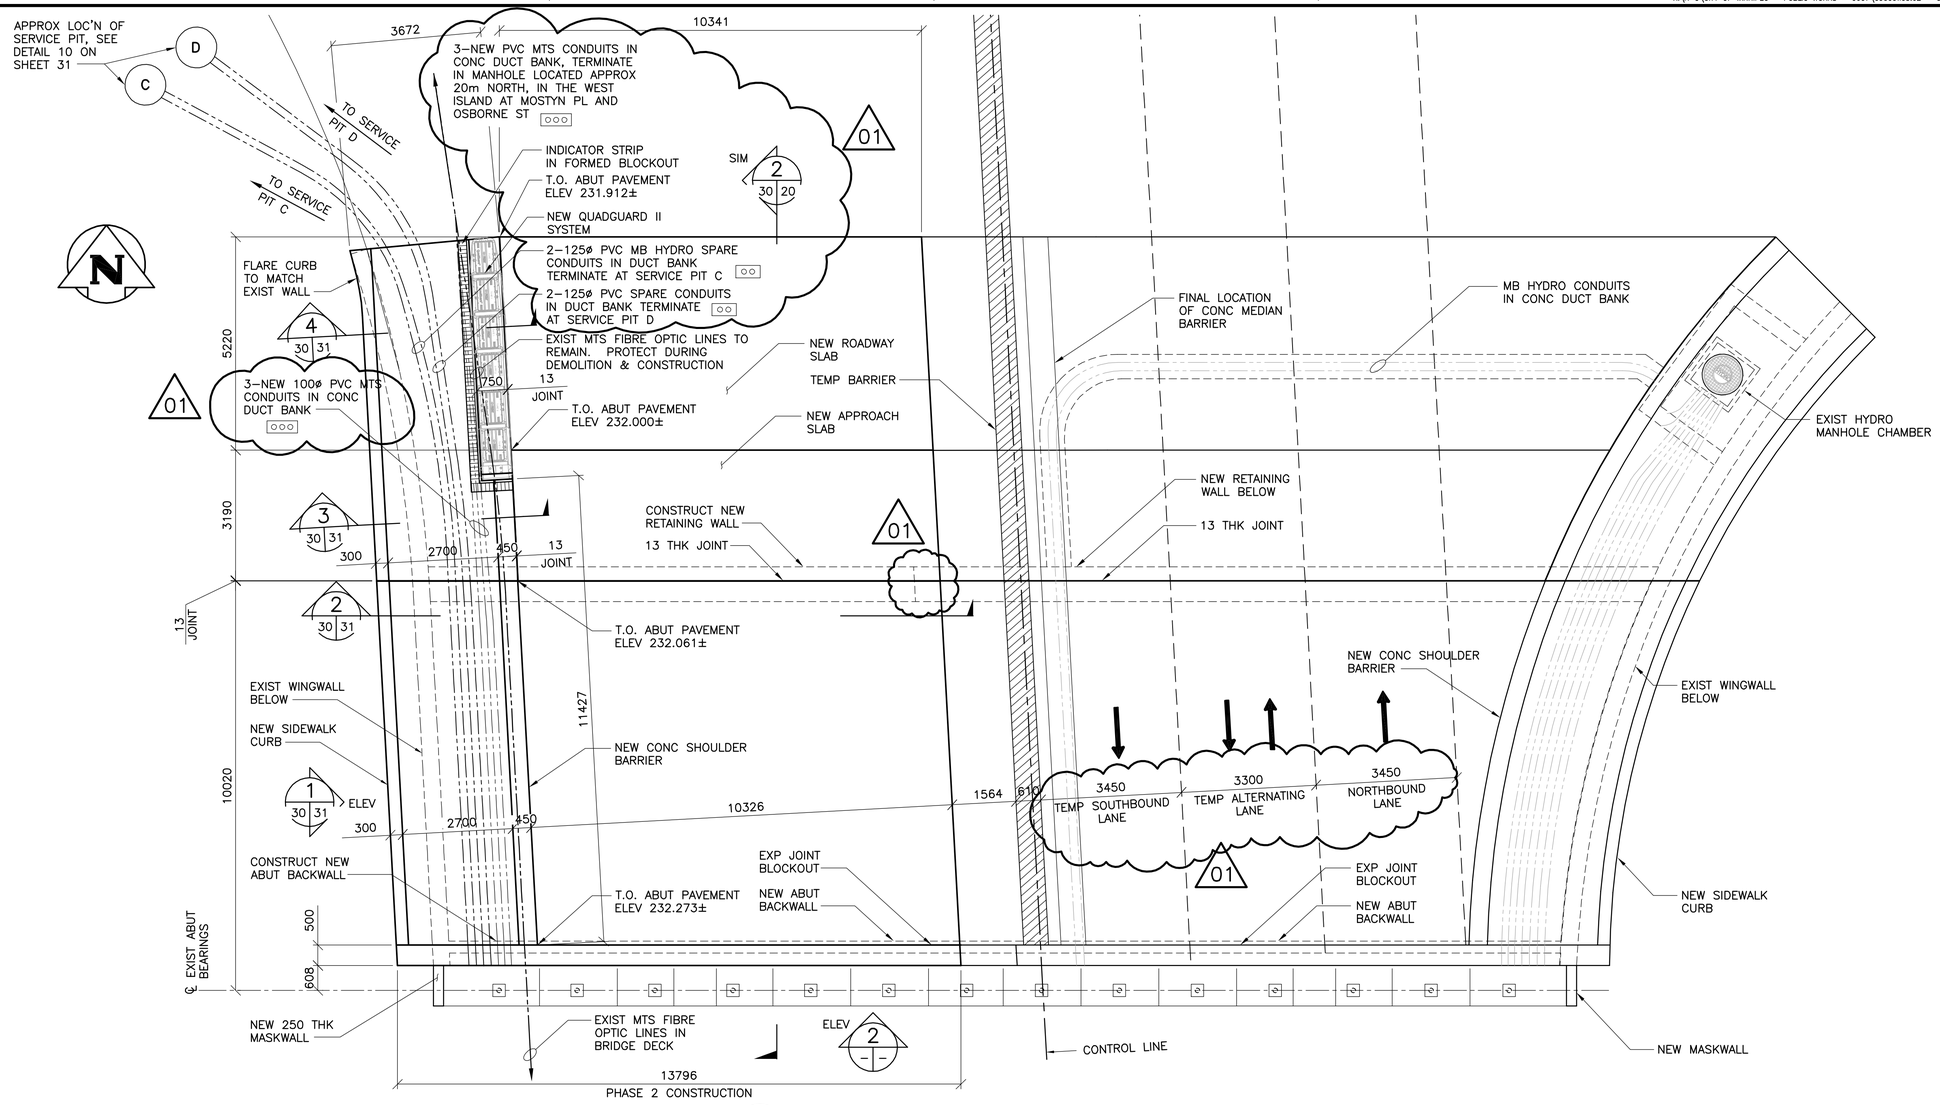

1 — PLAN – NORTH ABUTMENT PHASE 2 CONSTRUCTION

1 : 75

– CONTRACTOR IS RESPONSIBLE TO LOCATE, PROTECT AND UNDERTAKE ALL WORKS WITHOUT DAMAGING THE EXISTING MTS FIBRE OPTIC LINES OR CONC DUCT BANK WITH THE FIBRE OPTIC LINES

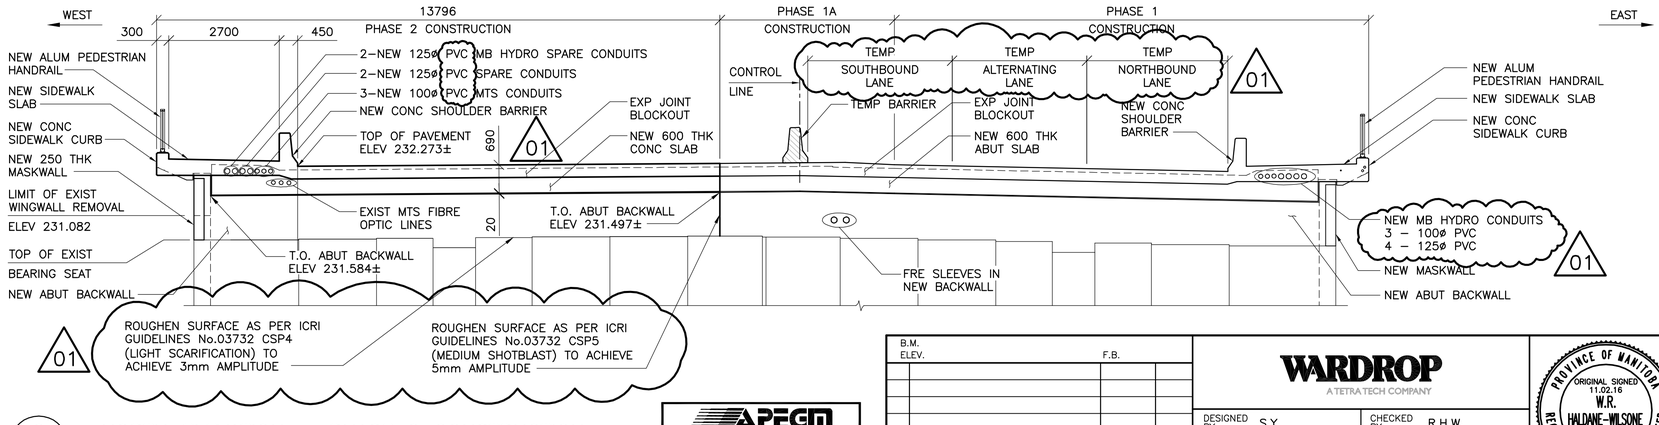

2 — NORTH ELEVATION – PHASE 2 CONSTRUCTION

1 : 75

– EXIST GIRDERS NOT SHOWN FOR CLARITY

APEGM Certificate of Authorization Wardrop Engineering Inc. No. 195 Date: April 30, 2011

NO.	REVISIONS	DATE	BY
01	ISSUED FOR ADDENDUM 1	11.03.07	RHW
00	ISSUED FOR TENDER	11.02.18	RHW

B.M. ELEV. F.B.

WARDROP A TETRA TECH COMPANY

DESIGNED BY S.Y. CHECKED BY R.H.W.
DRAWN BY B.M. APPROVED BY R.H.W.
HOR. SCALE: AS NOTED
VERTICAL:
RELEASED FOR CONSTRUCTION ORIGINAL SIGNED DATE 11.02.16
DATE 10.10.20
MATT CHISLETT, P.ENG BRIDGE PROJECTS ENGINEER

PROVINCE OF MANITOBA ORIGINAL SIGNED 11.02.16 W.R. HALDANE-WILSONE REGISTERED PROFESSIONAL ENGINEER

CONSULTANT DRAWING NO. 0900070502-DWG-S0030

Winnipeg

THE CITY OF WINNIPEG
PUBLIC WORKS DEPARTMENT
ENGINEERING DIVISION

OSBORNE STREET BRIDGE
REHABILITATION & RELATED WORKS

CITY DRAWING NUMBER B109-11-035
SHEET 30 OF 131

NORTH ABUTMENT AND APPROACH SLAB PHASE 2 CONSTRUCTION

30