




1 TYPICAL SECTION - PHASE 1 DECK CONSTRUCTION  
1 : 50

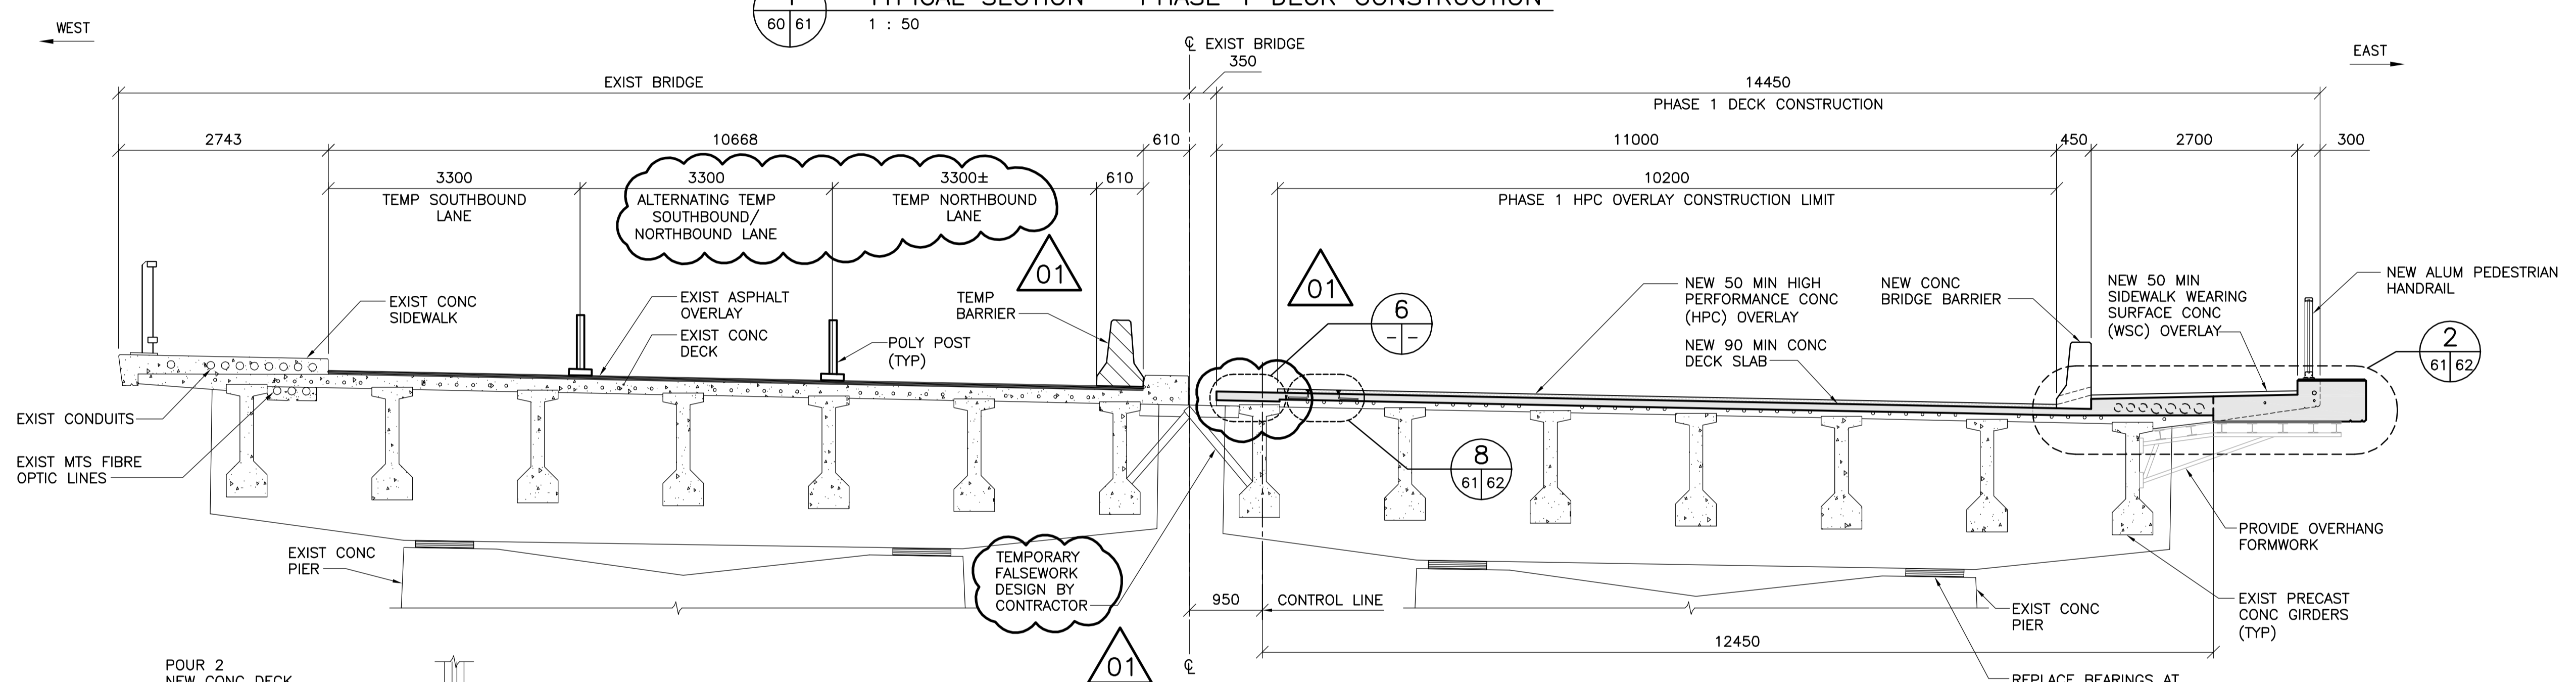

2 SECTION - AT PIER LOCATIONS  
1 : 50

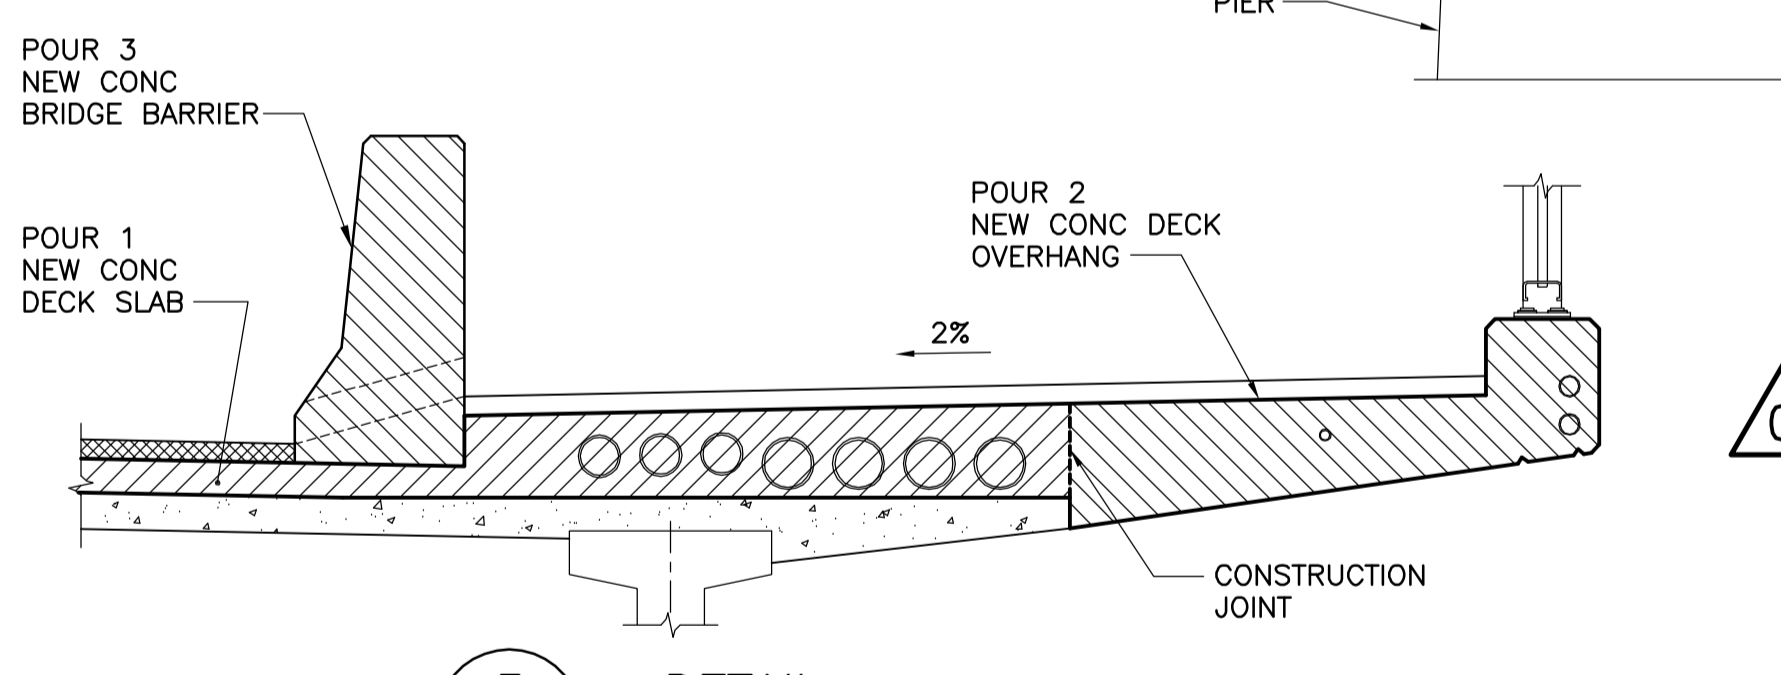


3 DETAIL  
1 : 20  
- THE CONTRACTOR MAY VARY FROM THE SEQUENCE SHOWN ABOVE ONLY IF APPROVED BY CONTRACT ADMINISTRATOR

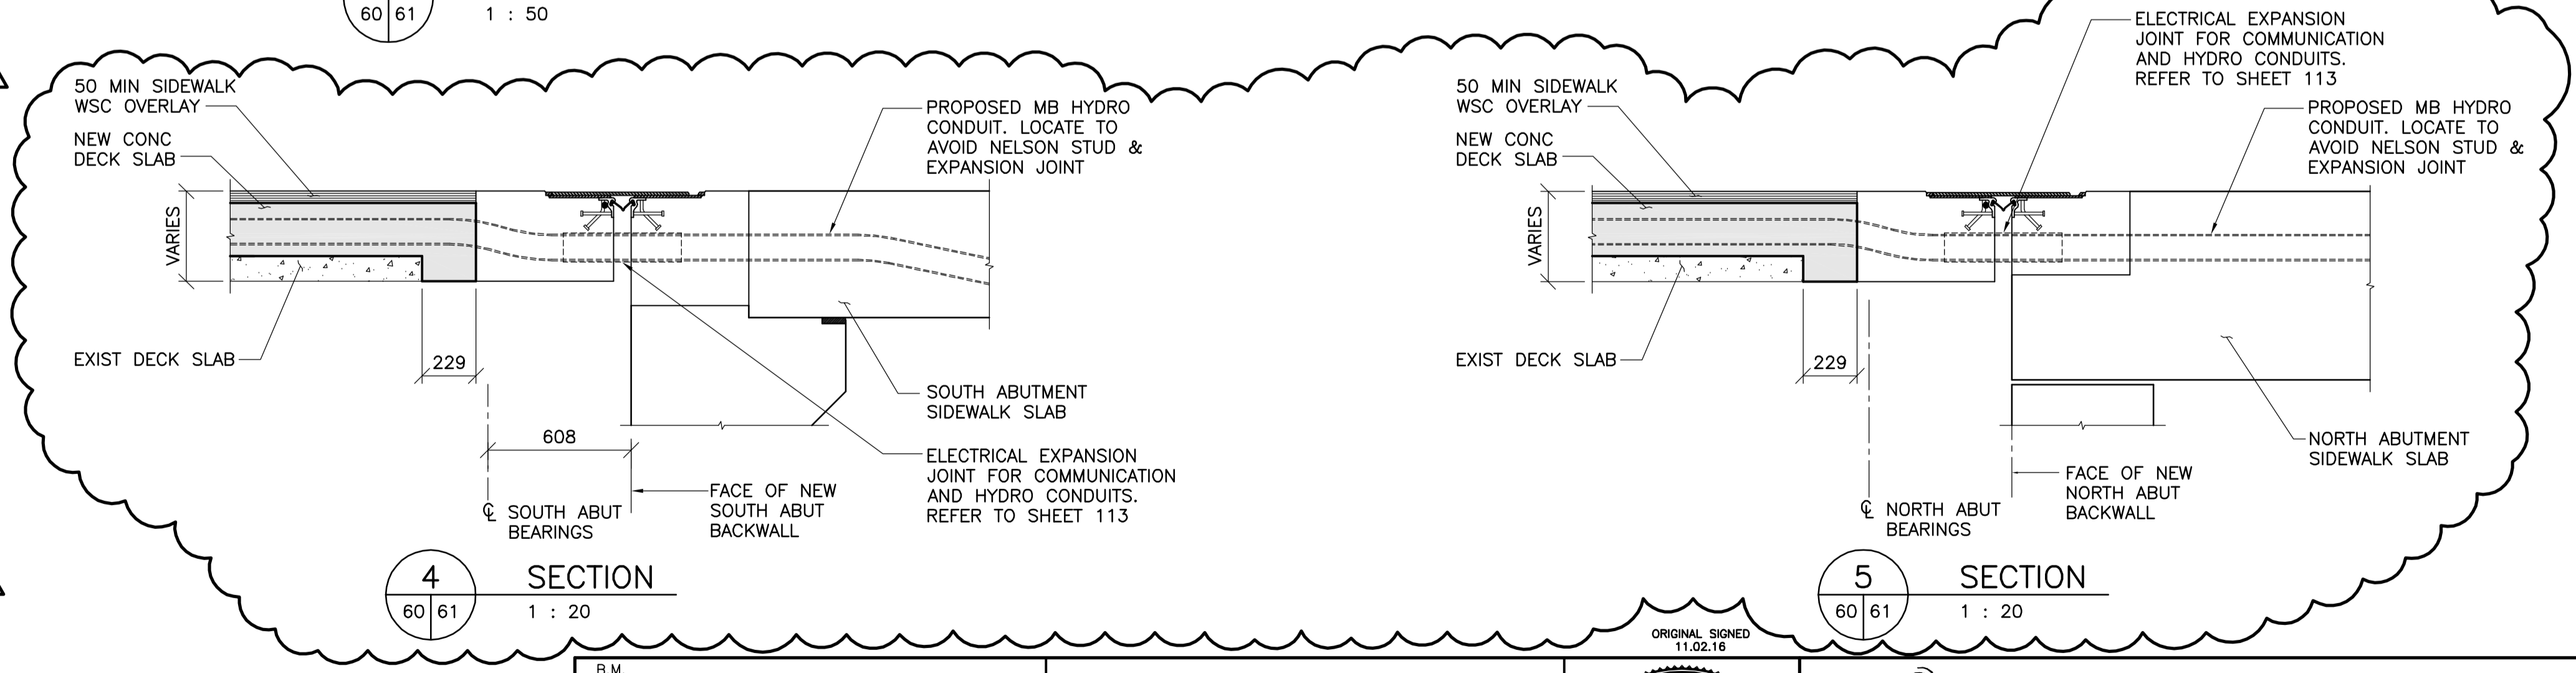

4 SECTION  
1 : 20

5 SECTION  
1 : 20

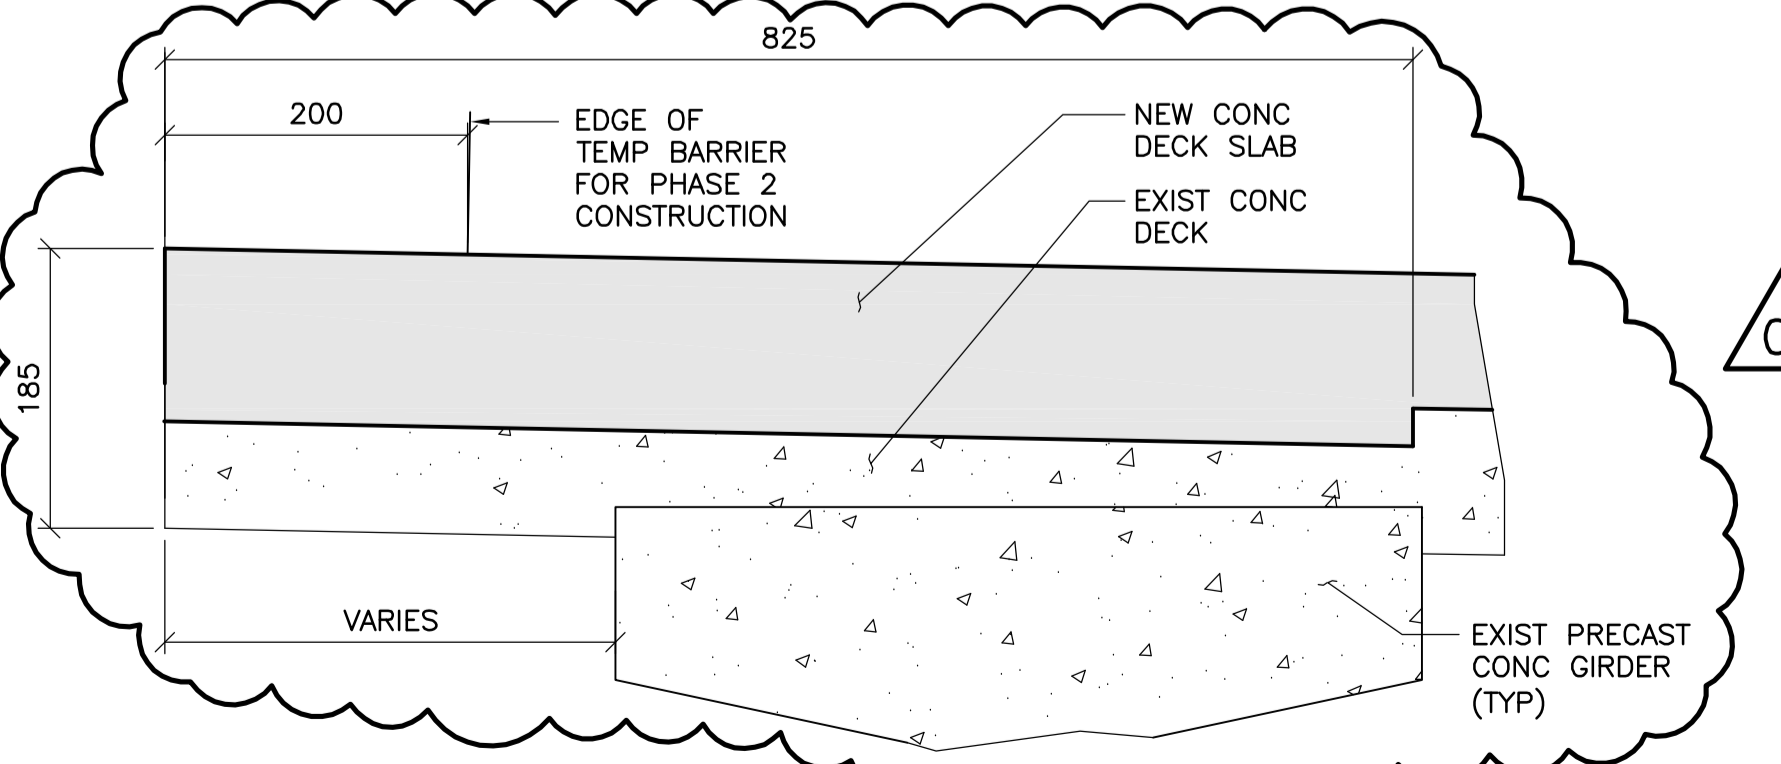


6 DETAIL  
1 : 5



NO.	REVISIONS	DATE	BY
01	ISSUED FOR ADDENDUM 1	11.03.07	EFS
00	ISSUED FOR TENDER	11.02.18	EFS

<b>WARDROP</b> ATETRA TECH COMPANY	
DESIGNED BY: V.B.	CHECKED BY: E.F.S.
DRAWN BY: B.M.	APPROVED BY: R.H.W.
HOR. SCALE: AS NOTED	RELEASED FOR CONSTRUCTION: ORIGINAL SIGNED 11.02.18
VERTICAL: AS NOTED	DATE: 10.10.13

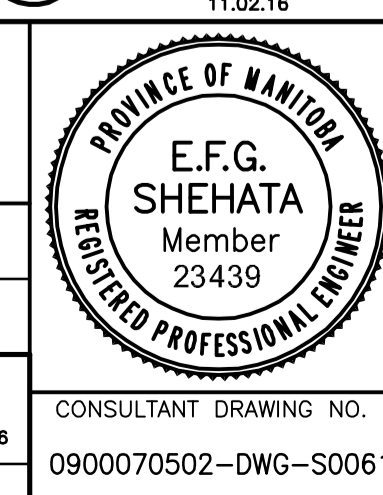

<b>THE CITY OF WINNIPEG</b> PUBLIC WORKS DEPARTMENT ENGINEERING DIVISION	
OSBORNE STREET BRIDGE REHABILITATION & RELATED WORKS	CITY DRAWING NUMBER B109-11-066 SHEET OF 61 131
BRIDGE DECK - PHASE 1 CONSTRUCTION	<b>61</b>