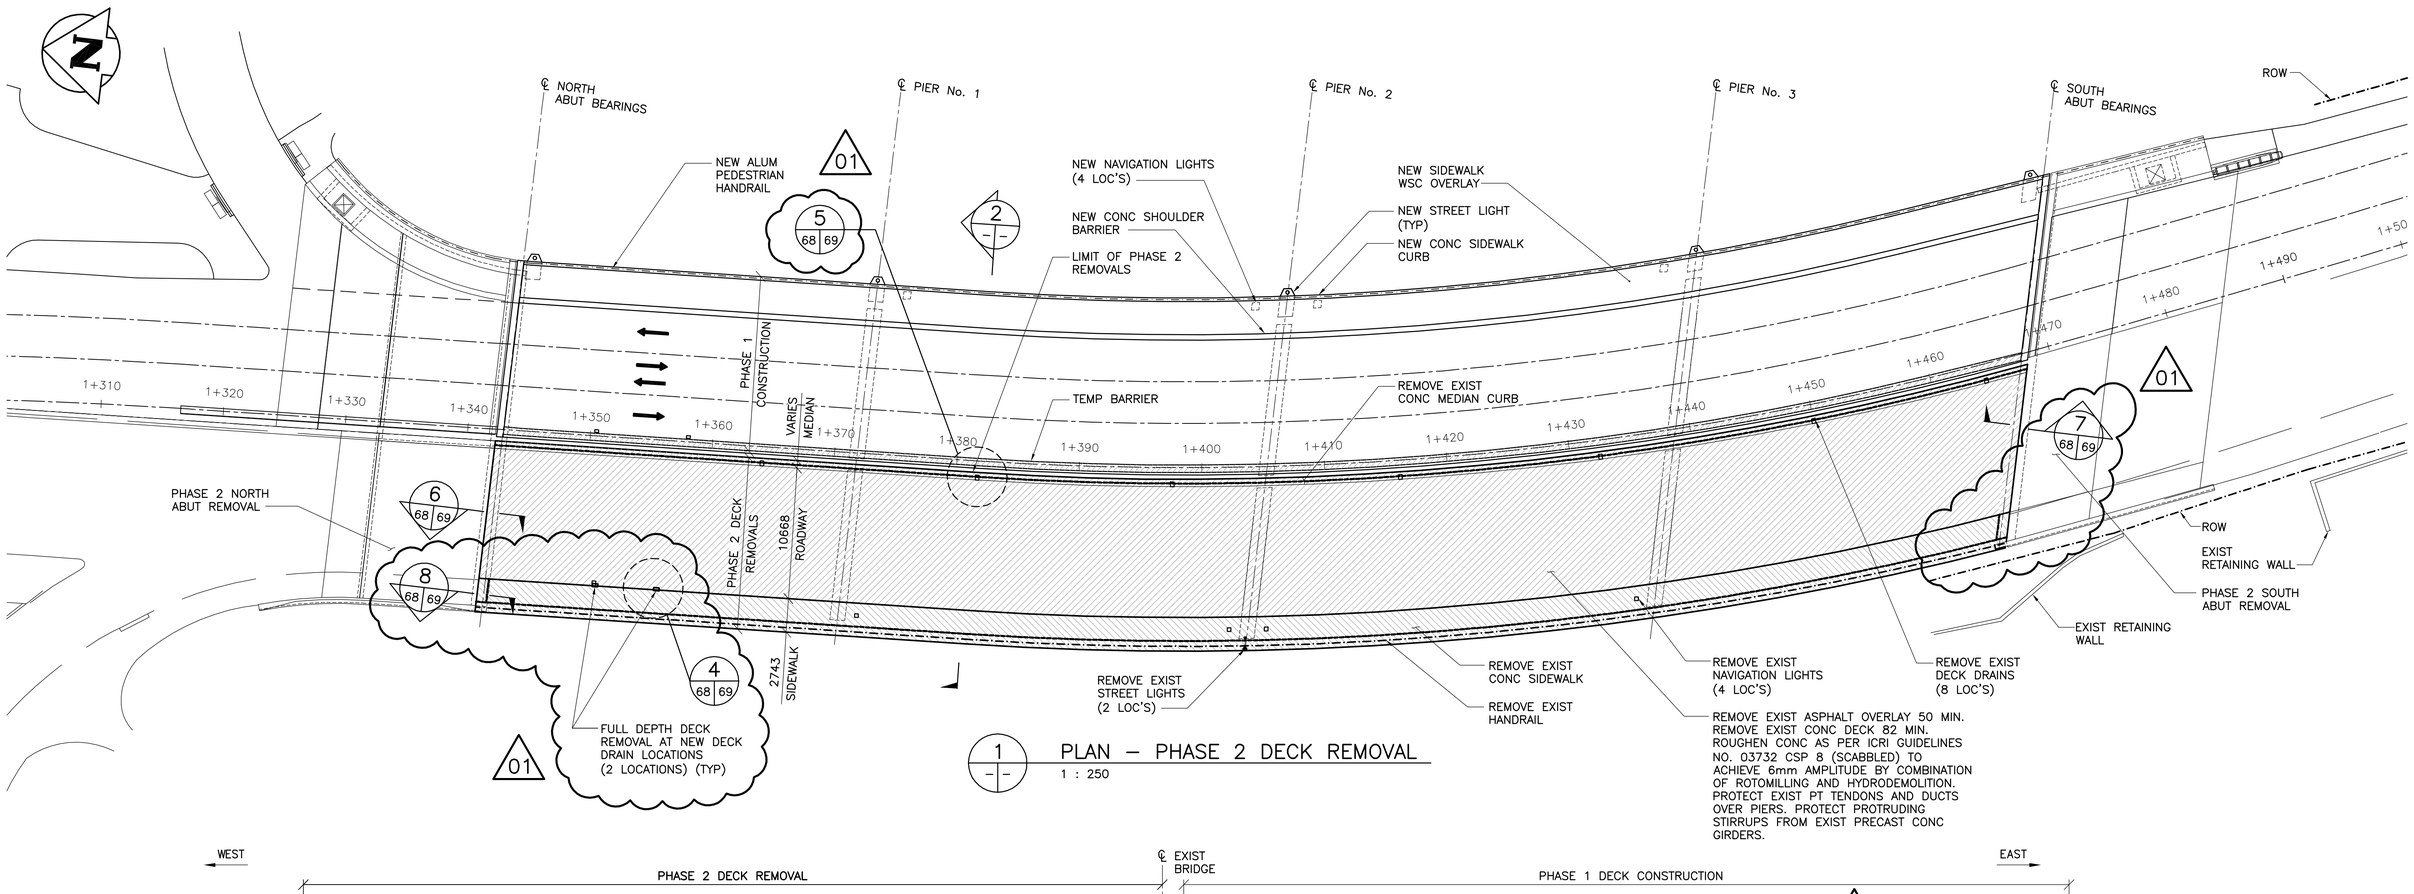

1 — PLAN – PHASE 2 DECK REMOVAL
1 : 250

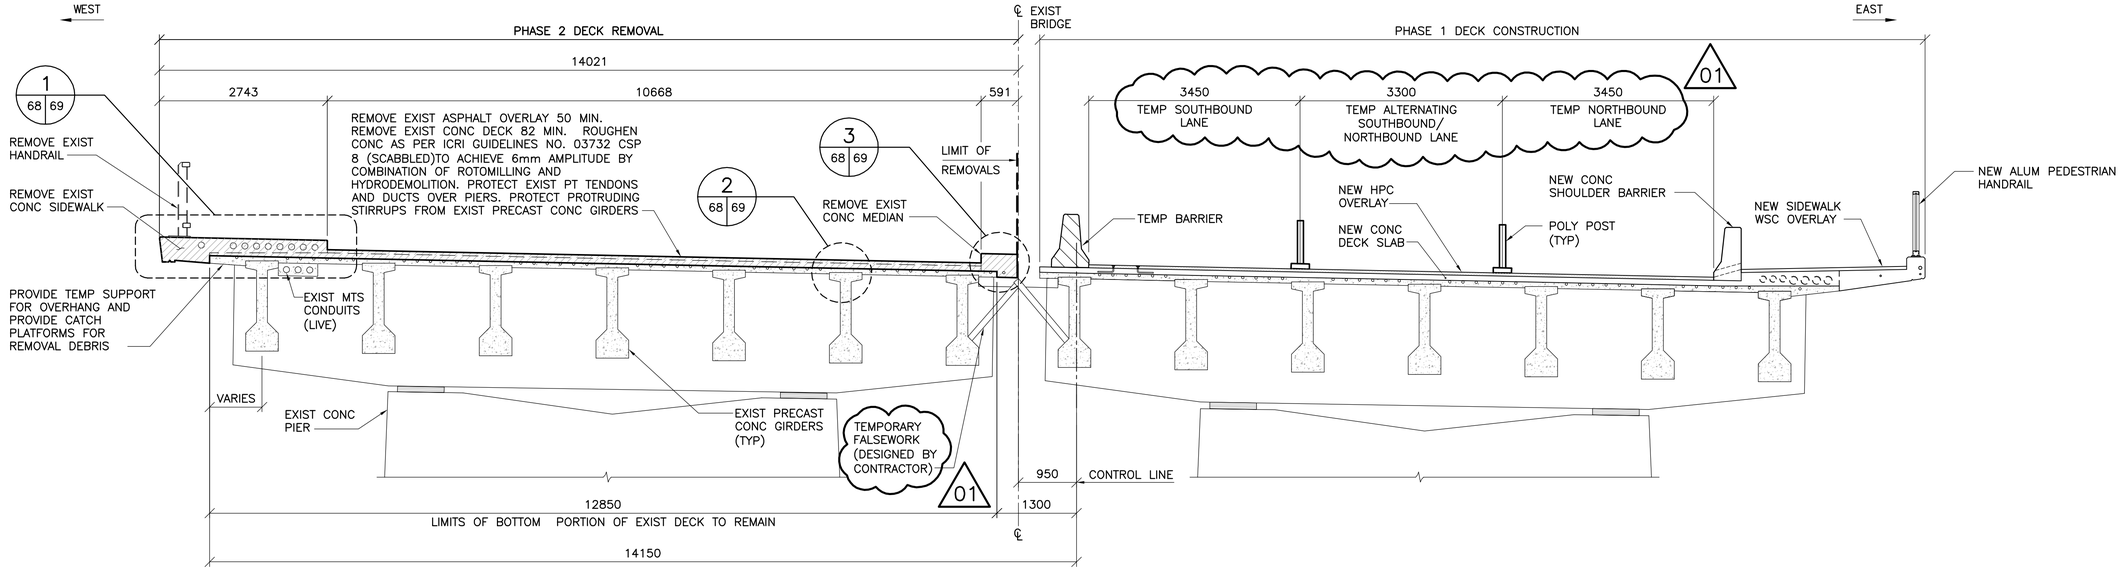

2 — SECTION – PHASE 2 DECK REMOVAL
1 : 50

NOTES:
REFER TO SHEET 5 FOR PROCEDURE AND SEQUENCE OF STRUCTURAL REMOVALS FOR DECK REMOVAL.

APEGM Certificate of Authorization
Wardrop Engineering Inc.
No. 195 Date: April 30, 2011

NO.	REVISIONS	DATE	BY
01	ISSUED FOR ADDENDUM 1	11.03.07	EFS
00	ISSUED FOR TENDER	11.02.18	EFS

B.M. ELEV. F.B.

WARDROP A TETRA TECH COMPANY

DESIGNED BY V.B. | CHECKED BY E.F.S.
DRAWN BY B.M. | APPROVED BY R.H.W.
HOR. SCALE: AS NOTED
VERTICAL:
DATE 10.10.13
RELEASED FOR CONSTRUCTION DATE ORIGINAL SIGNED 11.02.16
MATT CHISLETT, P.ENG BRIDGE PROJECTS ENGINEER

ORIGINAL SIGNED 11.02.16
PROVINCE OF MANITOBA E.F.G. SHEHATA Member 23439 REGISTERED PROFESSIONAL ENGINEER

CONSULTANT DRAWING NO. 0900070502-DWG-S0068

Winnipeg
THE CITY OF WINNIPEG
PUBLIC WORKS DEPARTMENT
ENGINEERING DIVISION

OSBORNE STREET BRIDGE
REHABILITATION & RELATED WORKS

CITY DRAWING NUMBER B109-11-073
SHEET 68 OF 131

BRIDGE DECK – PHASE 2 REMOVAL

68