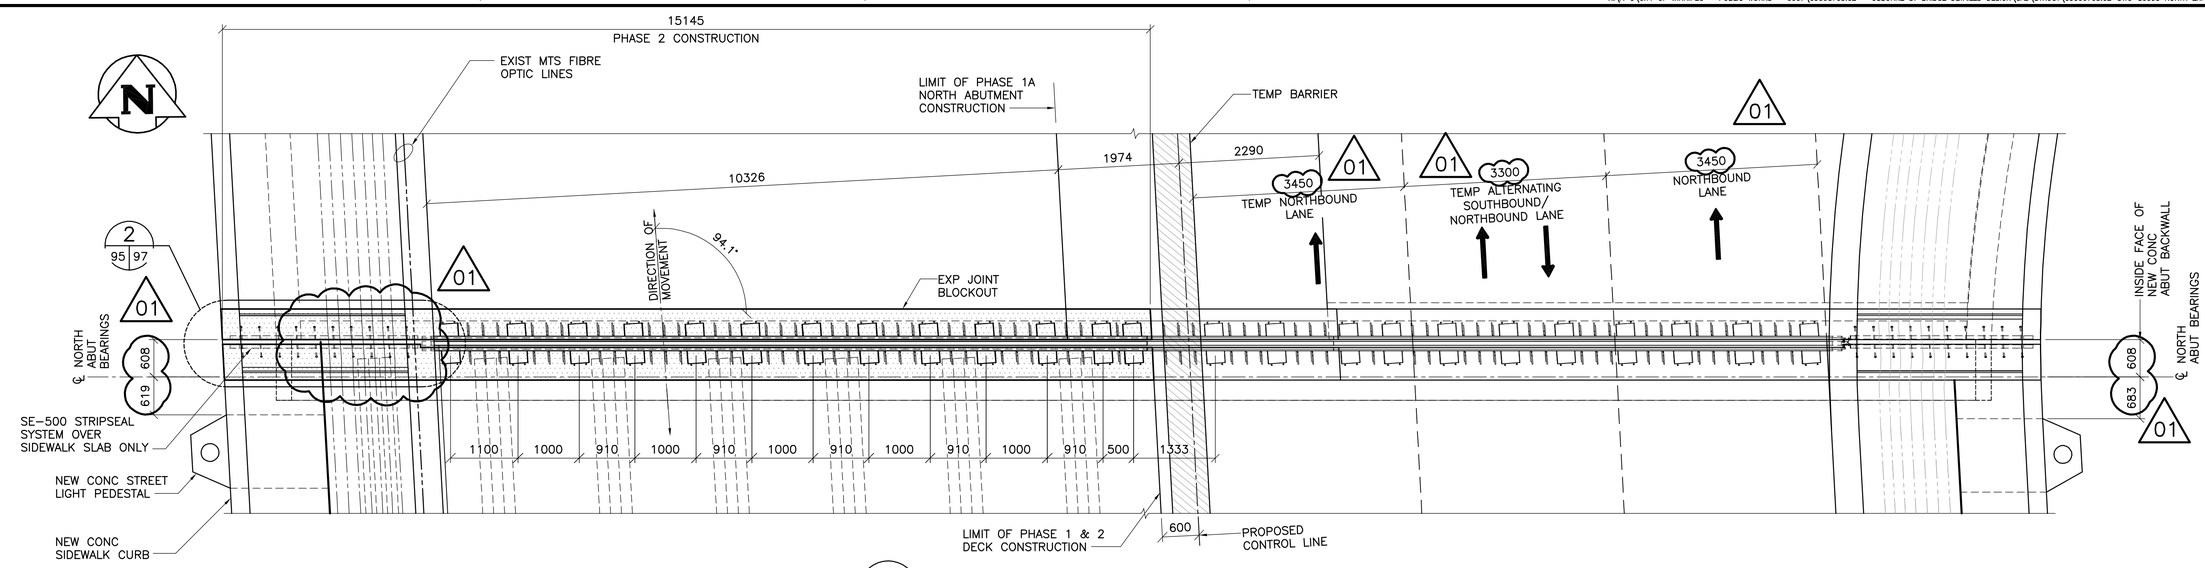

1 — PLAN – NORTH EXPANSION JOINT PHASE 2 CONSTRUCTION
1 : 50

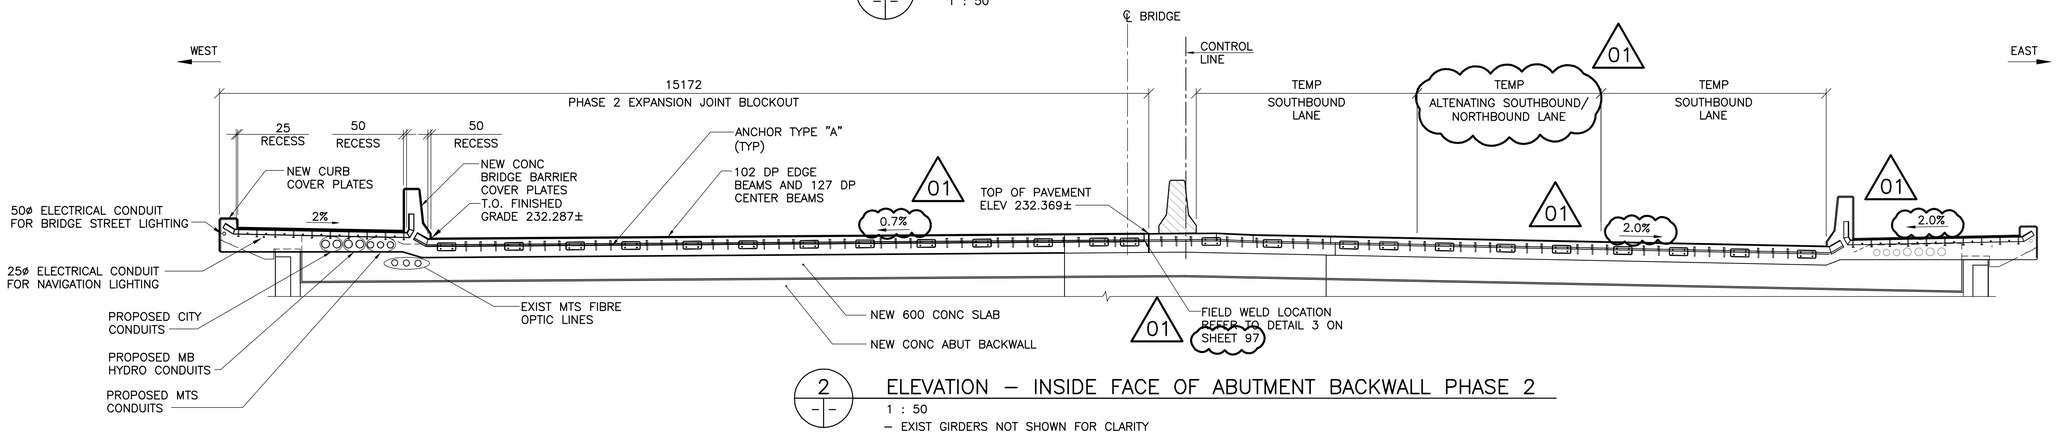

2 — ELEVATION – INSIDE FACE OF ABUTMENT BACKWALL PHASE 2
1 : 50
– EXIST GIRDERS NOT SHOWN FOR CLARITY

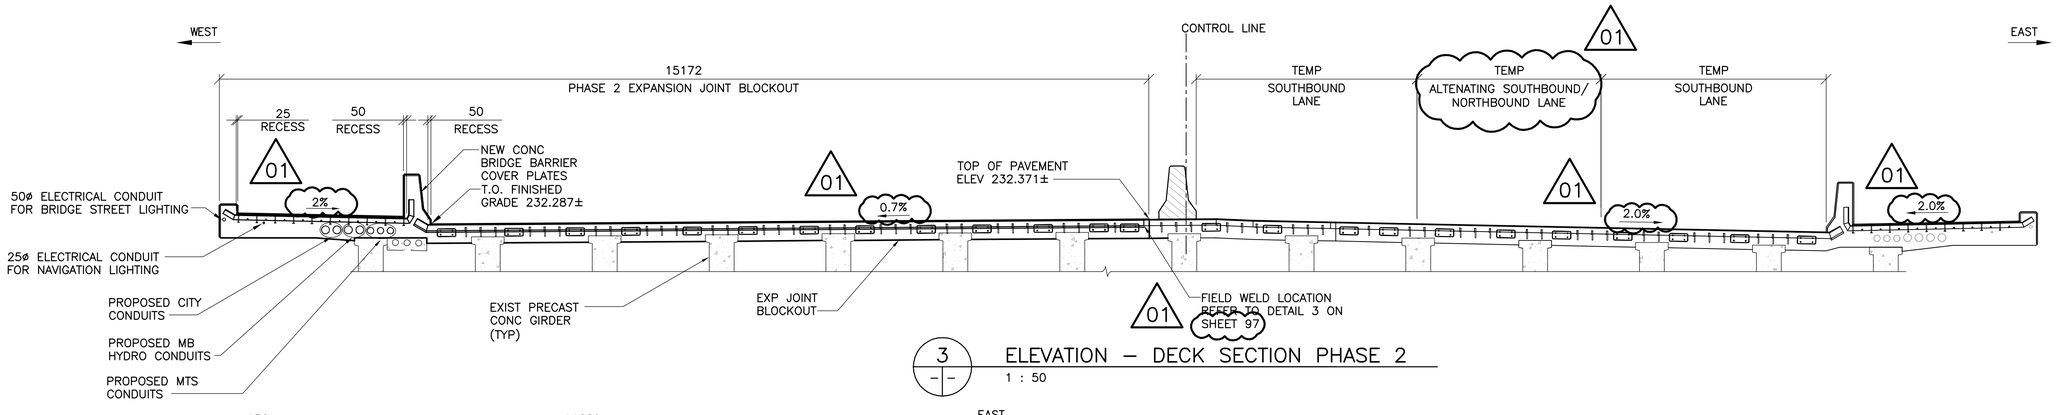

3 — ELEVATION – DECK SECTION PHASE 2
1 : 50

4 — PROFILE DETAIL – EDGE AND CENTRE BEAMS PHASE 2
1 : 50

APEGM
Certificate of Authorization
Wardrop Engineering Inc.
No. 195 Date: April 30, 2011

B.M. ELEV.		F.B.		
01	ISSUED FOR ADDENDUM 1	11.03.07	VB	
00	ISSUED FOR TENDER	11.02.18	VB	
NO.	REVISIONS	DATE	BY	

WARDROP
A TETRA TECH COMPANY

DESIGNED BY	K.Y.	CHECKED BY	V.B.
DRAWN BY	E.M.M.	APPROVED BY	R.H.W.
HOR. SCALE: / VERTICAL:	AS NOTED	RELEASED FOR CONSTRUCTION ORIGINAL SIGNED	DATE 11.02.16
DATE	10.12.03	MATT CHISLETT, P.ENG BRIDGE PROJECT'S ENGINEER	

PROVINCE OF MANITOBA
ORIGINAL SIGNED 11.02.16
V. BANTHIA
Member 23477
REGISTERED PROFESSIONAL ENGINEER

CONSULTANT DRAWING NO.
0900070500-DWG-S0095

Winnipeg

THE CITY OF WINNIPEG
PUBLIC WORKS DEPARTMENT
ENGINEERING DIVISION

OSBORNE STREET BRIDGE
REHABILITATION & RELATED WORKS

CITY DRAWING NUMBER
B109-11-100

SHEET 95 OF 131

NORTH EXPANSION JOINT – PHASE 2 CONSTRUCTION

95