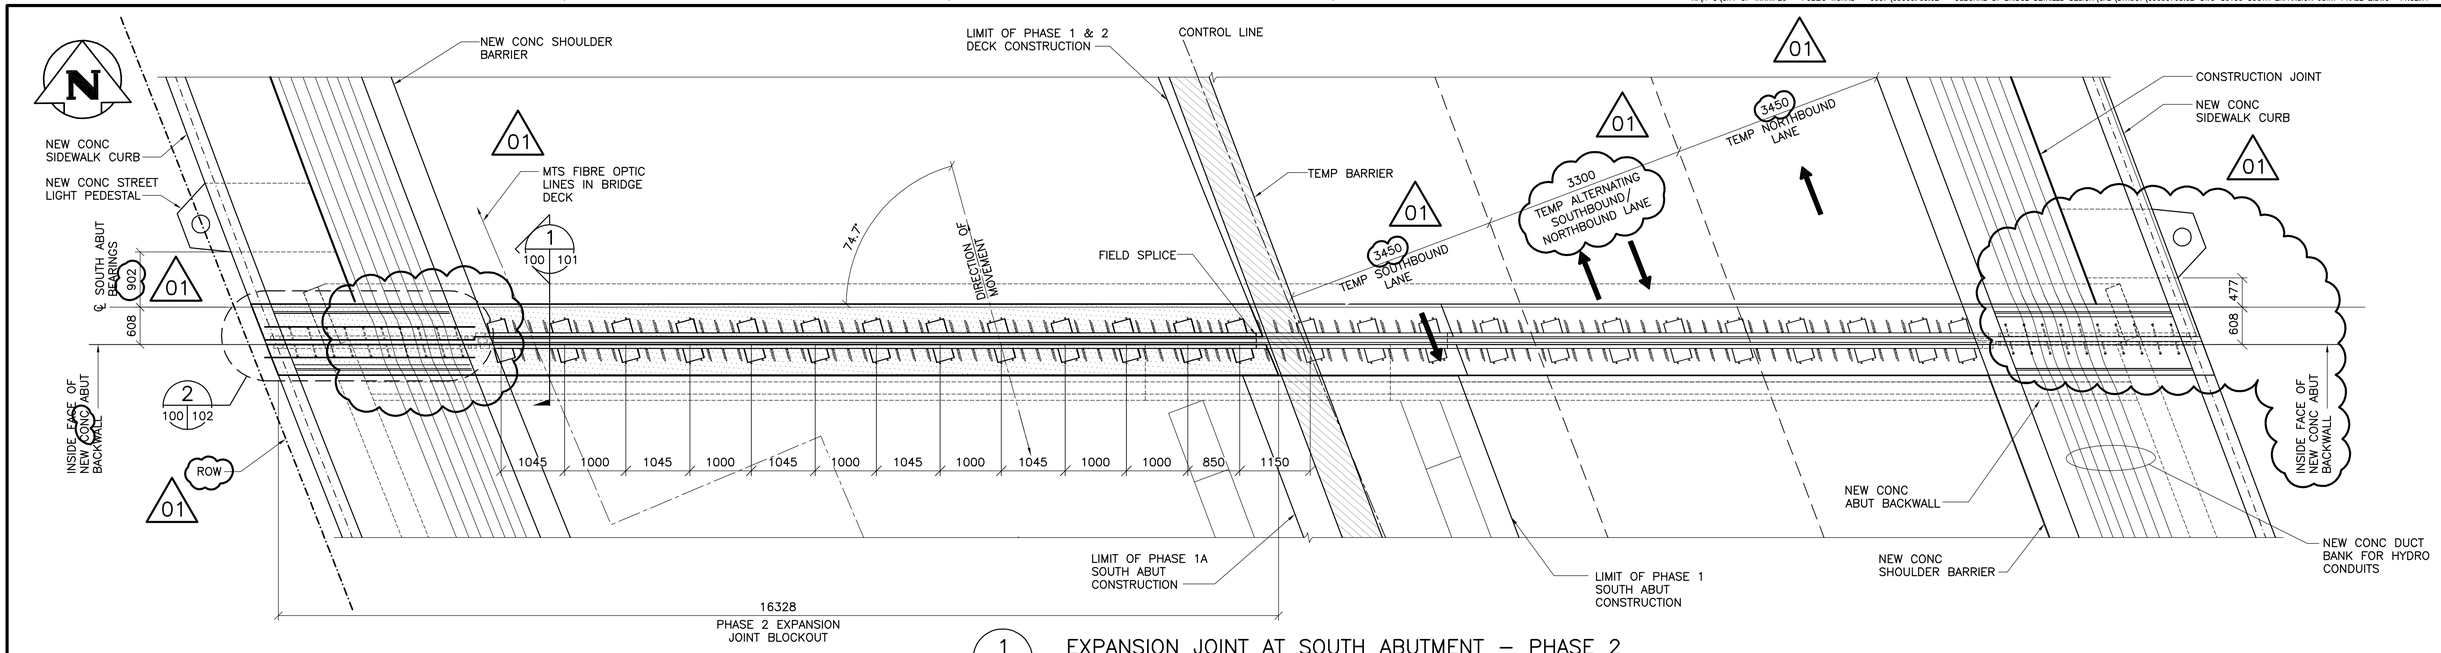

1 / – – EXPANSION JOINT AT SOUTH ABUTMENT – PHASE 2
1 : 50

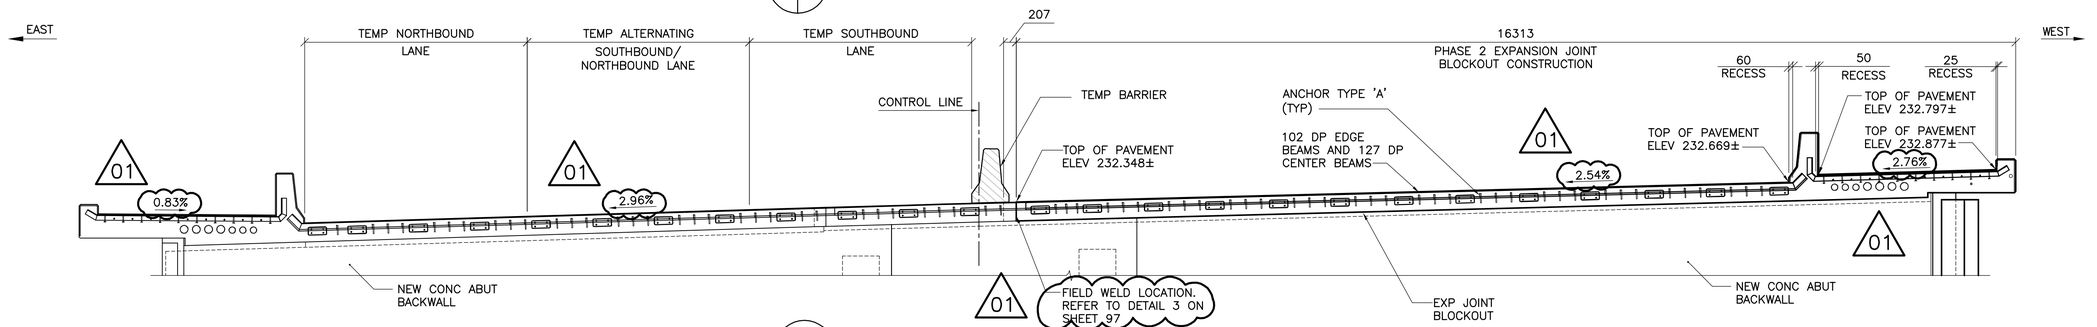

2 / – – ELEVATION – SOUTH ABUTMENT PHASE 2 CONSTRUCTION
1 : 50

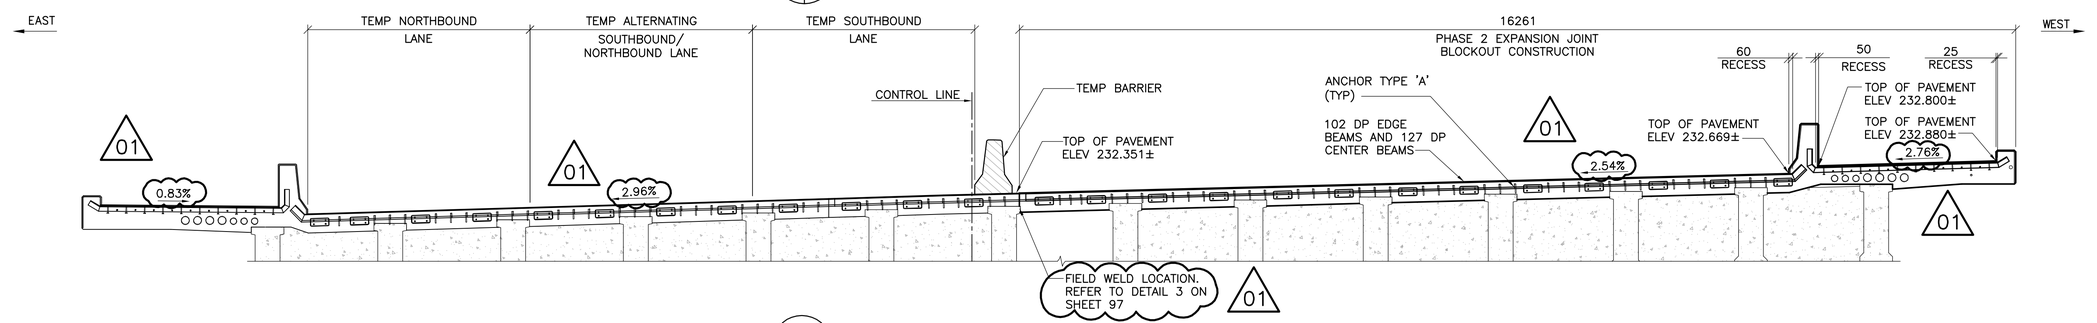

3 / – – ELEVATION – BRIDGE SECTION PHASE 2
1 : 50

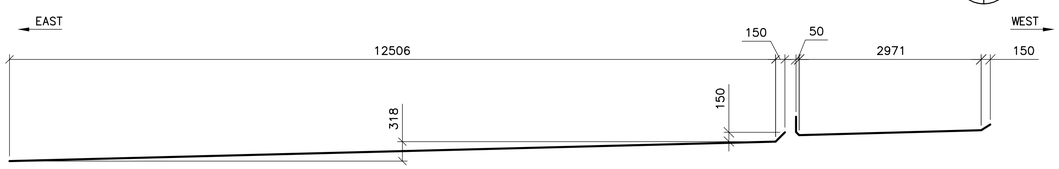

4 / – – PROFILE DETAIL – EDGE AND CENTRE BEAMS – PHASE 2
1 : 50

APEGM
Certificate of Authorization
Wardrop Engineering Inc.
No. 195 Date: April 30, 2011

NO.	REVISIONS	DATE	BY
01	ISSUED FOR ADDENDUM 1	11.03.07	VB
00	ISSUED FOR TENDER	11.02.18	VB

B.M. ELEV. F.B.

WARDROP
A TETRA TECH COMPANY

DESIGNED BY	K.Y.	CHECKED BY	V.B.
DRAWN BY	E.M.M.	APPROVED BY	R.H.W.
HOR. SCALE: / VERTICAL:	AS NOTED	RELEASED FOR CONSTRUCTION	DATE ORIGINAL SIGNED 11.02.16
DATE	10.12.03	MATT CHISLETT, P.ENG BRIDGE PROJECTS ENGINEER	

PROVINCE OF MANITOBA
ORIGINAL SIGNED 11.02.16
V. BANTHIA
Member 23477
REGISTERED PROFESSIONAL ENGINEER

CONSULTANT DRAWING NO.
0900070502-DWG-S0100

Winnipeg
THE CITY OF WINNIPEG
PUBLIC WORKS DEPARTMENT
ENGINEERING DIVISION

OSBORNE STREET BRIDGE
REHABILITATION & RELATED WORKS

CITY DRAWING NUMBER
B109-11-105

SHEET 100 OF 131

SOUTH EXPANSION JOINT – PHASE 2 CONSTRUCTION

100