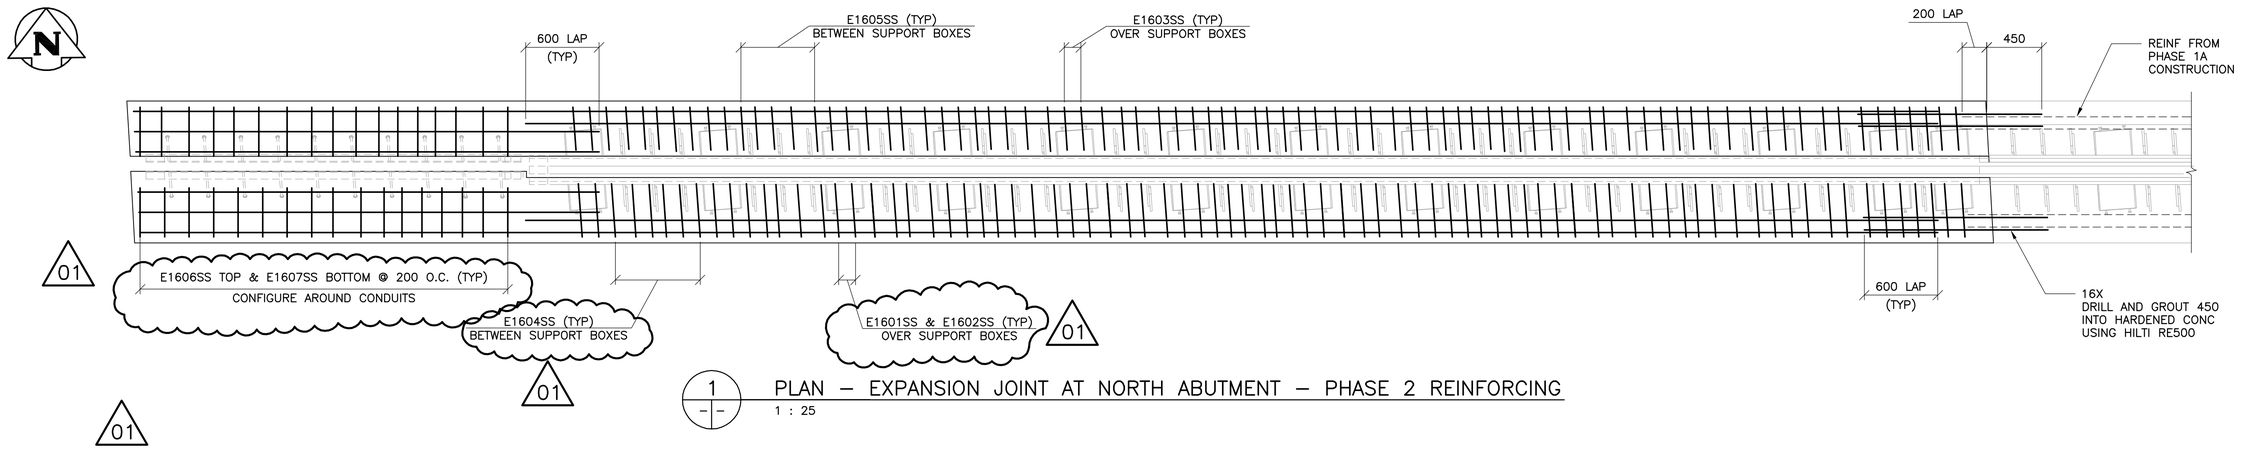

1 / - - PLAN – EXPANSION JOINT AT NORTH ABUTMENT – PHASE 2 REINFORCING

1 : 25

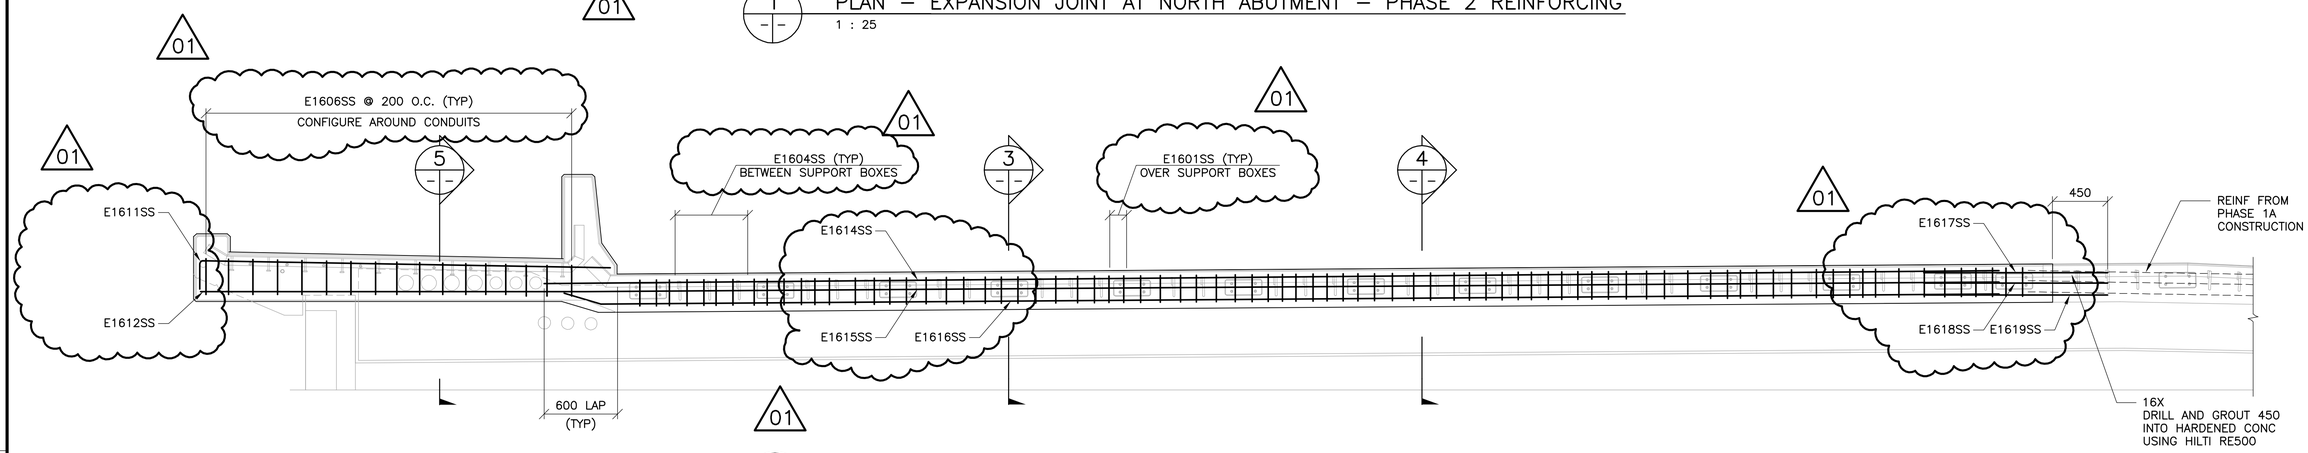

2 / - - ELEVATION – EXPANSION JOINT AT NORTH ABUTMENT – PHASE 2 REINFORCING

1 : 25

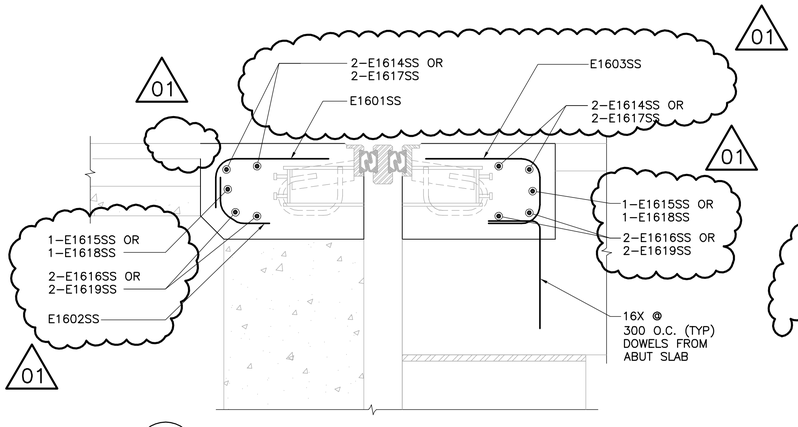

3 / - - SECTION AT EXPANSION JOINT BOXES

1 : 10

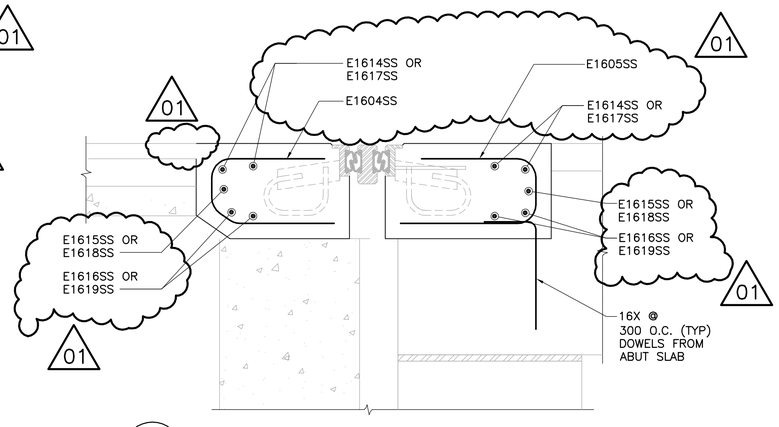

4 / - - SECTION BETWEEN EXPANSION JOINT BOXES

1 : 10

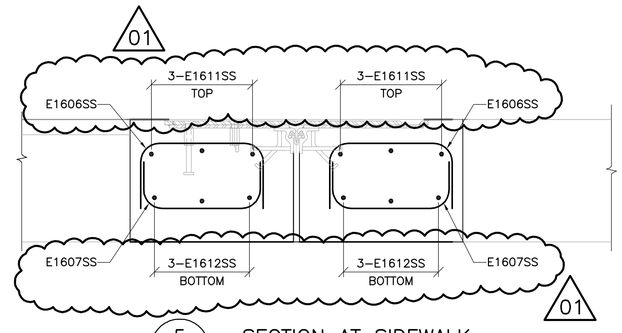

5 / - - SECTION AT SIDEWALK

1 : 10

APEGM Certificate of Authorization Wardrop Engineering Inc. No. 195 Date: April 30, 2011

NO.	REVISIONS	DATE	BY
01	ISSUED FOR ADDENDUM 1	11.03.07	VB
00	ISSUED FOR TENDER	11.02.18	VB

B.M. ELEV. F.B.

WARDROP A TETRA TECH COMPANY

DESIGNED BY K.Y. | CHECKED BY V.B.
DRAWN BY E.M.M. | APPROVED BY R.H.W.
HOR. SCALE: AS NOTED | VERTICAL:
RELEASED FOR CONSTRUCTION ORIGINAL SIGNED DATE 11.02.16
DATE 10.12.03
MATT CHISLETT, P.ENG BRIDGE PROJECTS ENGINEER

PROVINCE OF MANITOBA ORIGINAL SIGNED 11.02.16 V. BANTHIA Member 23477 REGISTERED PROFESSIONAL ENGINEER

CONSULTANT DRAWING NO. 0900070500-DWG-S0104

Winnipeg

THE CITY OF WINNIPEG
PUBLIC WORKS DEPARTMENT
ENGINEERING DIVISION

OSBORNE STREET BRIDGE
REHABILITATION & RELATED WORKS

CITY DRAWING NUMBER B109–11–109

SHEET 104 OF 131

NORTH EXPANSION JOINT
PHASE 2 REINFORCING

104