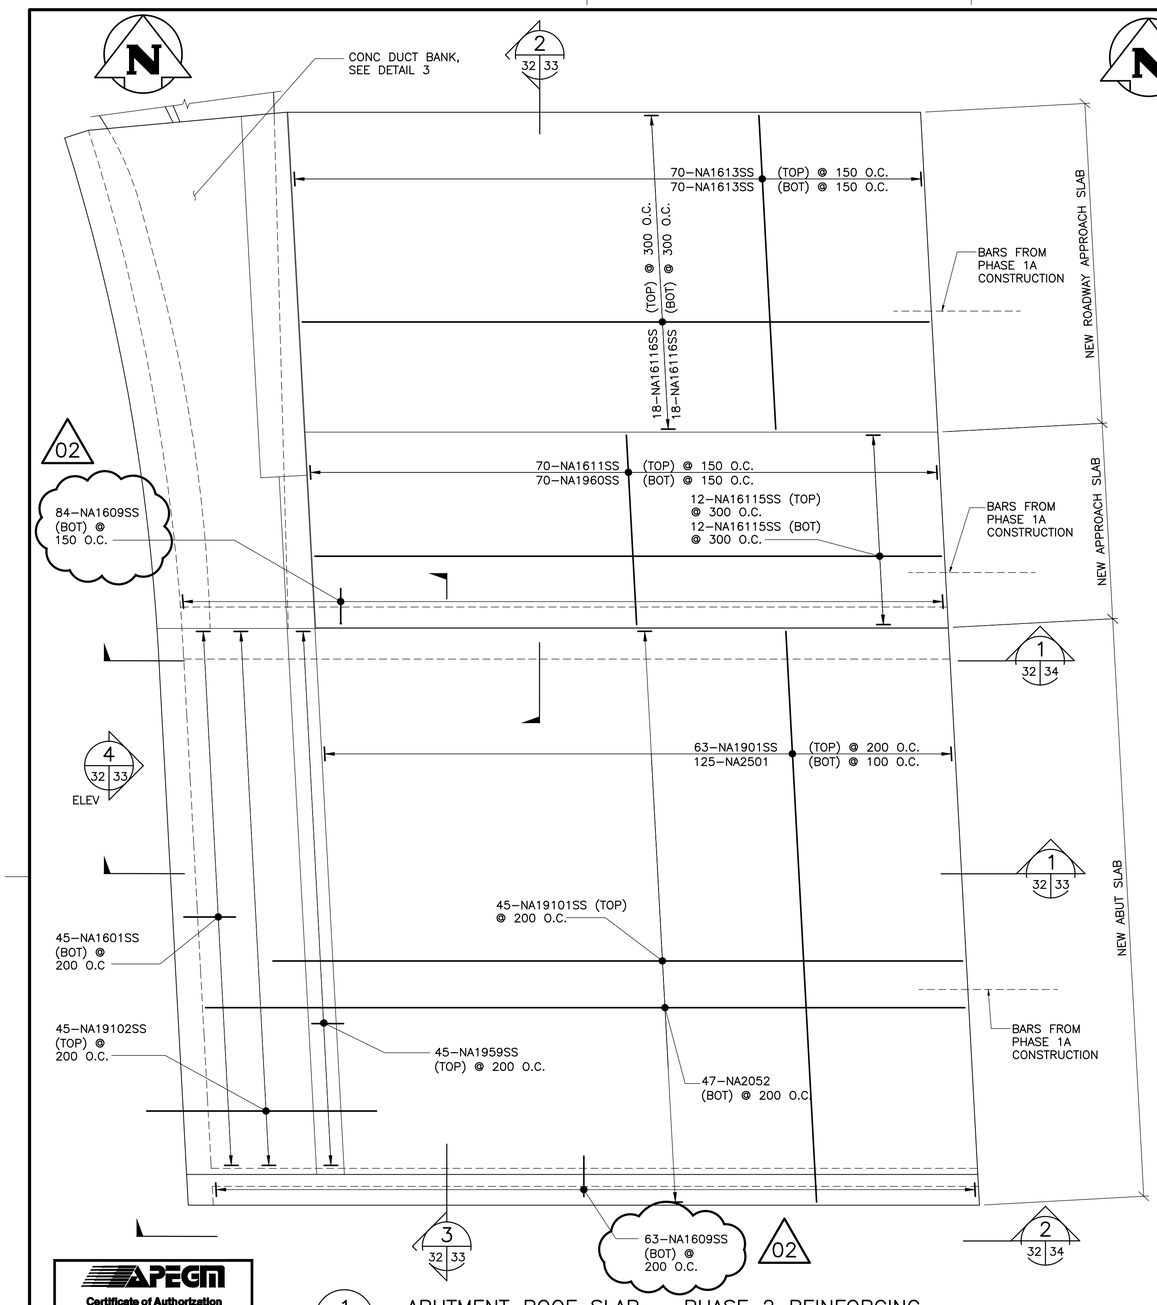

1 / – – ABUTMENT ROOF SLAB – PHASE 2 REINFORCING
1 : 50

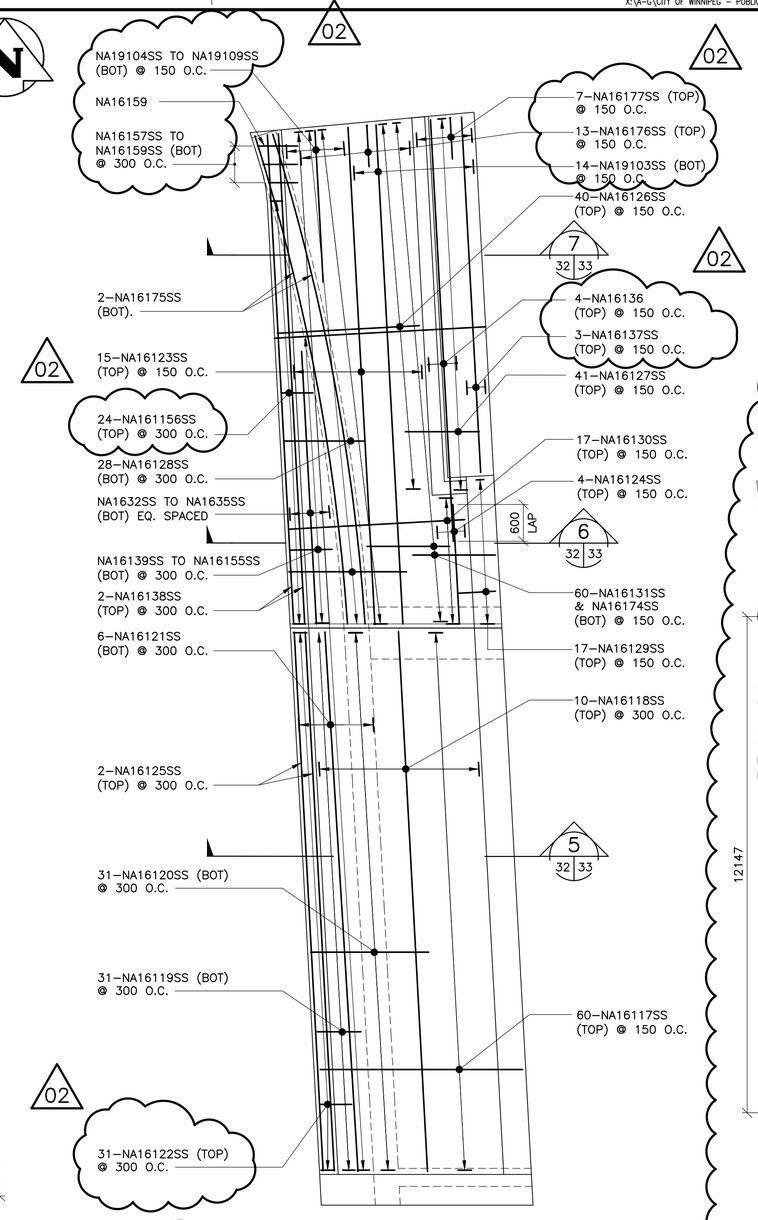

2 / – – SIDEWALK – PHASE 2 REINFORCING
1 : 50

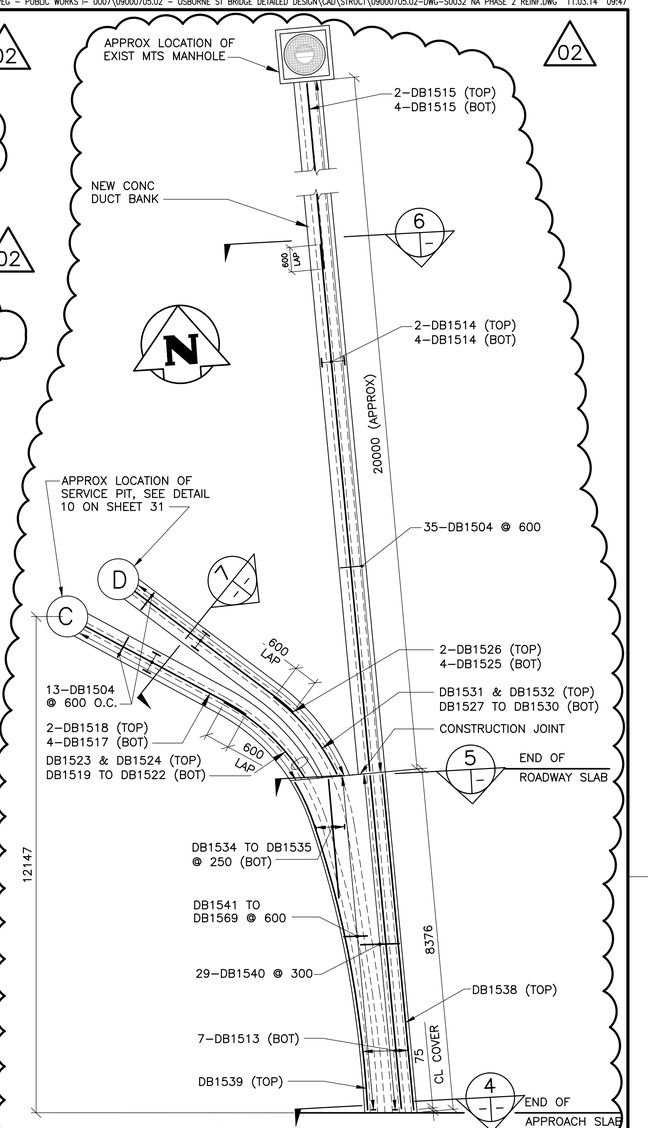

3 / – – CONC DUCT BANK PLAN
1 : 75

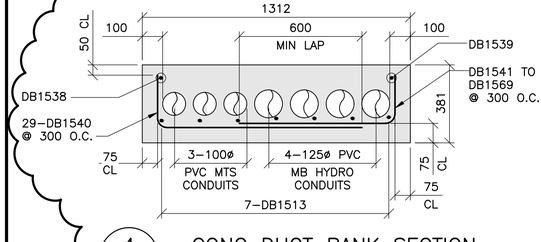

4 / – – CONC DUCT BANK SECTION
1 : 15

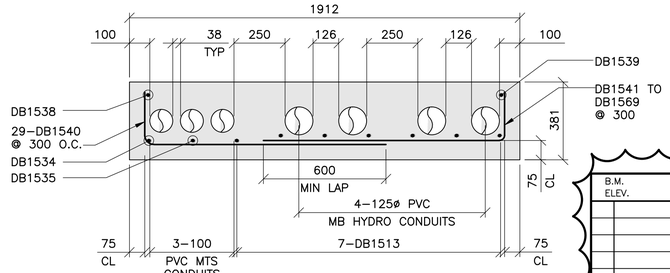

5 / – – CONC DUCT BANK SECTION
1 : 15

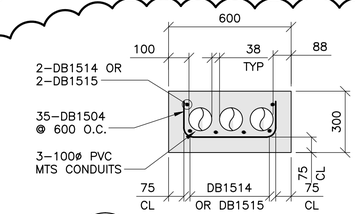

6 / – – CONC DUCT BANK SECTION
1 : 15

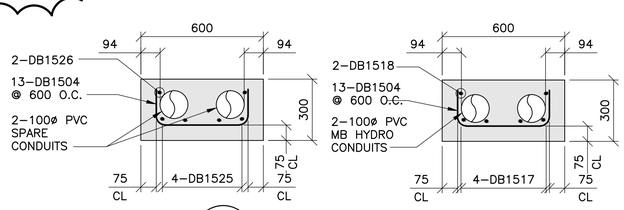

7 / – – CONC DUCT BANK SECTION
1 : 15

APEGM
Certificate of Authorization
Wardrop Engineering Inc.
No. 195 Date: April 30, 2011

B.M. ELEV.		F.B.		
02	ISSUED FOR ADDENDUM 3	11.03.14	RHW	
01	ISSUED FOR ADDENDUM 1	11.03.07	RHW	
00	ISSUED FOR TENDER	11.02.18	RHW	
NO.	REVISIONS	DATE	BY	

WARDROP
A TETRA TECH COMPANY

DESIGNED BY	S.Y.	CHECKED BY	R.H.W.
DRAWN BY	B.M.	APPROVED BY	R.H.W.
HOR. SCALE: / VERTICAL:	AS NOTED	RELEASED FOR CONSTRUCTION	DATE 11.02.16
DATE	10.10.20	ORIGINAL SIGNED	MATT CHISLETT, P.ENG BRIDGE PROJECTS ENGINEER

PROVINCE OF MANITOBA
ORIGINAL SIGNED 11.02.16
W.R. HALDANE-WILSONE
REGISTERED PROFESSIONAL ENGINEER

CONSULTANT DRAWING NO.
0900070502-DWG-S0032

Winnipeg
THE CITY OF WINNIPEG
PUBLIC WORKS DEPARTMENT
ENGINEERING DIVISION

OSBORNE STREET BRIDGE
REHABILITATION & RELATED WORKS

CITY DRAWING NUMBER
B109-11-037
SHEET 32 OF 131

NORTH ABUTMENT AND APPROACH SLAB
PHASE 2 REINFORCING

32