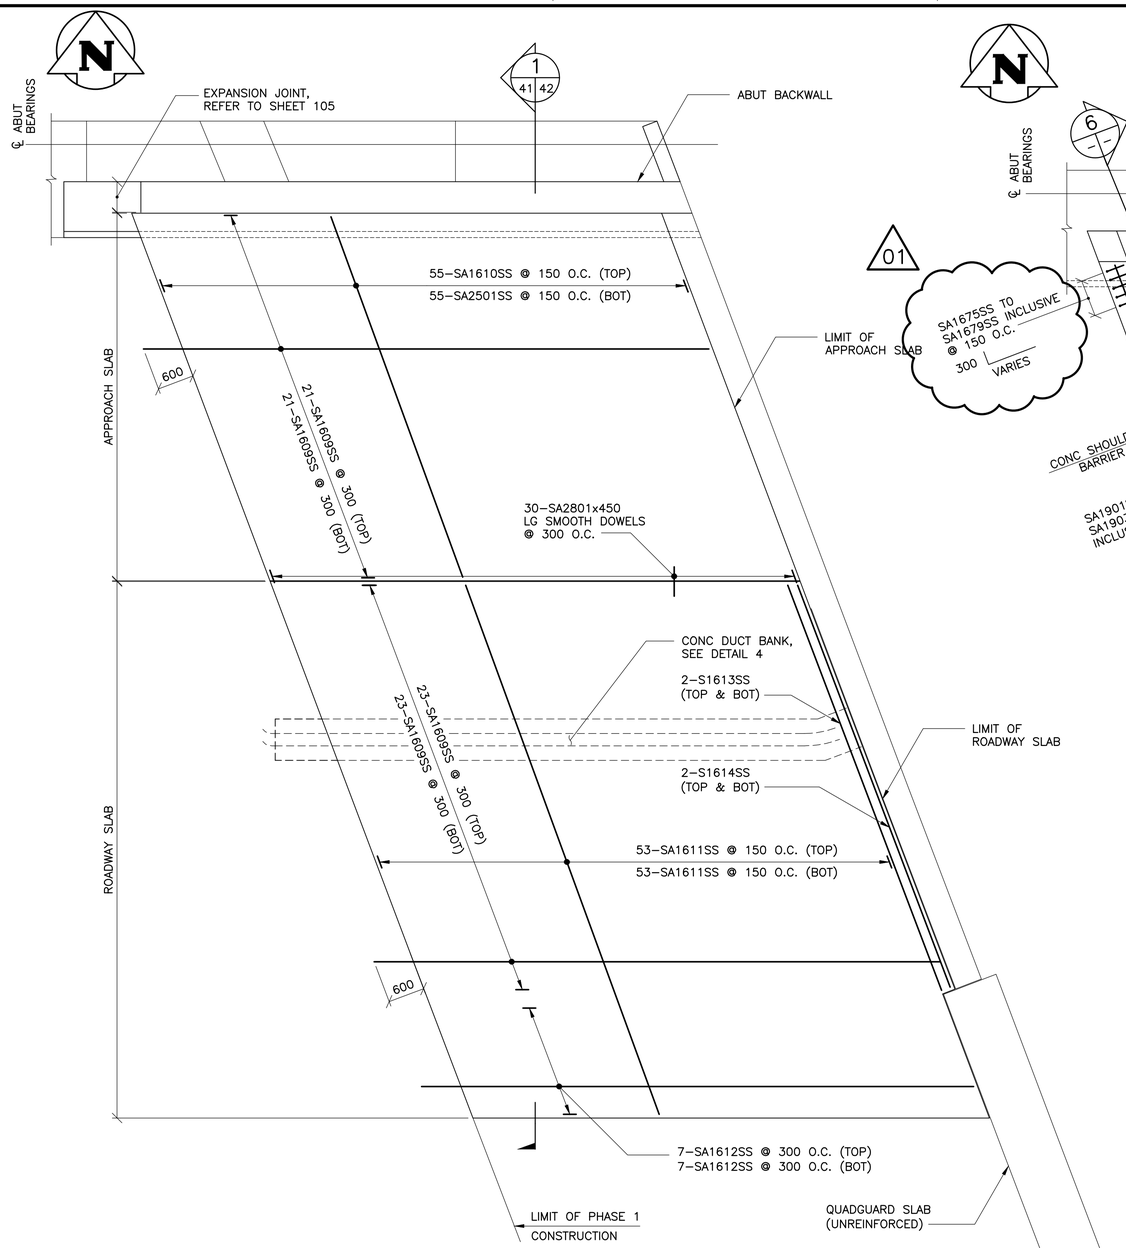

01

1 / – – APPROACH SLAB AND ROADWAY SLAB REINFORCING
1 : 50
– SHOWING TOP AND BOTTOM MAT REINFORCING

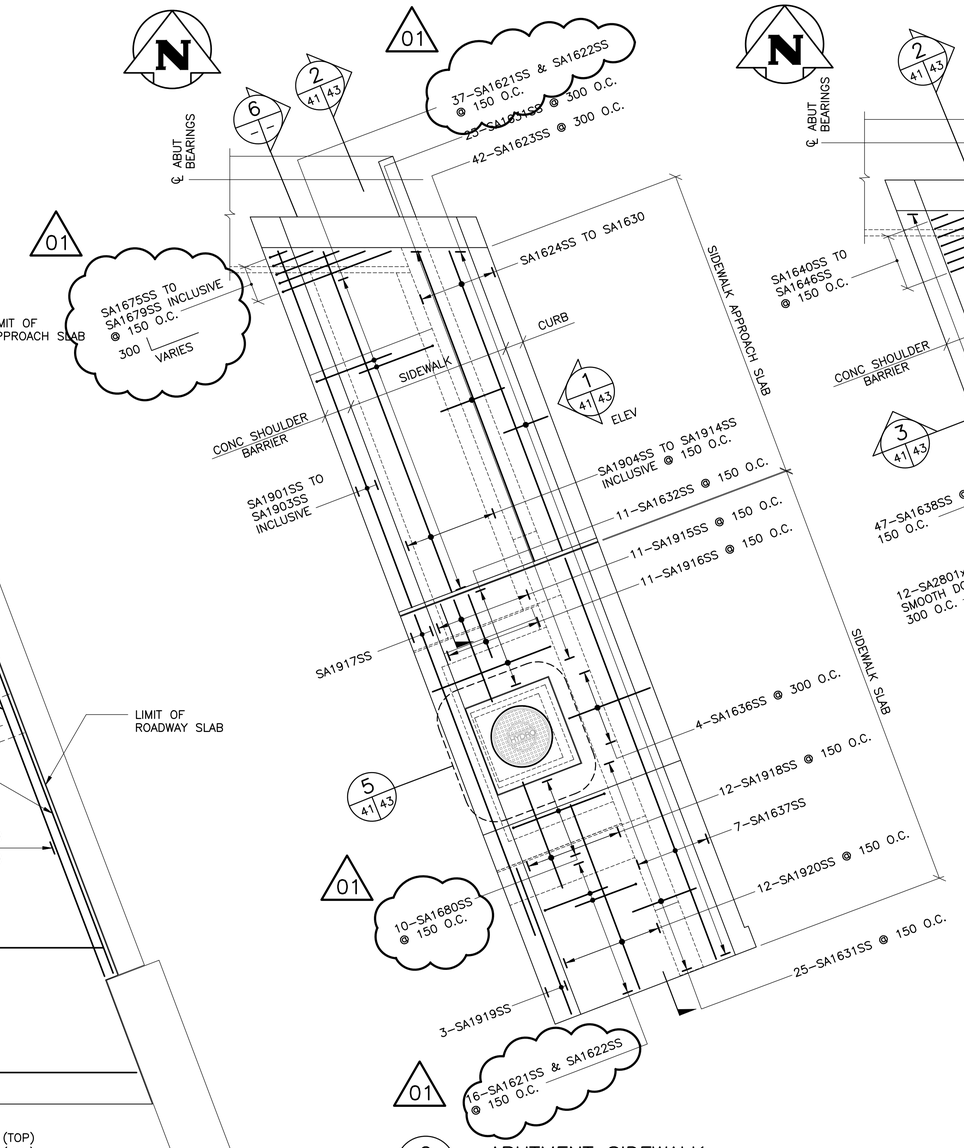

2 / – – ABUTMENT SIDEWALK
1 : 50
– SHOWING BOTTOM MAT REINFORCING

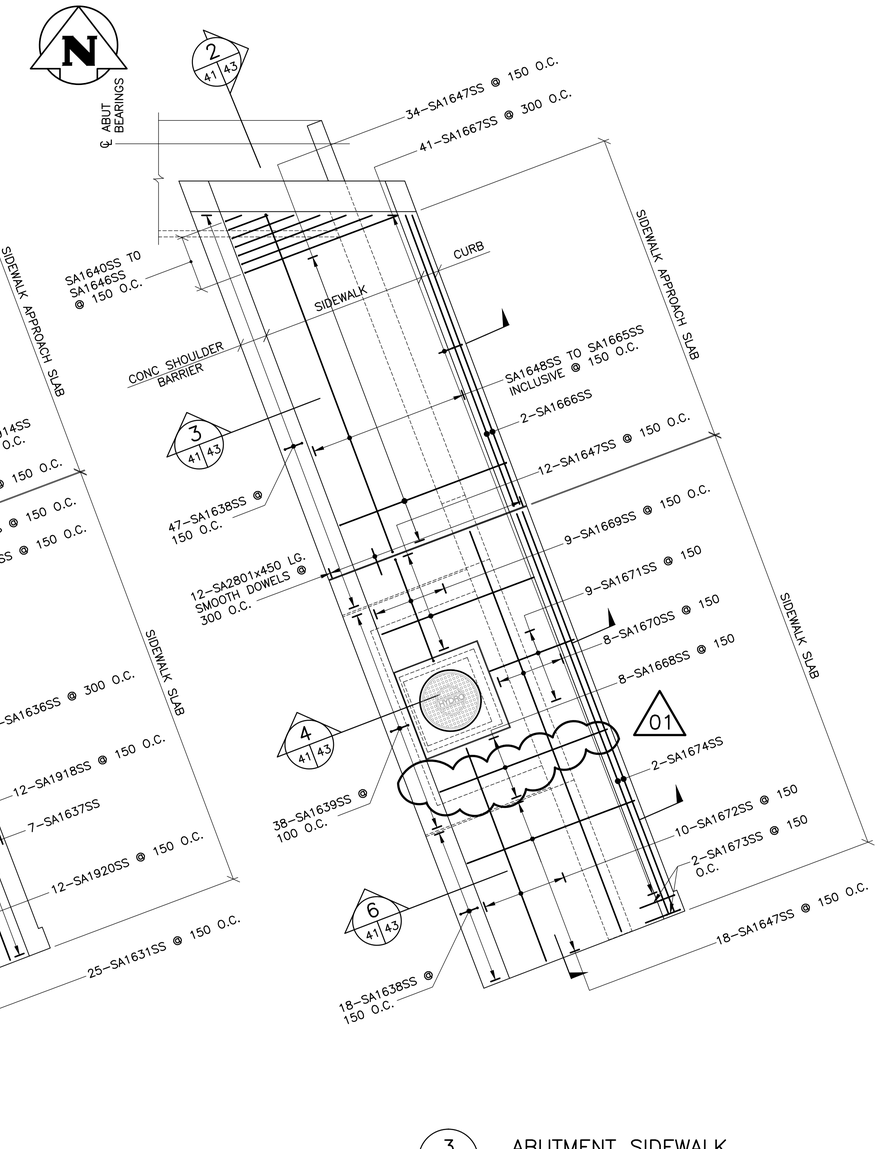

3 / – – ABUTMENT SIDEWALK
1 : 50
– SHOWING TOP MAT REINFORCING

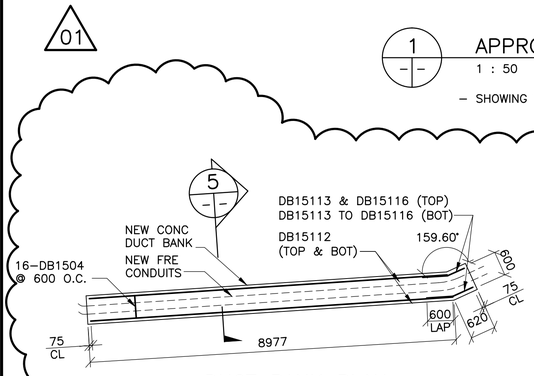

4 / – – DUCT BANK PLAN – UNDER ROADWAY SLAB
1 : 75

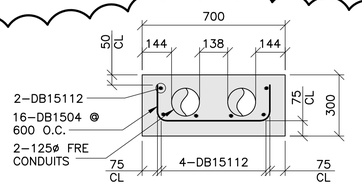

5 / – – DUCT BANK SECTION UNDER SIDEWALK SLAB
1 : 15

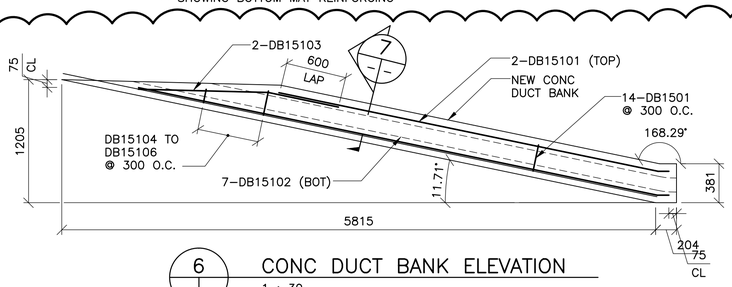

6 / – – CONC DUCT BANK ELEVATION
1 : 30

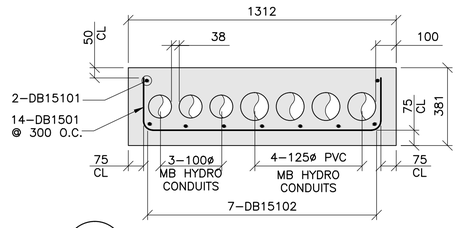

7 / – – DUCT BANK SECTION
1 : 15

NO.	REVISIONS	DATE	BY
01	ISSUED FOR ADDENDUM 3	11.03.14	RHW
00	ISSUED FOR ADDENDUM 1	11.03.07	RHW

B.M. ELEV. F.B.

APEGM Certificate of Authorization Wardrop Engineering Inc. No. 195 Date: April 30, 2011

WARDROP A TETRA TECH COMPANY

DESIGNED BY	S.Y.	CHECKED BY	R.H.W.
DRAWN BY	C.T.	APPROVED BY	R.H.W.
HOR. SCALE:	AS NOTED	RELEASED FOR CONSTRUCTION	DATE ORIGINAL SIGNED 11.03.07
VERTICAL:		DATE	10.10.20

MATT CHISLETT, P.ENG. BRIDGE PROJECTS ENGINEER

PROVINCE OF MANITOBA ORIGINAL SIGNED 11.03.07 W.R. HALDANE-WILSONE REGISTERED PROFESSIONAL ENGINEER

CONSULTANT DRAWING NO. 0900070502-DWG-S0041

Winnipeg

THE CITY OF WINNIPEG
PUBLIC WORKS DEPARTMENT
ENGINEERING DIVISION

OSBORNE STREET BRIDGE
REHABILITATION & RELATED WORKS

CITY DRAWING NUMBER B109-11-046
SHEET 41 OF 131

SOUTH ABUTMENT AND APPROACH SLAB PHASE 1 REINFORCING

41