
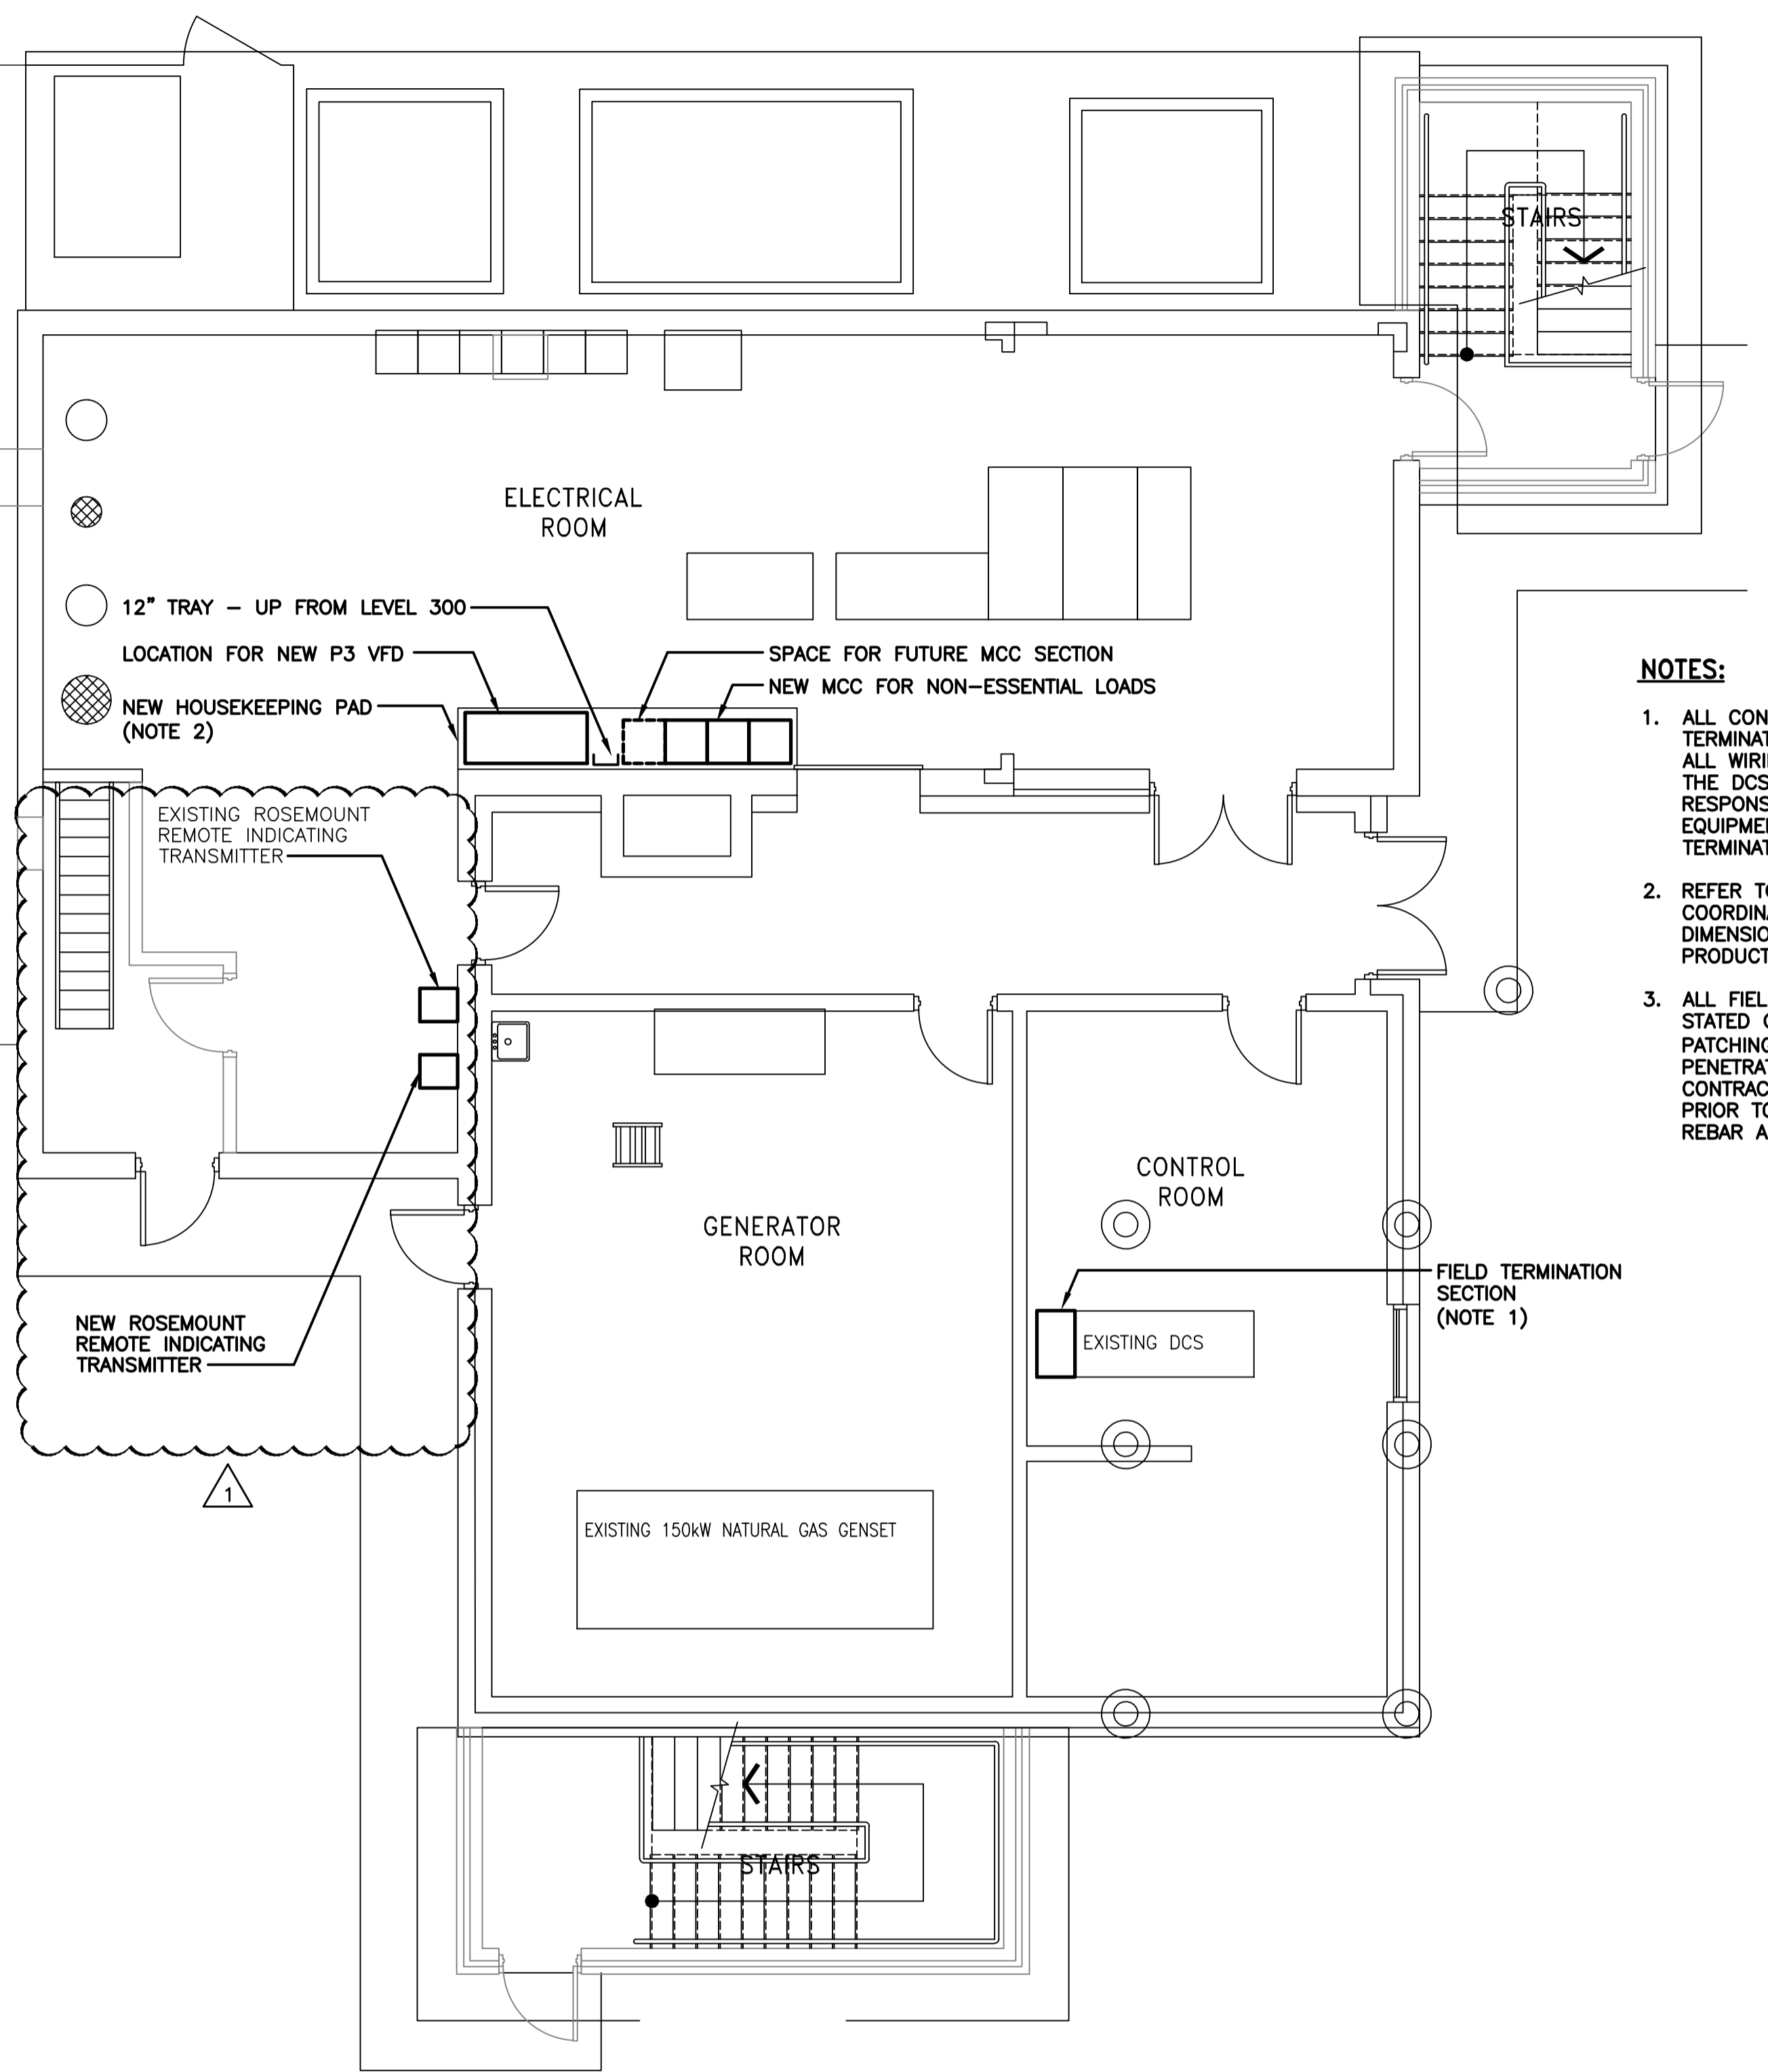


File Name: P:\Projects\2010\10-0107-23\Dwg\Elec\940-2011\_Addendum\_1\_Drawing\_E03 R1.dwg - Tab: E03 Plotted By: Gnelson 12/05/2011 [Mon 2:00pm] CW-9-M564-1

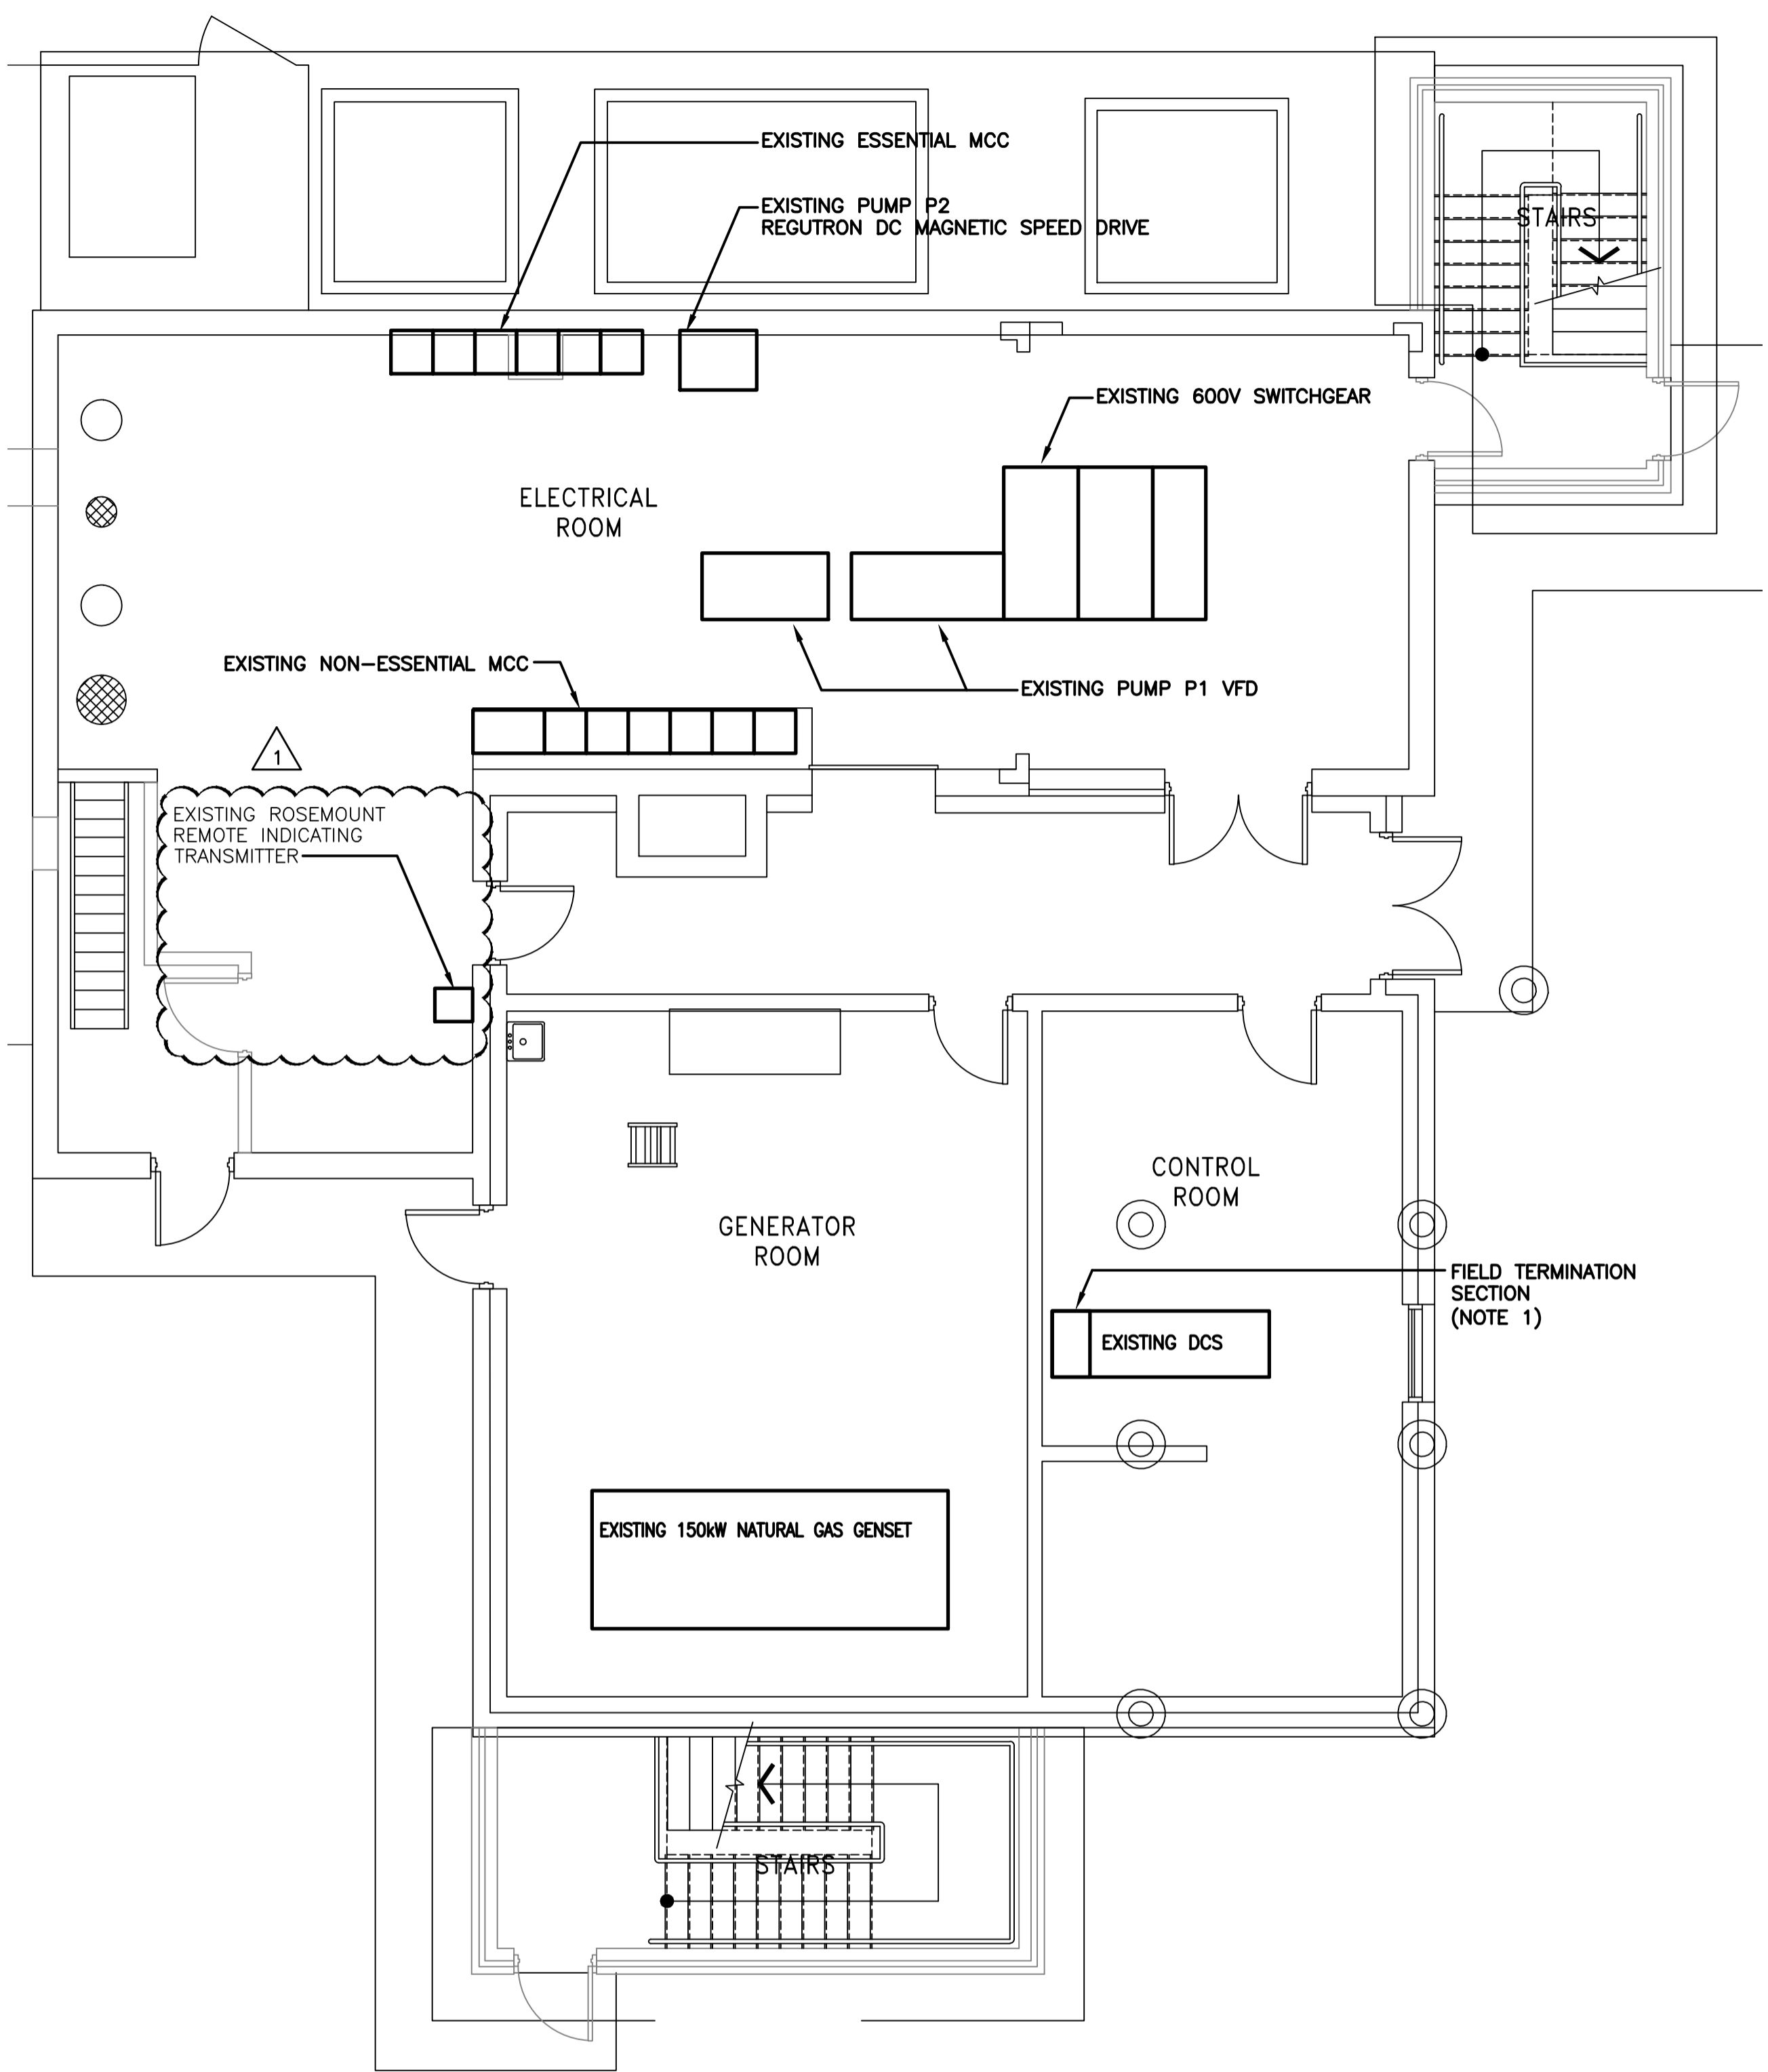

- NOTES:**
1. ALL CONTROL CABLING TO DCS CABINET SHALL BE TERMINATED WITHIN THE FIELD TERMINATION SECTION. ALL WIRING FROM THE FIELD TERMINATION SECTION TO THE DCS IS BY OTHER. THE CONTRACTOR IS RESPONSIBLE FOR VERIFYING ALL WIRING FROM THE EQUIPMENT TO THE TERMINALS WITHIN THIS TERMINATION SECTION PRIOR TO COMMISSIONING.
  2. REFER TO THE STRUCTURAL DRAWING S01 FOR COORDINATION OF THE HOUSEKEEPING PAD. EXACT DIMENSIONS TO BE CONFIRMED ON SITE WITH PRODUCT SHOP DRAWINGS.
  3. ALL FIELD WIRING SHALL BE WITHIN CONDUIT UNLESS STATED OTHERWISE. CONTRACTOR IS RESPONSIBLE FOR PATCHING AND/OR FIRE STOPPING ALL FLOOR/WALL PENETRATIONS AS A RESULT OF THE NEW WORK. CONTRACTOR TO ALLOW FOR SCANNING THE CONCRETE PRIOR TO ANY CONDUIT PENETRATIONS TO ENSURE REBAR AND EMBEDDED SERVICES ARE MISSED.

**1** LEVEL 400 EXISTING EQUIPMENT PLAN

SCALE: 3/16"=1'-0" (24" X 36")  
N.T.S. (11" X 17")

**2** LEVEL 400 NEW EQUIPMENT PLAN

SCALE: 3/16"=1'-0" (24" X 36")  
N.T.S. (11" X 17")



FIELD BOOK #:		<b>KGS GROUP</b> CONSULTING ENGINEERS		ENGINEER'S SEAL	
POSTED TO LBIS		DESIGNED BY: DDW	CHECKED BY: JLL	THE ORIGINAL ISSUE REV. 0 WAS STAMPED, DATED AND SIGNED	
		DRAWN BY: GCN	APPROVED BY: RED	BY J.L. LALONDE, P.ENG. ON 2011/11/07	
		HDR. SCALE: N.T.S.	RELEASED FOR CONSTRUCTION	E03	
		VERTICAL: N.T.S.			
1	ISSUED FOR ADDENDUM #1	2011-12-05	JLL		
0	ISSUED FOR TENDER	2011-11-07	JLL		
NO.	REVISIONS	DATE	BY	DATE	2011 06 24

**THE CITY OF WINNIPEG**  
WATER AND WASTE DEPARTMENT

REPLACEMENT OF RAW SEWAGE PUMP P-3 PERIMETER ROAD PUMPING STATION

**ELECTRICAL**  
EXISTING AND NEW  
LEVEL 400 PLANS

SHEET 1 OF 1  
CITY DRAWING NUMBER