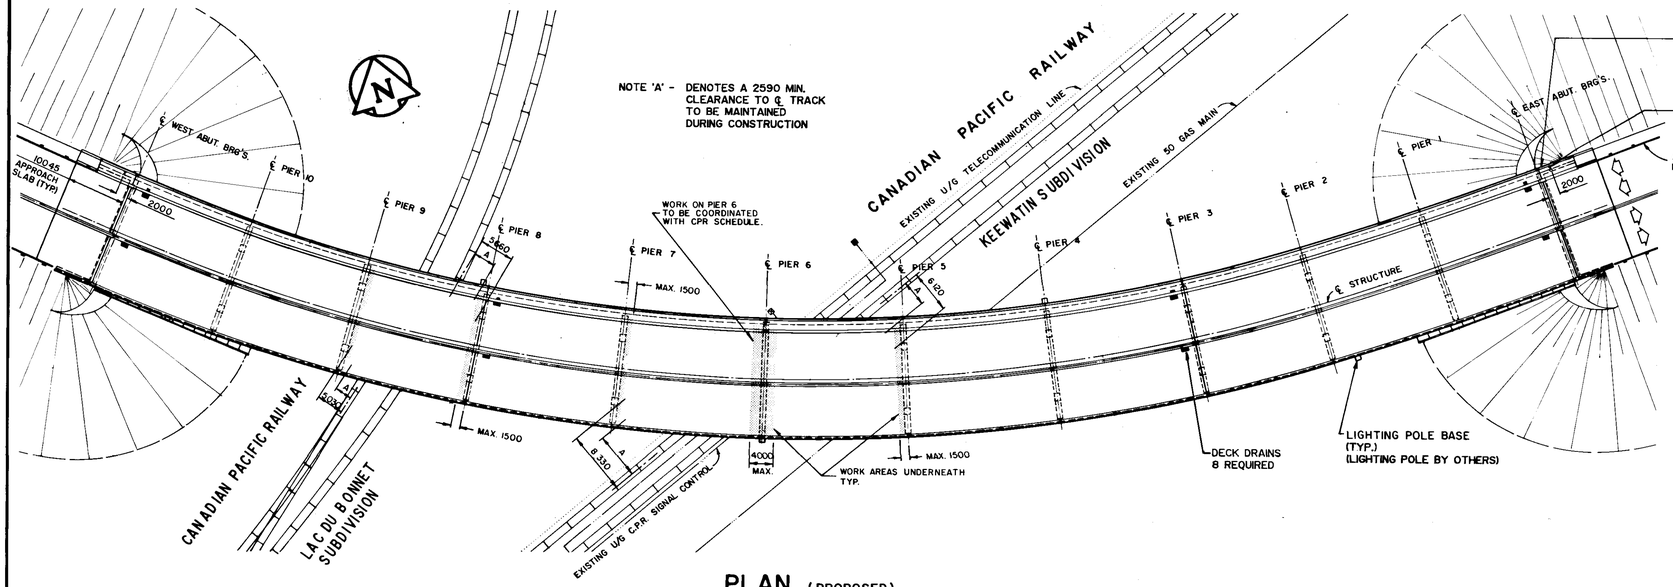

PLAN (PROPOSED)

1:500

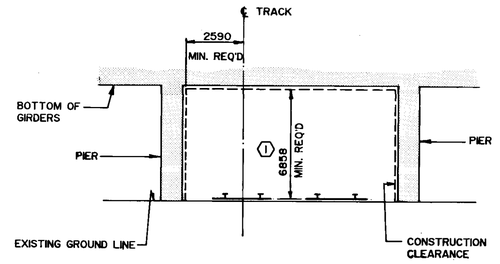

CONSTRUCTION CLEARANCE DIAGRAM

N.T.S.

* DENOTES HORIZONTAL CHORD LENGTH ALONG ℄ STRUCTURE

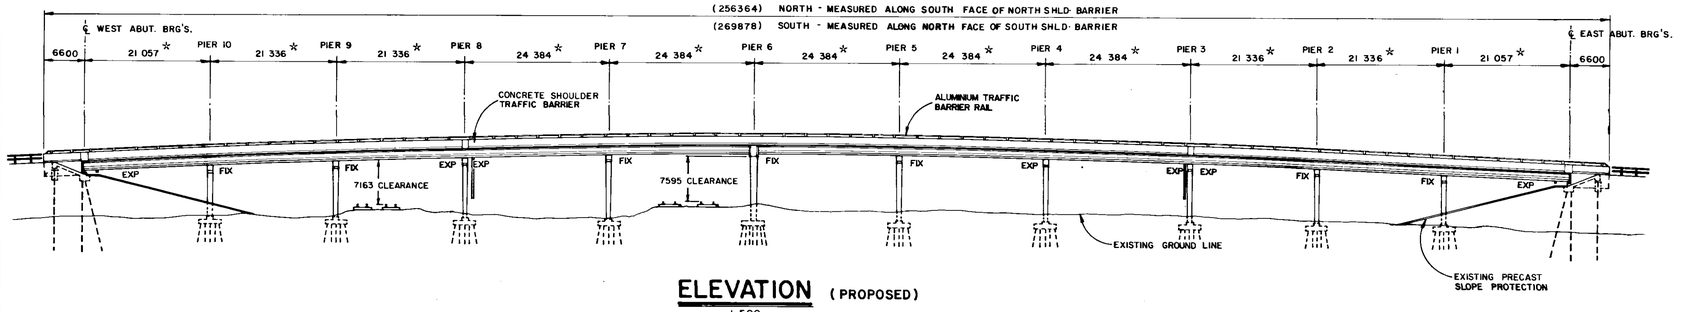

ELEVATION (PROPOSED)

1:500

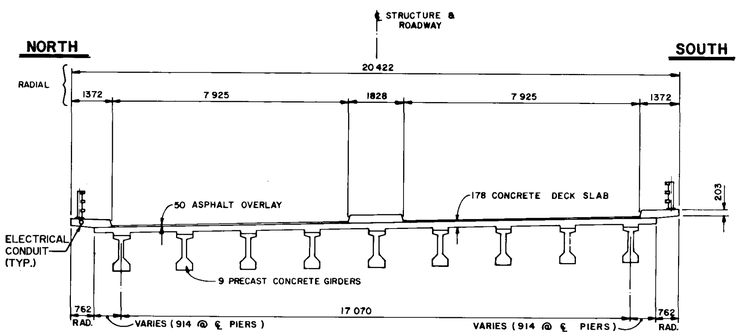

EXISTING DECK CROSS-SECTION

SCALE = 1:100

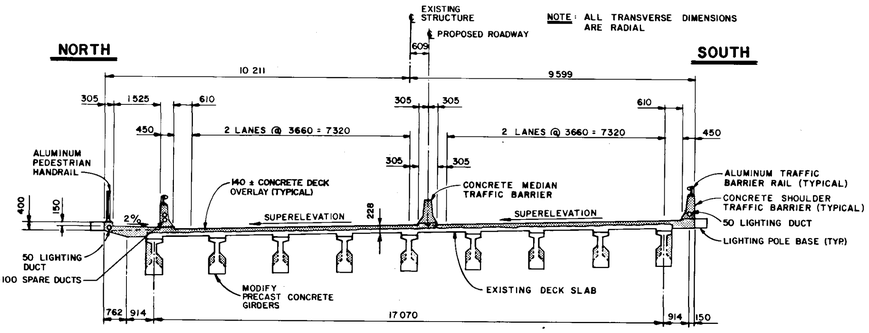

PROPOSED DECK CROSS-SECTION

SCALE = 1:100

RECORD DRAWING

B-5570

METRIC

WHOLE NUMBERS INDICATE MILLIMETRES
DECIMALIZED NUMBERS INDICATE METRES

NO	REVISIONS	DATE	APP
3	RECORD DRAWING	NOV.86	
2	DECK HOARDING DETAILS ADDED	JAN-86	
1	ADDENDUM NO. 2	MAY-85	

PROVINCE OF MANITOBA — K.S. UPPAL — June 15/84 — REGISTERED ENGINEER

ENGINEER'S SEAL

the uma group — Underwood McLellan Ltd., Consulting Engineers and Planners

DESIGNED BY: K.U. | DRAWN BY: A.T.
CHECKED BY: J.T. | DATE: APRIL 1985
JOB No: 0265-216-01
APPROVED BY: DATE: June 14/84

THE CITY OF WINNIPEG
WORKS & OPERATIONS DIVISION
STREETS & TRANSPORTATION DEPARTMENT

NAIRN AVENUE OVERPASS
DECK REHABILITATION, STRUCTURAL STRENGTHENING AND RELATED WORKS

PLAN AND GENERAL ELEVATION OF EXISTING AND PROPOSED OVERPASS

AUTHORIZED BY: STREETS & BRIDGES ENGINEER — DATE 1985-04-16
ACCEPTED BY: BRIDGE ENGINEER — DATE 85 04 16

SCALE: AS SHOWN | DRAWING NO: B121-85-04