NOTE:
NORTH WINGWALLS SHOWN
SOUTH WINGWALLS SIMILAR.

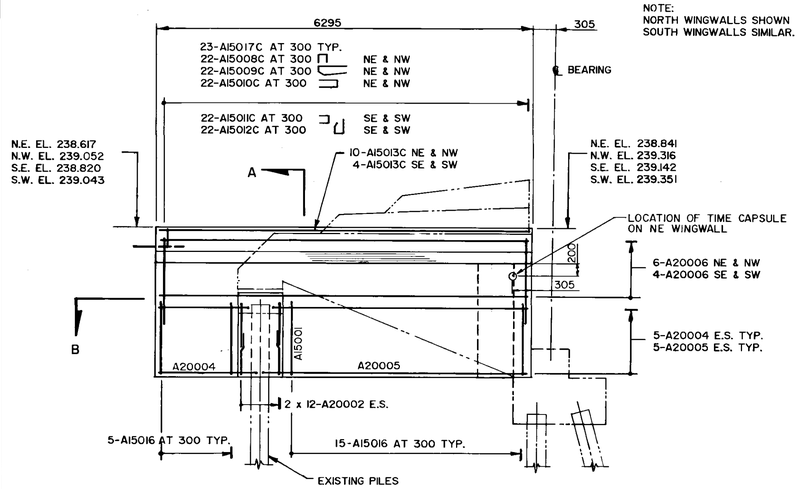

OUTSIDE FACE

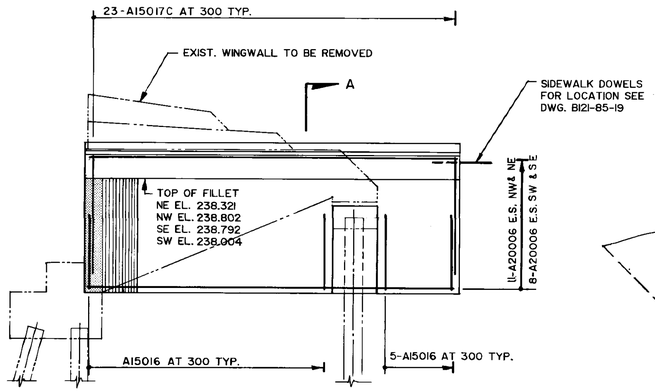

INSIDE FACE

WINGWALL ELEVATIONS

SCALE - 1 : 50

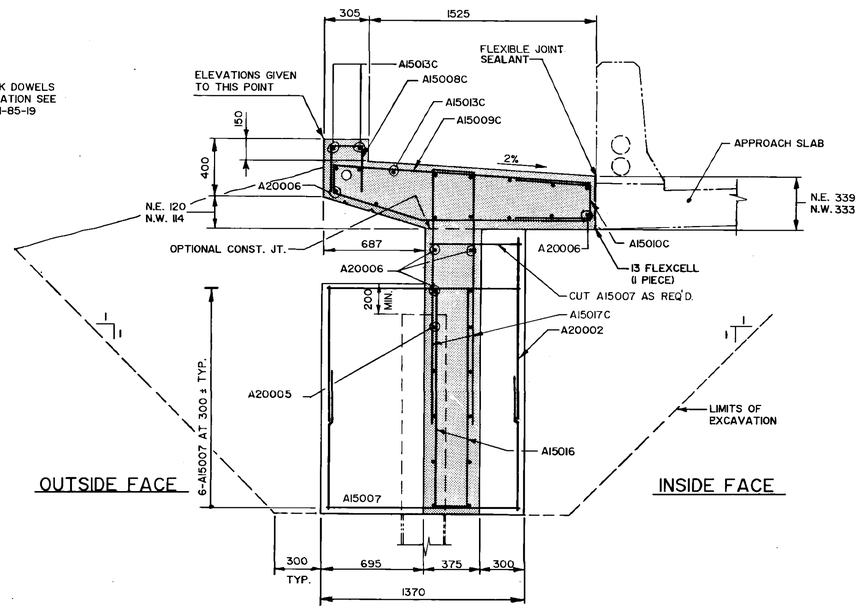

OUTSIDE FACE

INSIDE FACE

SECTION A

SCALE - 1 : 20
(N.W. & N.E. WINGWALLS)

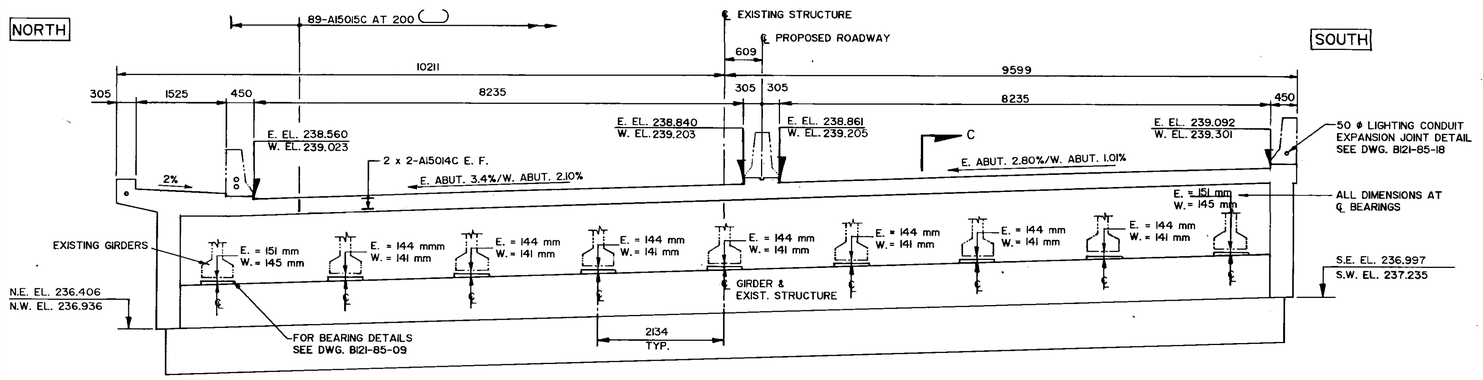

TYPICAL ABUTMENT ELEVATION

SCALE - 1 : 50

NOTE:
EAST ABUTMENT SHOWN
WEST ABUTMENT IS OPP. HAND.

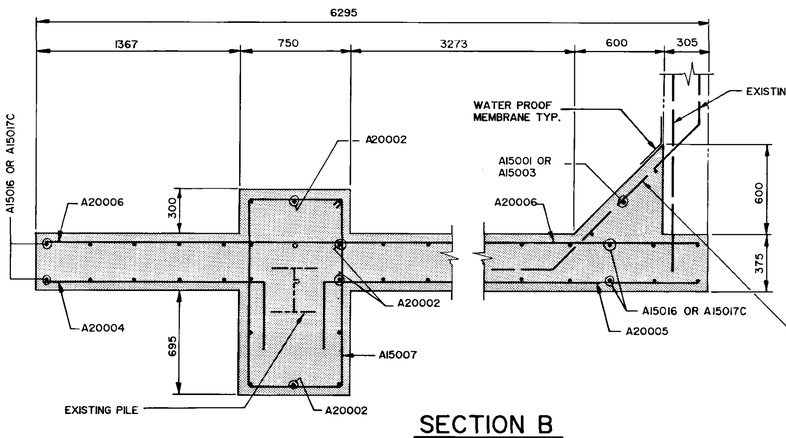

SECTION B

SCALE - 1 : 20

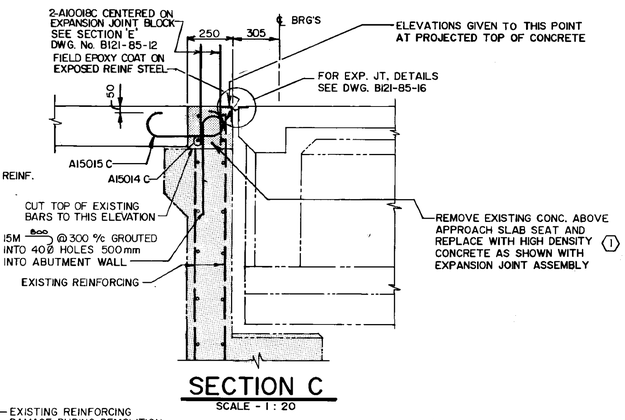

SECTION C

SCALE - 1 : 20

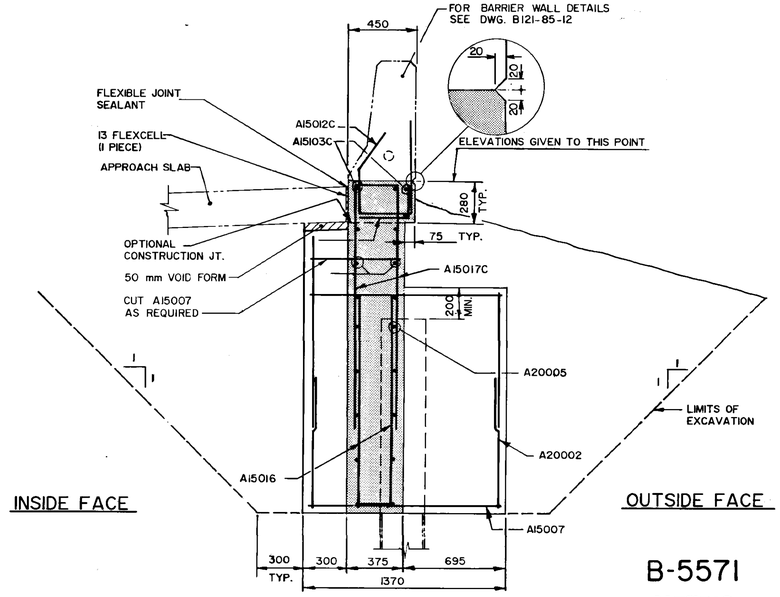

INSIDE FACE

OUTSIDE FACE

SECTION A

SCALE - 1 : 20
(S.W. & S.E. WINGWALLS)

RECORD DRAWING

B-5571

METRIC

WHOLE NUMBERS INDICATE MILLIMETRES
DECIMALIZED NUMBERS INDICATE METRES

NO.	REVISIONS	DATE	APP.
②	RECORD DRAWING	NOV.86	
①	ADDENDUM NO. 1	MAY-85	

PROVINCE OF MANITOBA — K.S. UPPAL — REGISTERED ENGINEER
ENGINEER'S SEAL

the uma group — Underwood McLellan Ltd.
Consulting Engineers and Planners

DESIGNED BY: K.U.	DRAWN BY: E.J.B.
CHECKED BY: J.T.	DATE: APRIL 1985
APPROVED BY:	JOB No. 0265-216-01
	DATE:

THE CITY OF WINNIPEG
WORKS & OPERATIONS DIVISION
STREETS & TRANSPORTATION DEPARTMENT

NAIRN AVENUE OVERPASS

DECK REHABILITATION, STRUCTURAL STRENGTHENING AND RELATED WORKS

ABUTMENT AND WINGWALL MODIFICATIONS

AUTHORIZED BY: STREETS & BRIDGES ENGINEER — DATE 1985-04-16
ACCEPTED BY: BRIDGE ENGINEER — DATE 85 04 16

SCALE: AS SHOWN
DRAWING NO. B121-85-05