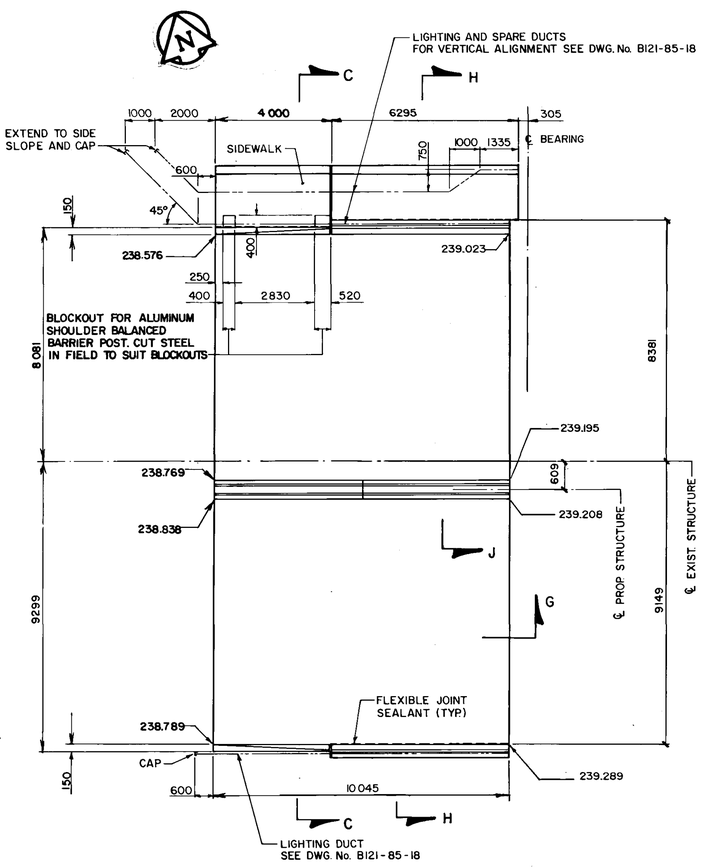

PLAN

SCALE - 1 : 100

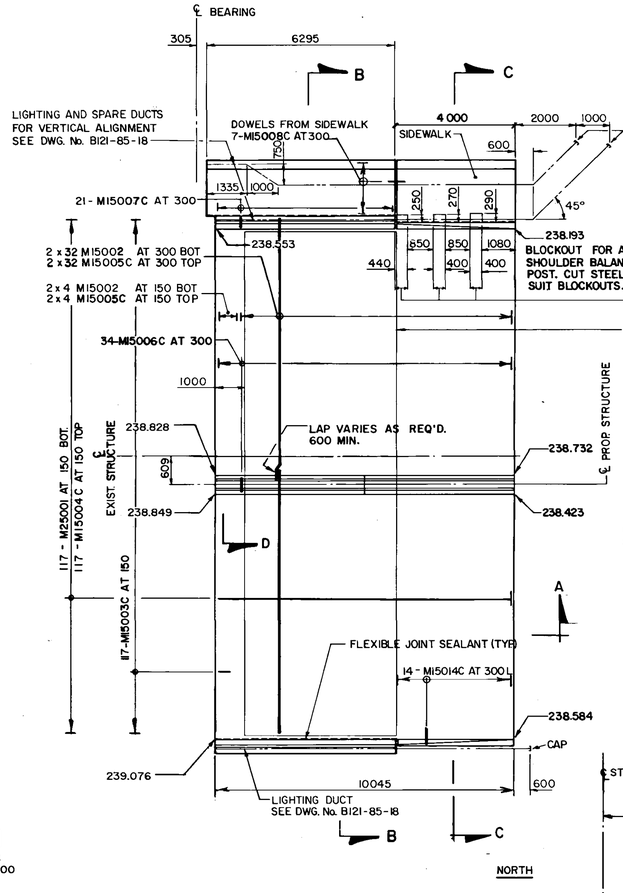

NORTH

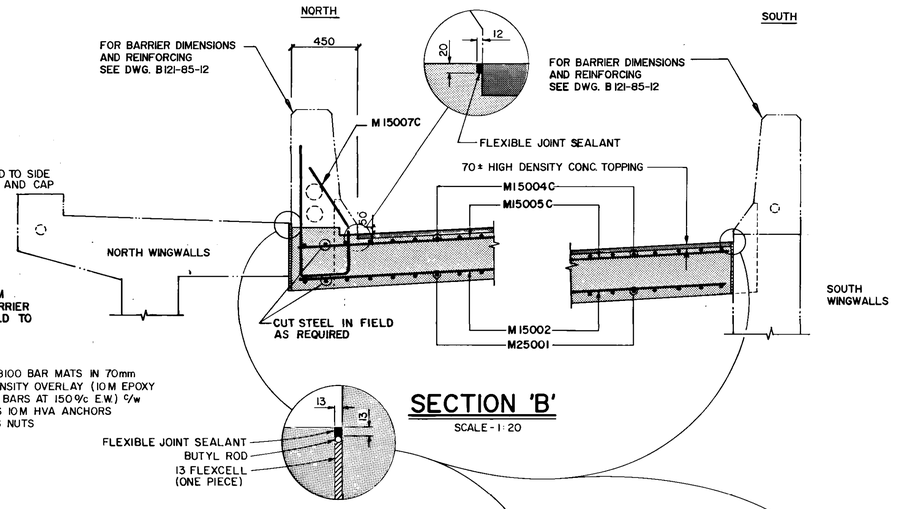

SECTION 'B'

SCALE - 1 : 20

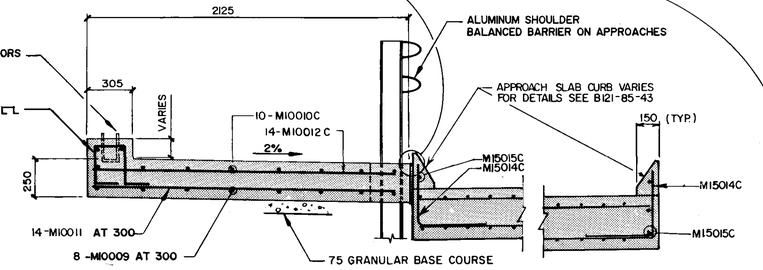

SECTION 'C'

SCALE - 1 : 20

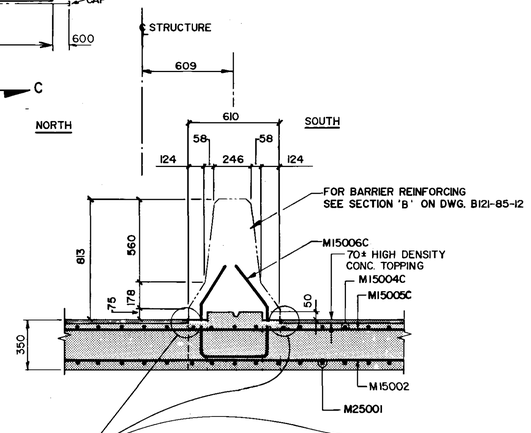

SECTION 'D'

SCALE - 1 : 20

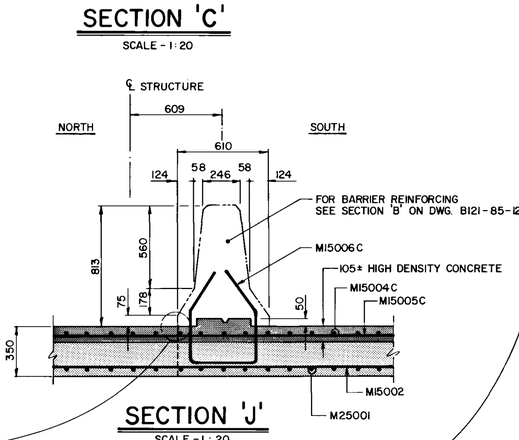

SECTION 'J'

SCALE - 1 : 20

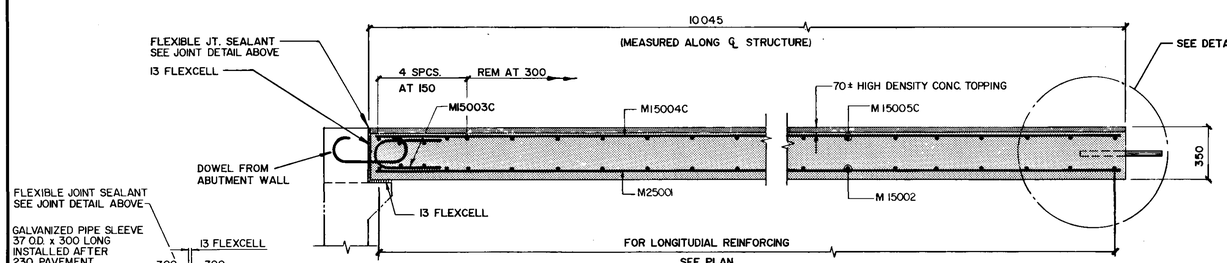

SECTION 'A'

SCALE - 1 : 20

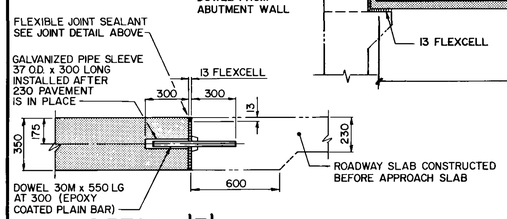

DETAIL 'F'

SCALE - 1 : 20

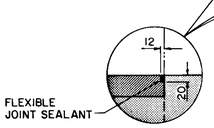

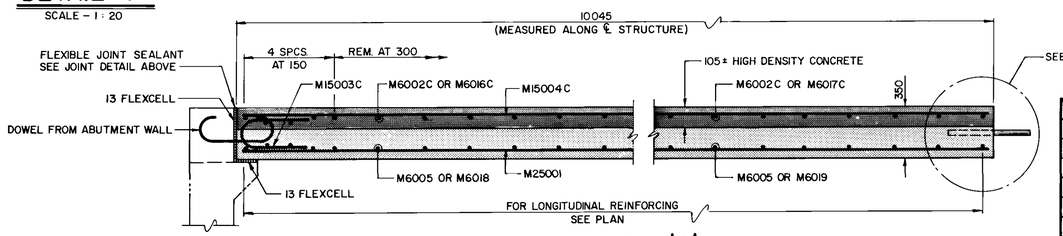

SECTION 'G'

SCALE - 1 : 20

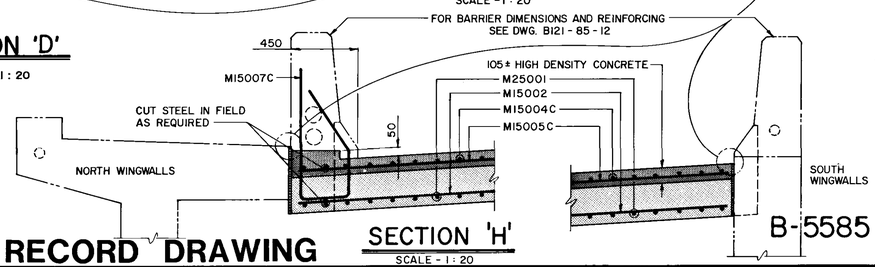

SECTION 'H'

SCALE - 1 : 20

METRIC

WHOLE NUMBERS INDICATE MILLIMETRES
DECIMALIZED NUMBERS INDICATE METRES

RECORD DRAWING

NO	REVISIONS	DATE	APP.
②	RECORD DRAWING	NOV.86	
①	ADDENDUM NO. 1	MAY-85	

PROVINCE OF MANITOBA — K.S. UPPAL — REGISTERED ENGINEER

ENGINEER'S SEAL

the uma group — **Underwood McLellan Ltd.** Consulting Engineers and Planners

DESIGNED BY: K.U.	DRAWN BY: B.H.
CHECKED BY: J.T.	DATE: APRIL 1985
APPROVED BY:	JOB No. 0265-216-01
	DATE: June 15/84

THE CITY OF WINNIPEG
WORKS & OPERATIONS DIVISION
STREETS & TRANSPORTATION DEPARTMENT

NAIRN AVENUE OVERPASS
DECK REHABILITATION, STRUCTURAL STRENGTHENING AND RELATED WORKS.

APPROACH SLAB

AUTHORIZED BY: STREETS & BRIDGES ENGINEER — DATE: 1985-09-16
ACCEPTED BY: BRIDGE ENGINEER — DATE: 1985 09 16
SCALE: AS NOTED
DRAWING NO. B121-85-19

B-5585