


R. M. OF NORTH KILDONAN

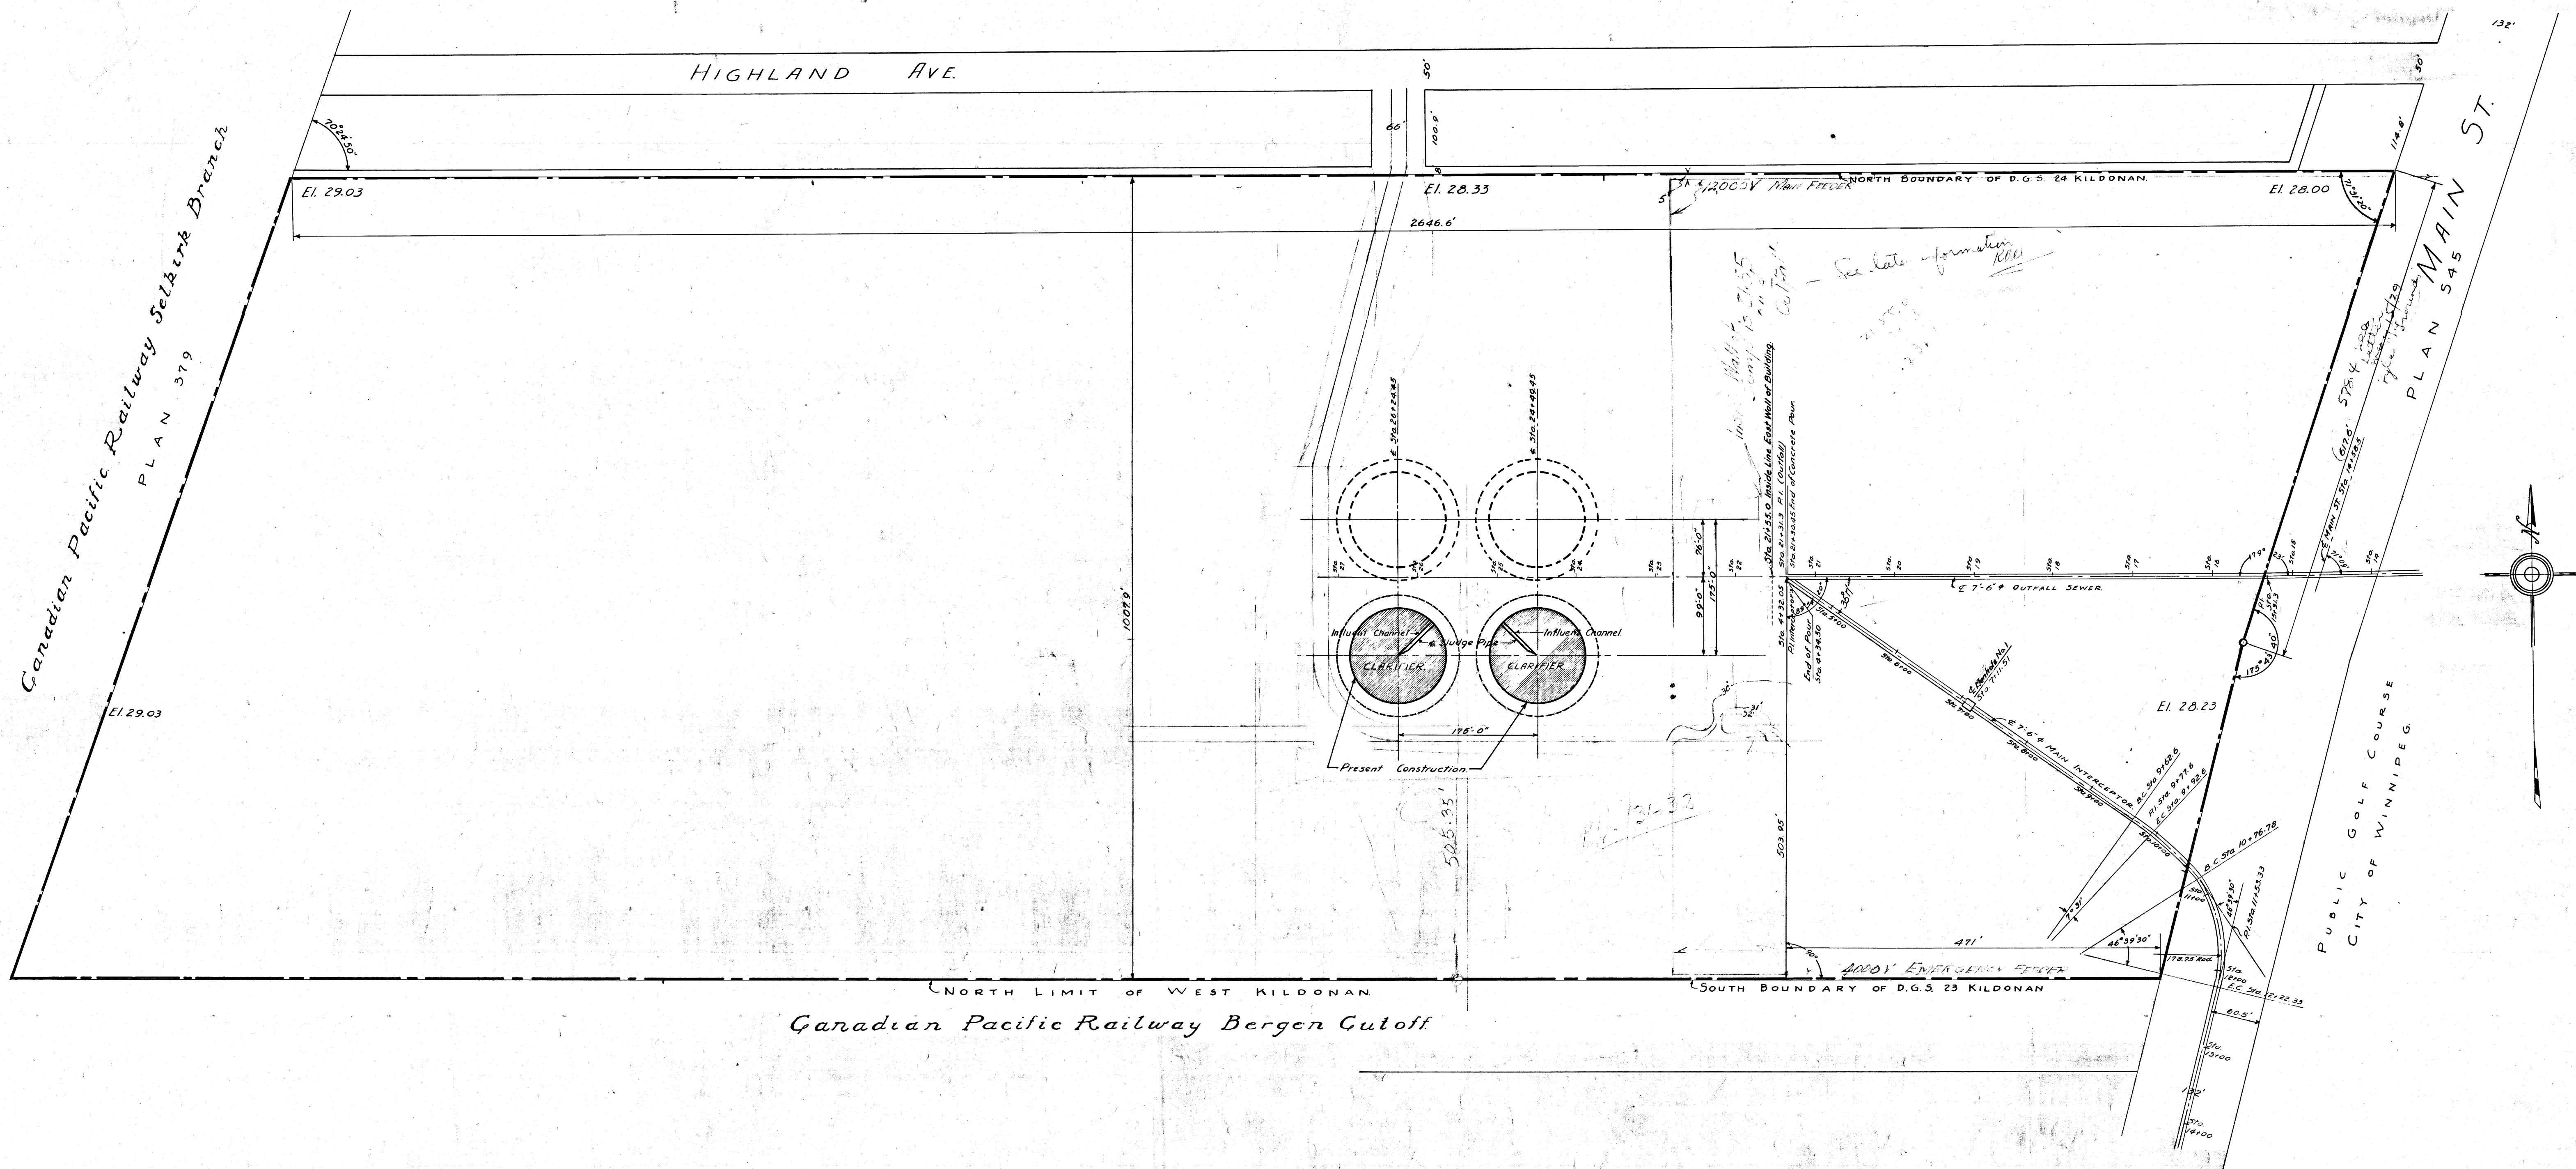

NOTE: CITY OF WINNIPEG ZERO ELEVATION
 EQUALS 727.57 CANADIAN GEODETIC
 SURVEY.
 PLANT SITE BOUNDARIES
 SHOWN THUS.

MICROFILMED

GREATER WINNIPEG SANITARY DISTRICT

W. S. LEA Consulting Engineer	TITLE PLAN SHOWING LOCATION OF STRUCTURE ON PLANT SITE
W. P. SHERBORN, CHIEF ENGINEER J. M. GERRARD, CHIEF ENGINEER C. E. SHERBORN	SCALE 1" = 100' DATE April 29 1936 DRAWN BY CHECKED BY APPROVED BY
W. L. TROTT, CHIEF ENGINEER	PLAN NO. P-2 CONTRACT NO.

NOTES: Revision R, April 29, 1936, Location of Clarifiers Changed.

APPROVED
 W. S. LEA
 Consulting Engineer

FILE # NR12216 NEP-2103

NEP-2103