


FOR CONTINUATION SEE SHEET I4.1

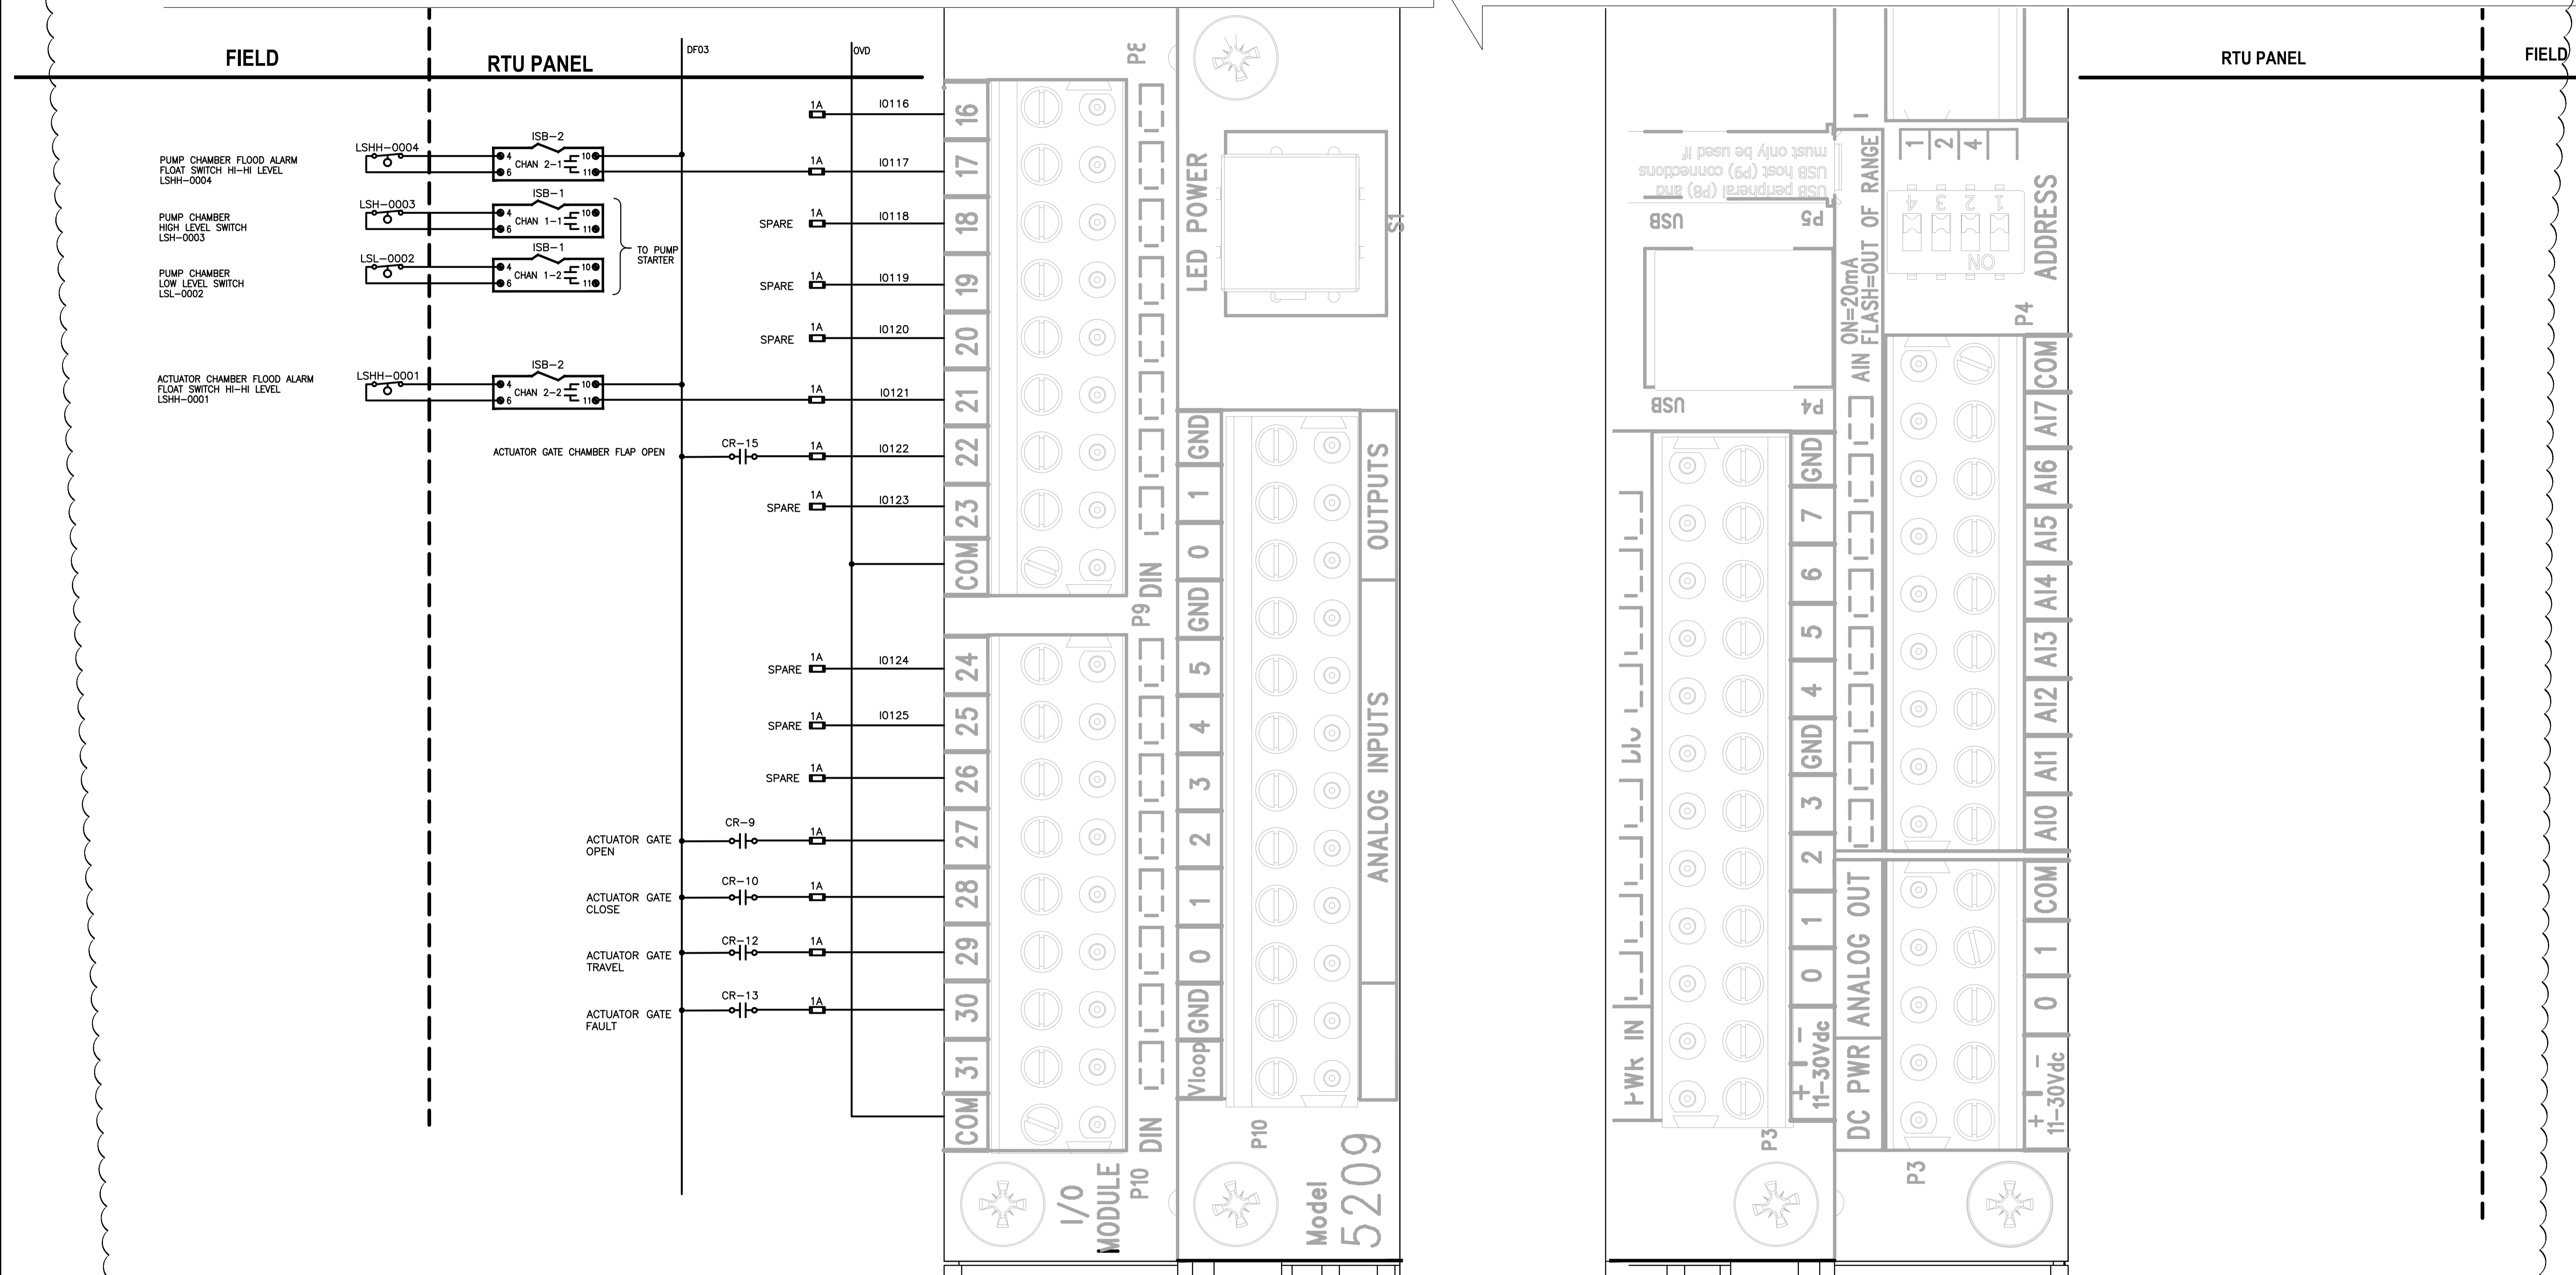

Printed: November 22, 2013 at 1:32:56 PM | Last Saved By: dabosarsky
 File: C:\135513198-000 (McDermott Ave Outfall Gate Chamber)40 - electrical\Sheet14.dwg | Layout: I4.SHT2



DESIGNED BY	M.P.	CHECKED BY	M.P./D.C.
DRAWN BY	R.D.	APPROVED BY	K.H.
HOR. SCALE	AS NOTED	RELEASED FOR CONSTRUCTION	
VERT. SCALE	AS NOTED		
No. REVISIONS	DATE	BY	DATE
	13.10.16		13.10.16

ENGINEER'S SEAL

BID OPPORTUNITY: 912-2013
PLOT DATE: 13.10.16

THE CITY OF WINNIPEG
WASTE AND WATER DEPARTMENT

Winnipeg

OUTFALL GATE CHAMBER UPGRADES

RTU PANEL DIGITAL INPUT CARD 2

CONSULTANT DRAWING No.: I4 - SHT 2 OF 2
SHEET 18 OF 22
CITY DRAWING No.: LD-7263