


NOTES:

1. PANEL DP LOCATED NEAR 600 VOLT DISTRIBUTION/PUMP STARTERS.
2. CONFIRM PANEL SCHEDULE AND UPDATE WITH TYPED PANEL SCHEDULE.
3. INSTALL NEW 15A BREAKER FOR NEW OUTDOOR PUMP HOUSE LIGHTING CIRCUIT.

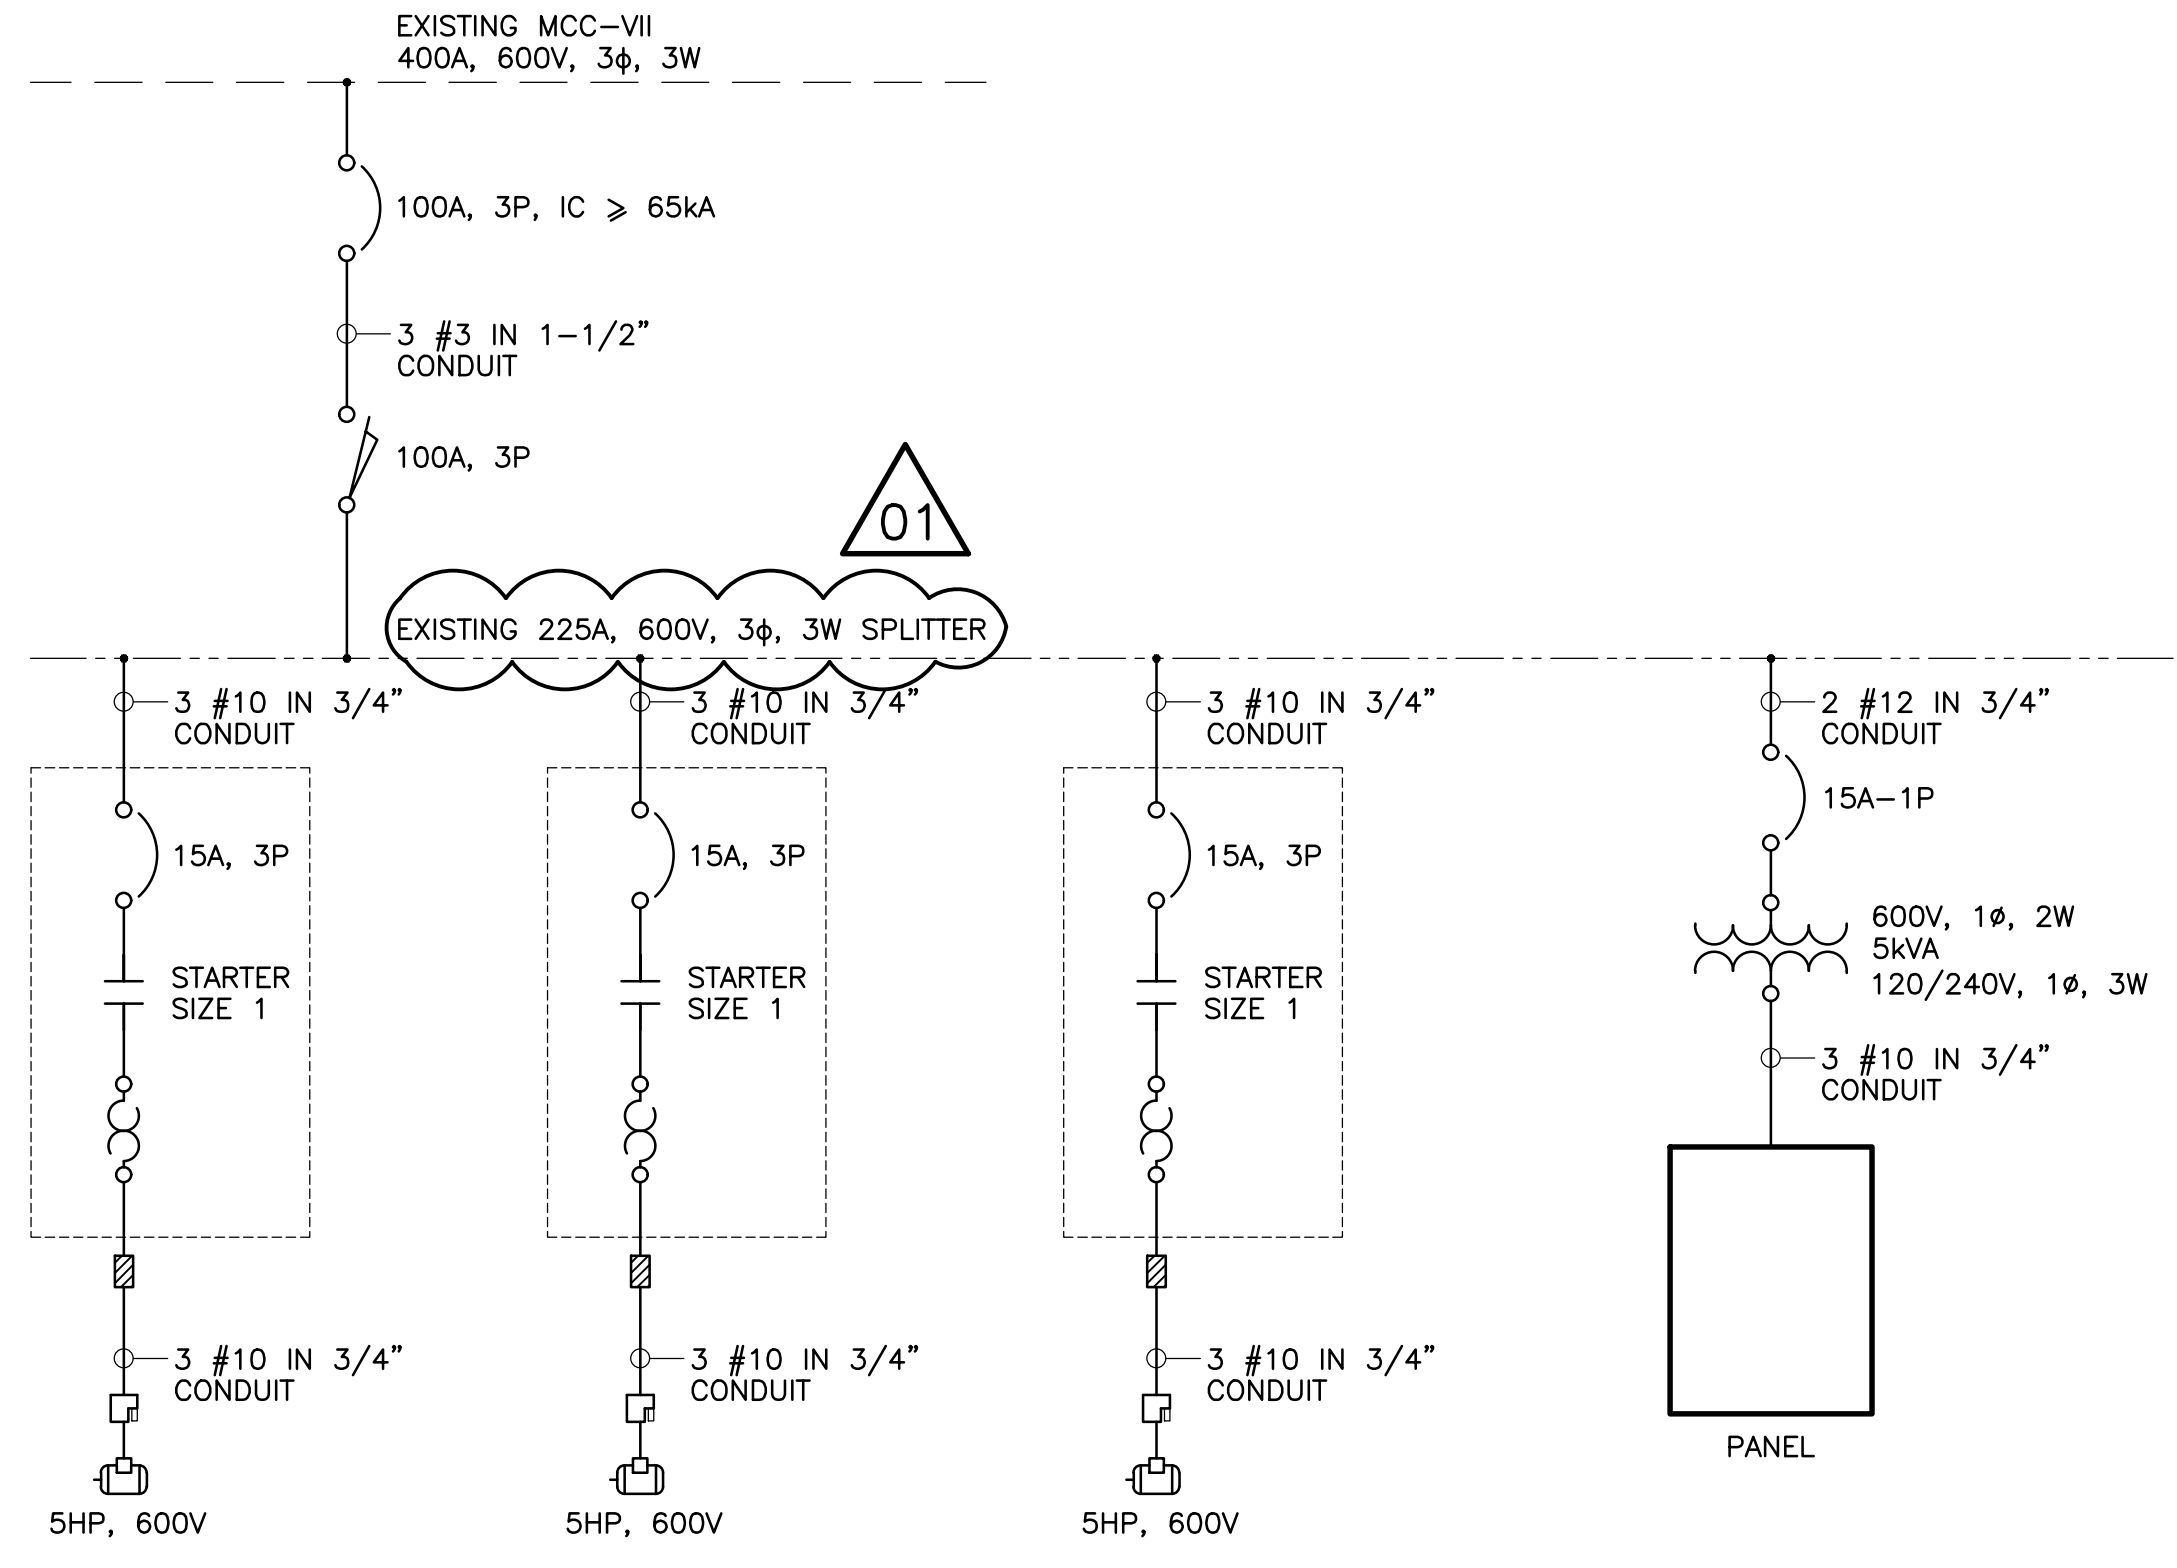

1
- -
EXISTING POWER FOR DIESEL PUMPS
@ 421 OSBORNE ST.
N.T.S.

NOTE 1 NOTE 2

PANEL		100A MAIN BUS		PANEL DP		120/240V, 1φ, 3W		MOUNTING: SURFACE		LOCATION: 421 OSBORNE ST	
DESCRIPTION	CCT.	BRK AMP	A	B	BRK AMP	CCT.	DESCRIPTION	CCT.			
CARD ACCESS/CAMERA	1	15	●	15	2	TANK SOLENOID VALVES					
PARKING LOT POST CAMERA HEATER	3	15	●	15	4	PUMPHOUSE LIGHTS					
PUMP HOUSE EXTERIOR LIGHT	5		●		6	SPACE					
SPACE	7		●		8	SPACE					
SPACE	9		●		10	SPACE					
SPACE	11		●		12	SPACE					

NOTE 3

1429720100-DWG-E0003 ELECTRICAL/ELECTRICAL BLOCK DIAGRAM 1429720100-DWG-E0002 ELECTRICAL FUEL PUMP CONTROL SCHEMATIC 1429720100-DWG-E0001 ELECTRICAL LAYOUT AND DETAILS 1429720100-DWG-E0004 ELECTRICAL DIAGRAMS & PANEL SCHEDULE		SUB CONSULTANT(S) NO. DATE DESCRIPTION PREPARED REVIEW DESIGN AUTHORIZE	PERMIT STAMP TETRA TECH WEI Inc. No. 5313 Date: April 30, 2015	SEAL ORIGINAL DRAWING REVISION "00" SEALED BY N.E. CRAWFORD 14.09.05	DESIGNED BY: N.C. AUTHORIZED BY: A.R. PREPARED BY: H.A. DATE: 14.07.31 REVIEWED BY: N.C. SCALE: AS NOTED	CLIENT: CITY OF WINNIPEG TRANSIT DEPARTMENT	PROJECT NAME: CITY OF WINNIPEG - FORT ROUGE GARAGE DIESEL FUEL STORAGE CAPACITY INCREASE DRAWING DESCRIPTION: ELECTRICAL DIAGRAMS AND PANEL SCHEDULE	DRAWING NO: 1429720100-DWG-E0004 REV: 01
--	--	--	--	--	---	---	---	--