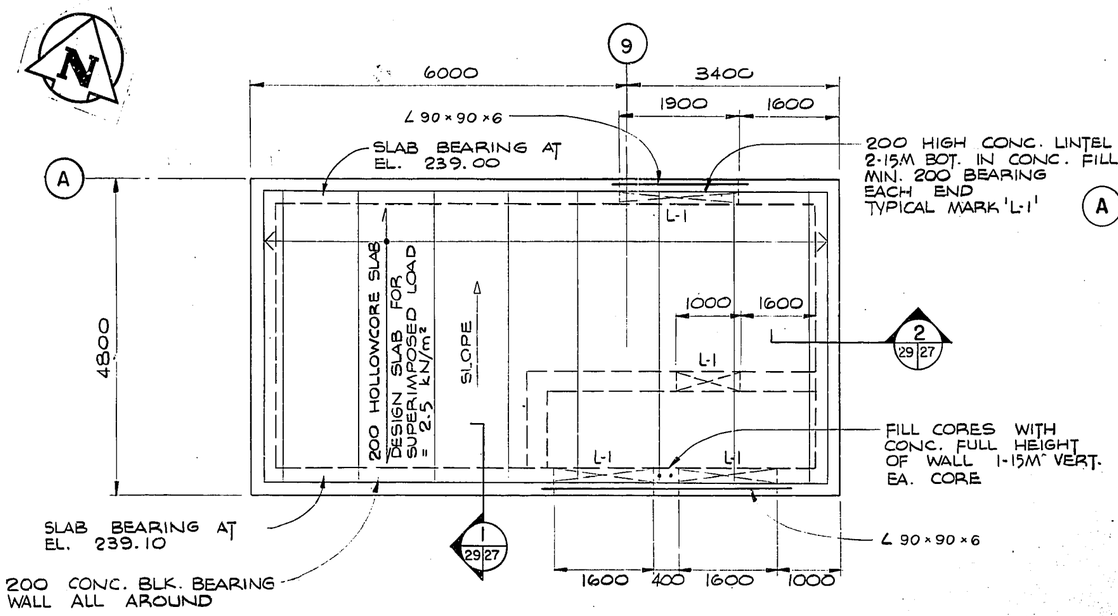

ENTRANCE HOUSE ROOF FRAMING PLAN

1:50

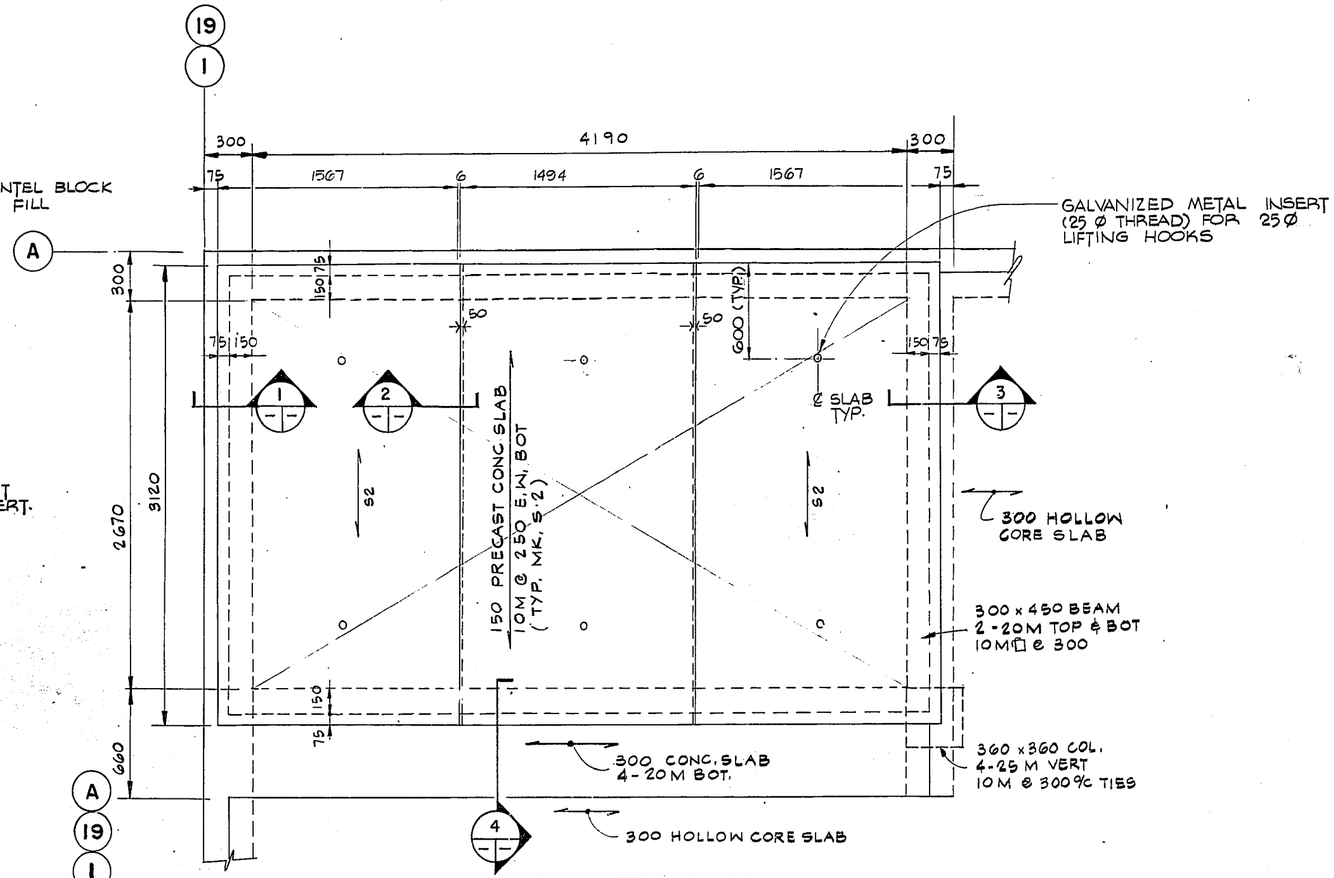

ROOF ACCESS FRAMING PLAN

1:20

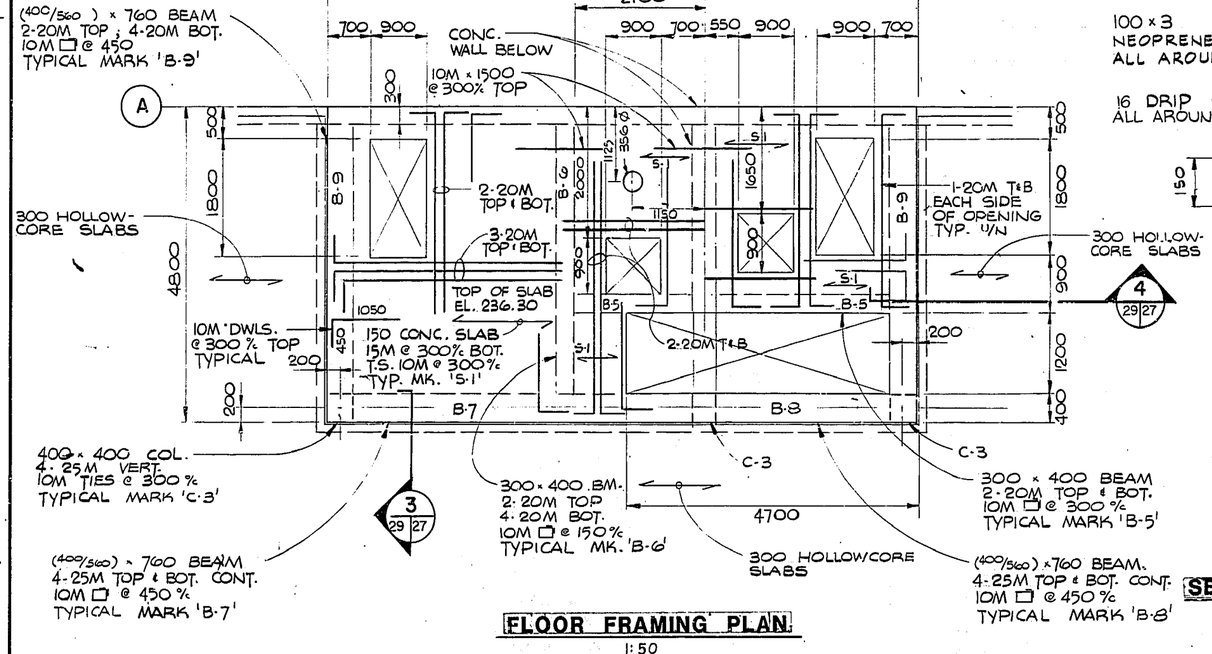

FLOOR FRAMING PLAN

1:50

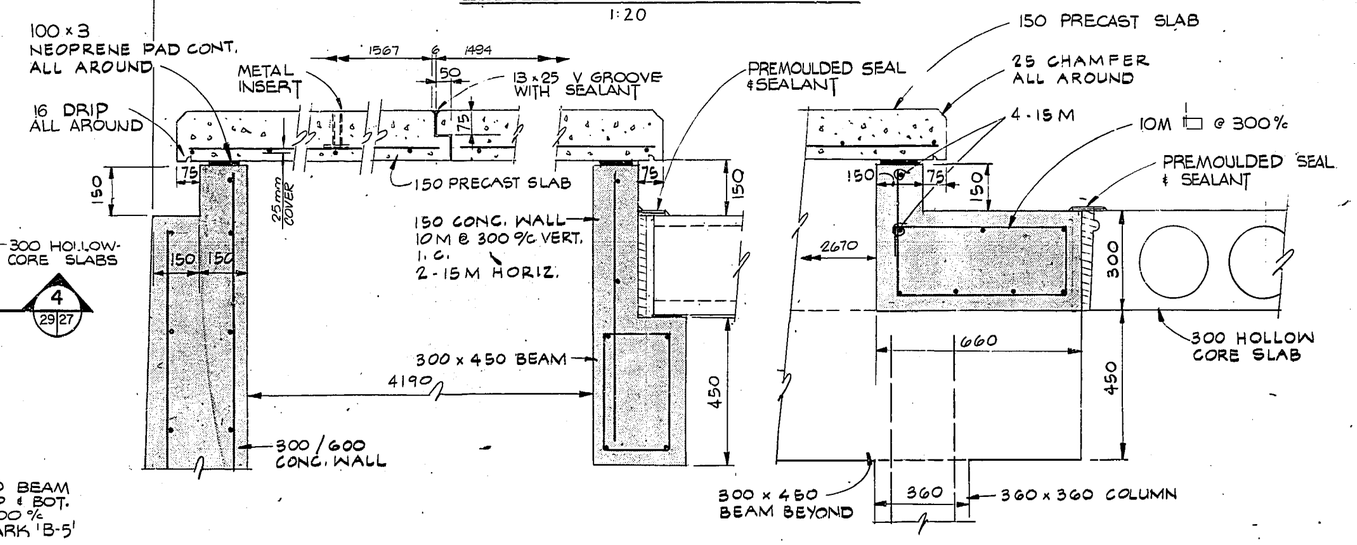

SECTION 1 — 1:10

SECTION 2 — 1:10

SECTION 3 — 1:10

SECTION 4 — 1:10

RECORD DRAWING

MICROFILMED

METRIC NOTES

WHOLE NUMBERS IND. MILLIMETRES

DECIMALIZED EXPRESSIONS IND. METRES

PROVINCE OF MANITOBA — R. M. MUZYK — REGISTERED ENGINEER

NO.	REVISIONS	DATE	APP.
2	RECORD DRAWING	DEC 81	EEL
1	ADDENDUM NO.1	22 APR 80	HH

PROVINCE OF MANITOBA — H. T. HUNG — 20/3/80 — REGISTERED ENGINEER

ENGINEER'S SEAL

Underwood McLellan Ltd. — Consulting Engineers and Planners — the umm group

DESIGNED BY:	DRAWN BY:
H.T.H.	T. H.
CHECKED BY:	DATE: MARCH 20, 1980
APPROVED BY:	DATE: 20/3/80

THE CITY OF WINNIPEG

WORKS & OPERATIONS DEPARTMENT

WATERWORKS, WASTE & DISPOSAL DIVISION

WILKES AVENUE RESERVOIR RECONSTRUCTION

ROOF ACCESS DETAILS ENTRANCE HOUSING, ROOF AND FLOOR FRAMING

RELEASED FOR CONSTRUCTION: DATE: 20/03/80

SCALE: AS NOTED

DRAWING NO: WIL-27

REV.2