WO 101-84

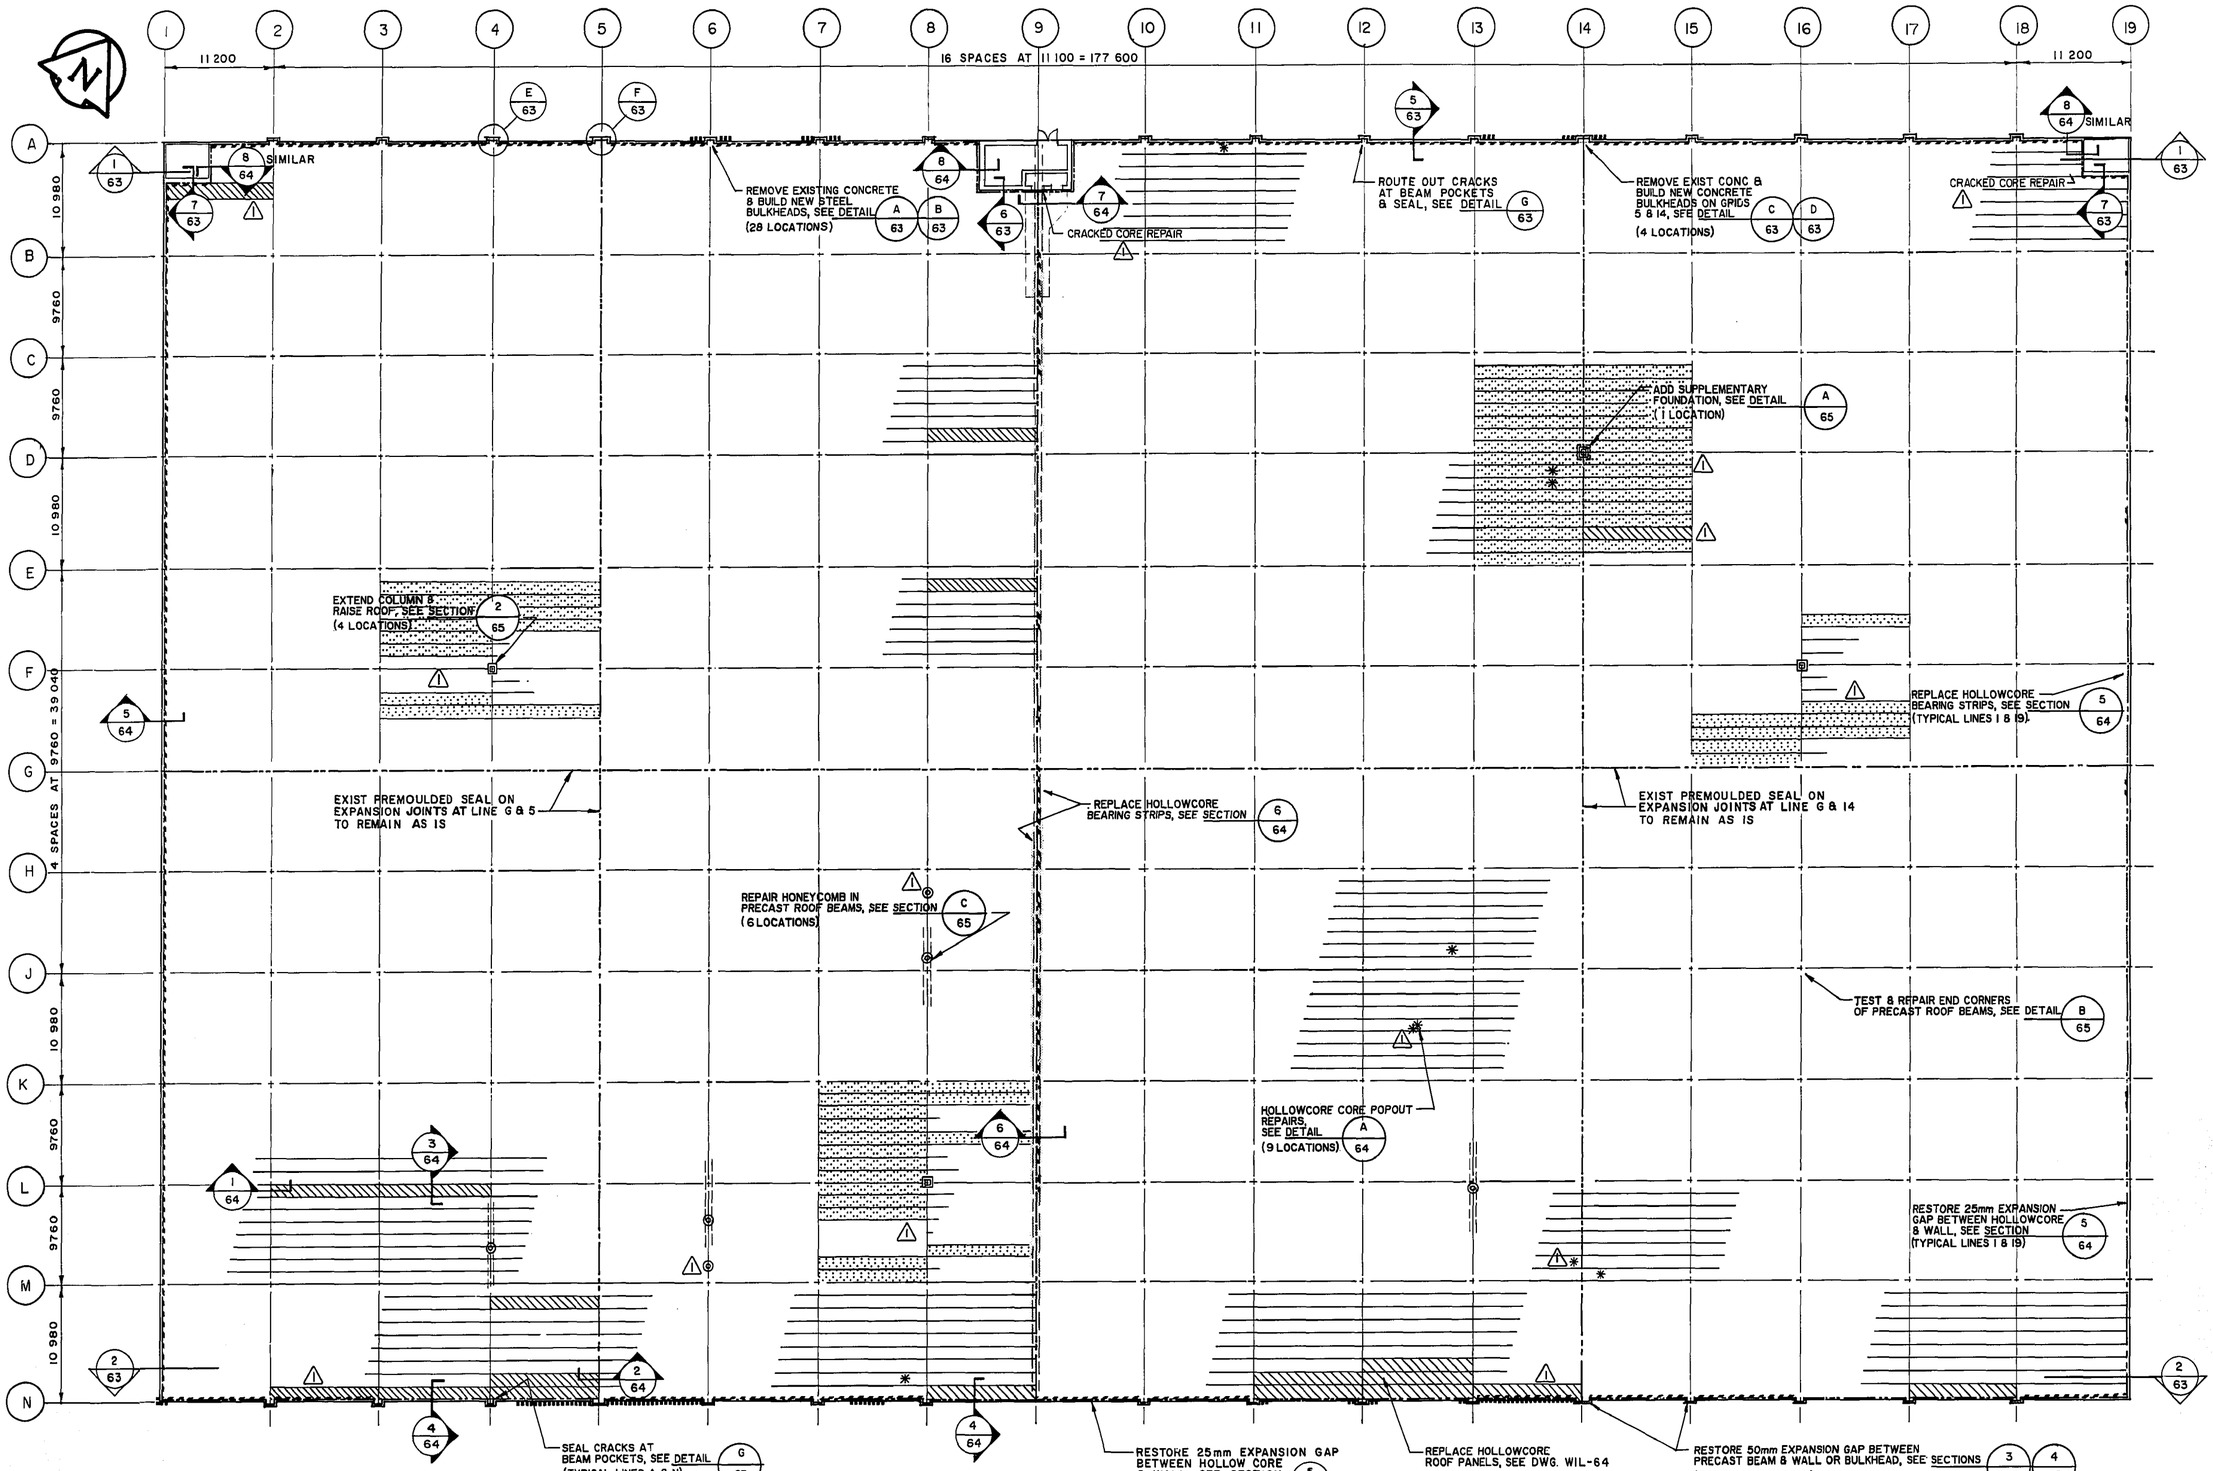

LEGEND		WEST CELL	EAST CELL
	REPLACE HOLLOWCORE SLAB	11	8
	REPLACE H.C. BEARING STRIPS	GRID LINES 1,9 & 19	
	EXTEND COLUMN	2	2
	REPAIR HONEYCOMB IN ROOF BEAM	5	1
	REPAIR H.C. POPOUT	1	8
	ADD FOUNDATION	0	1 (@ D-14)
	SAW-CUT EXPANSION JOINT	AS SHOWN	
	WALL REPAIR	AS SHOWN	
	CRACKED HOLLOWCORE REPAIRS	AS SHOWN	

RECORD DRAWING P.D. No. 91-19

LOCATION APPROVED
UNDERGROUND STRUCTURES

SUPV U/G STRUCTURES COMMITTEE — DATE

NOTE:
LOCATION OF UNDERGROUND STRUCTURES AS SHOWN ARE BASED ON THE BEST INFORMATION AVAILABLE BUT NO GUARANTEE IS GIVEN THAT ALL EXISTING UTILITIES ARE SHOWN OR THAT THE GIVEN LOCATIONS ARE EXACT. CONFIRMATION OF EXISTENCE AND EXACT LOCATION OF ALL SERVICES MUST BE OBTAINED FROM THE INDIVIDUAL UTILITIES BEFORE PROCEEDING WITH CONSTRUCTION.

B.M. ELEV.

NO	REVISIONS	DATE	BY
1	TO RECORD DRAWING	10/91	A.M.U.

UMA Engineering Ltd. Engineers & Planners
1479 Buffalo Place, Winnipeg, Manitoba, Canada R3T 1L7

DESIGNED BY S. S. B. — CHECKED BY
DRAWN BY K. J. L. — APPROVED BY
HOR SCALE 1:300 VERTICAL — RELEASED FOR CONSTRUCTION
DATE 1991-01-31 — DATE 1991 02 15

ENGINEER'S SEAL: PROVINCE OF MANITOBA — BISWANGER — 91/02/15 — REGISTERED PROFESSIONAL ENGINEER

CONSULTANT DRAWING NO. 41 13 0265 259 02

THE CITY OF WINNIPEG
WORKS AND OPERATIONS DIVISION
WATERWORKS, WASTE & DISPOSAL DIVISION

WILKES RESERVOIR
PHASE II CONSTRUCTION
STRUCTURAL WORKS

GENERAL PLAN

CITY DRAWING NUMBER
SHEET 2 OF 5
WIL-62

Title # RE 10316

41 13 0265 259 02
WIL-62
P.D. 91-19

WIL-62

Title # RE 10316