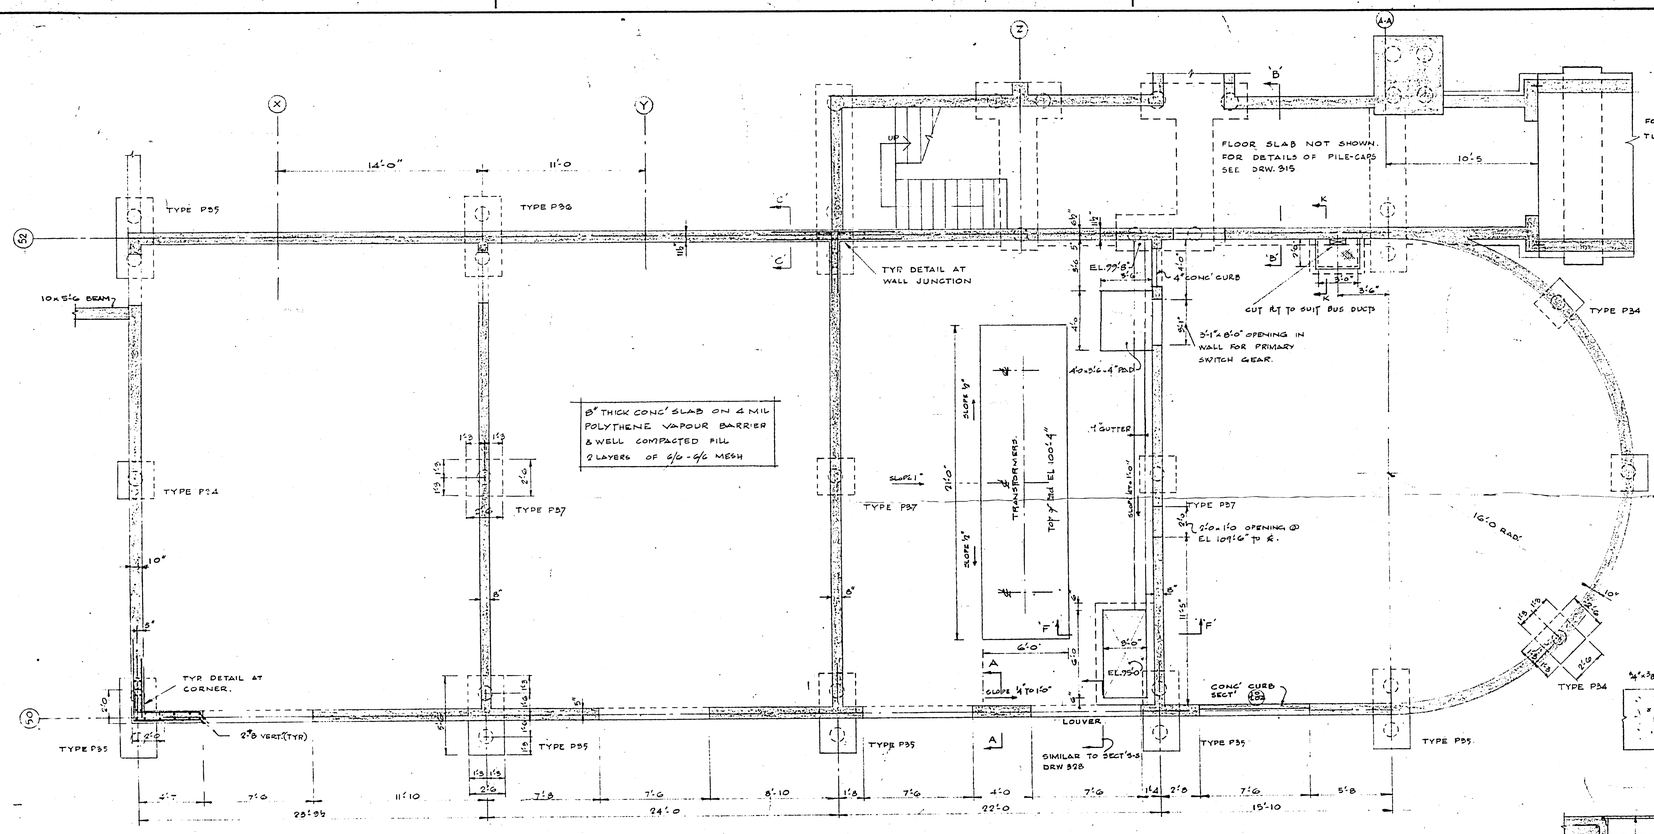

—FOUNDATION PLAN—

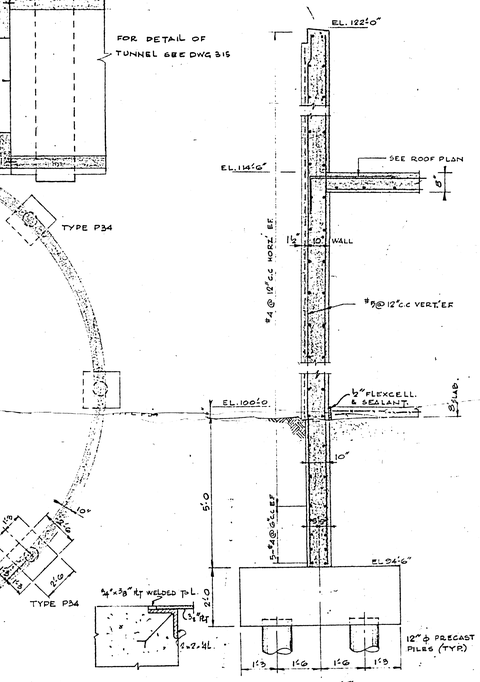

SECTION 'A-A'
½" TO 1'-0

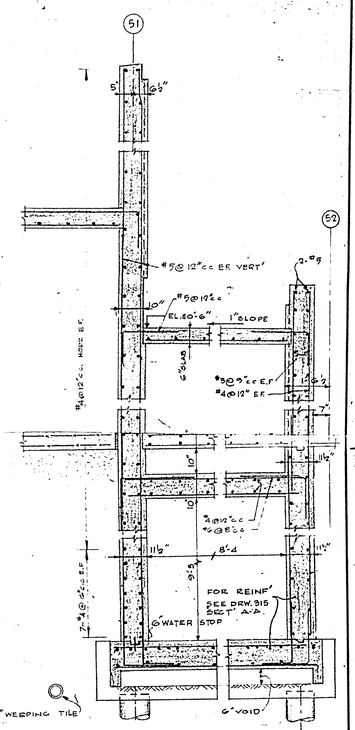

SECTION B-B

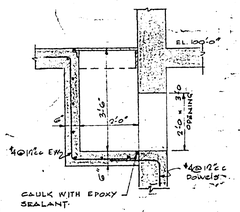

SECTION K-K

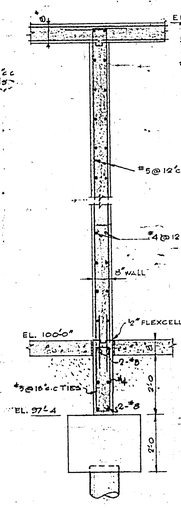

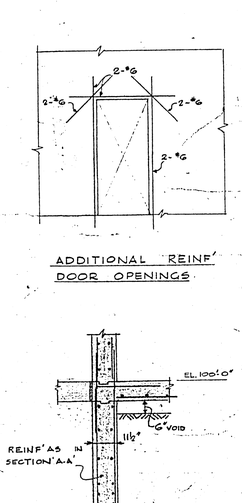

ADDITIONAL REINF' DOOR OPENINGS

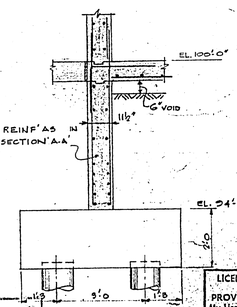

SECTION C-C

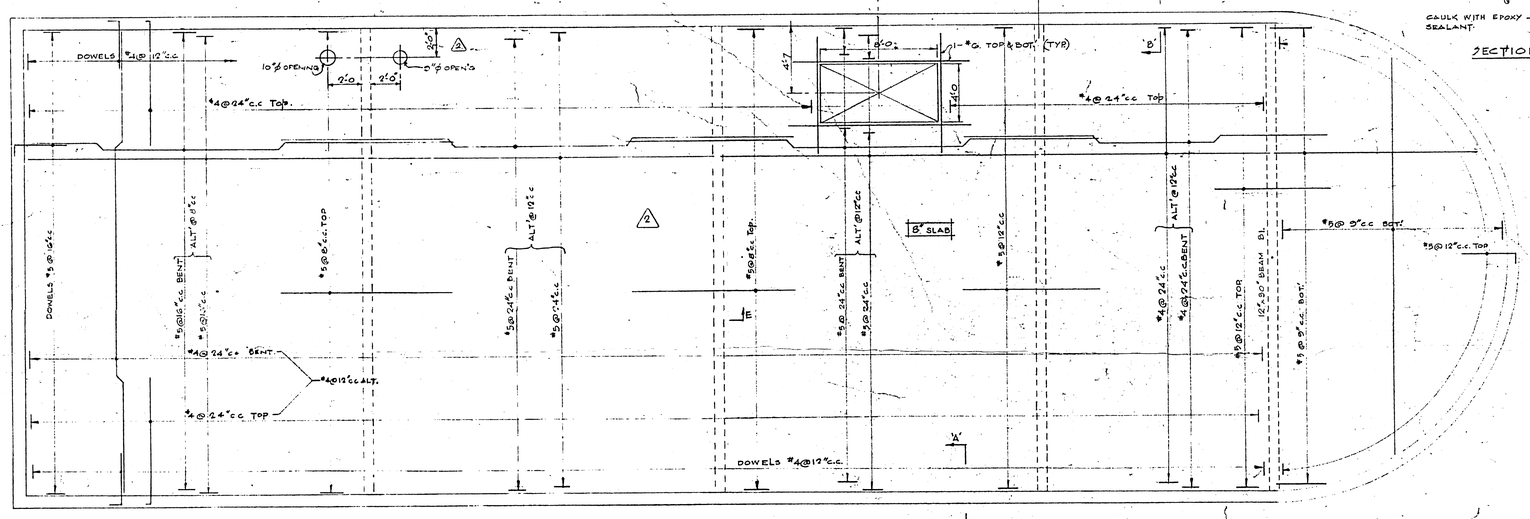

—ROOF PLAN— ¼" TO 1'-0

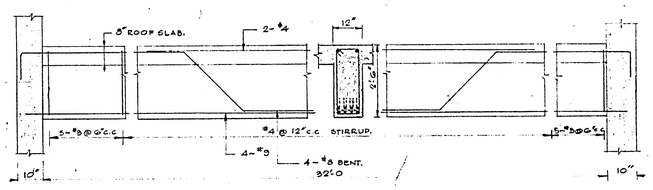

DETAIL OF BEAM 'B1'
ONE REQ'D.

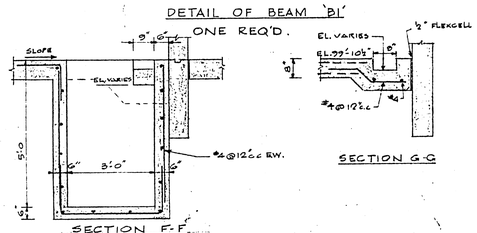

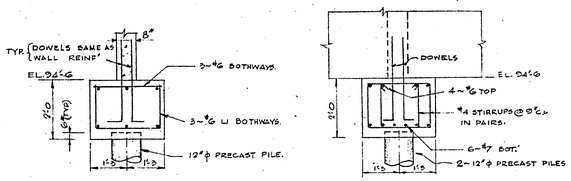

TYPE P34 ~ 4 REQ'D.

TYPE P35 ~ 5 REQ'D

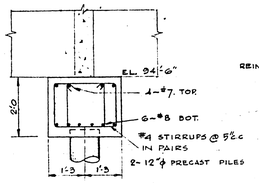

TYPE P36 ~ ONE REQ'D.

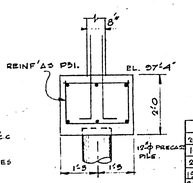

TYPE P37 ~ 3 REQ'D

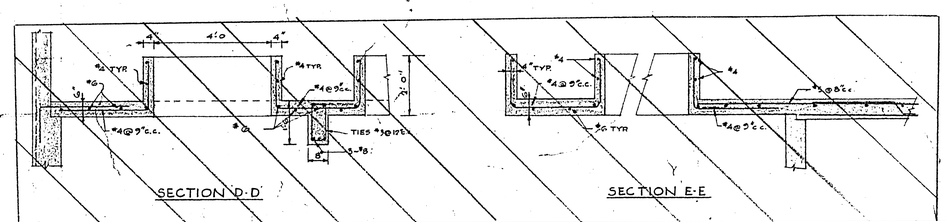

TYP DETAIL OF INTERIOR WALL

DATE	ISSUE NO.	REV. NO.	DESCRIPTION	DRAWN BY
25-11-69			AS BUILT	R.H.T.
16.5.68	4	⚠	ROOF OPENINGS FOR HEATER & SMOKE VENTS DELETED.	R.H.
24.3.68	3	1	REVISED PER ADDENDA 1 & 2 — FOR CONSTRUCTION	R.H.
19 JAN 68	2		FOR TENDER	
20 OCT 67	1		FOR APPROVAL.	

ISSUE OR REVISION

METROPOLITAN CORPORATION OF GREATER WINNIPEG
STREETS AND TRANSIT DIVISION

TRANSIT STORAGE AND SHOP FACILITIES

UTILITY BLOCK

FOUNDATION & ROOF PLAN

CONSULTING PROFESSIONAL ENGINEERS
A. D. MARGISON AND ASSOCIATES LIMITED
1155 LESLIE STREET, DON MILLS, ONTARIO

ARCHITECTS
Waisman Ross • Blankstein Coop Gillmor Hanna
10 DONALD STREET, WINNIPEG, MANITOBA

APPROVED
DEPUTY DIRECTOR OF STREETS AND TRANSIT

DRAWN BY R.S.H.
CHECKED
FILE No.
SHEET No.
DATE SEPT 67
SCALE ¼" TO 1'-0 UNLESS NOTED
DRAWING No. 2185 - 316 STRUCTURAL

LICENSED TO PRACTICE IN THE PROVINCE OF MANITOBA
My Licence Expires 10 Jan. 1969

2185 - 316

ASSOCIATE PROFESSIONAL ENGINEER K. MOUNTAIN PROVINCE OF ONTARIO

B-14
FILE
RECEIVED CITY PLANNING BUILDING INSPECTION
2 91 1

N.W.C.L. TRANSTEK 10 600-8-68