

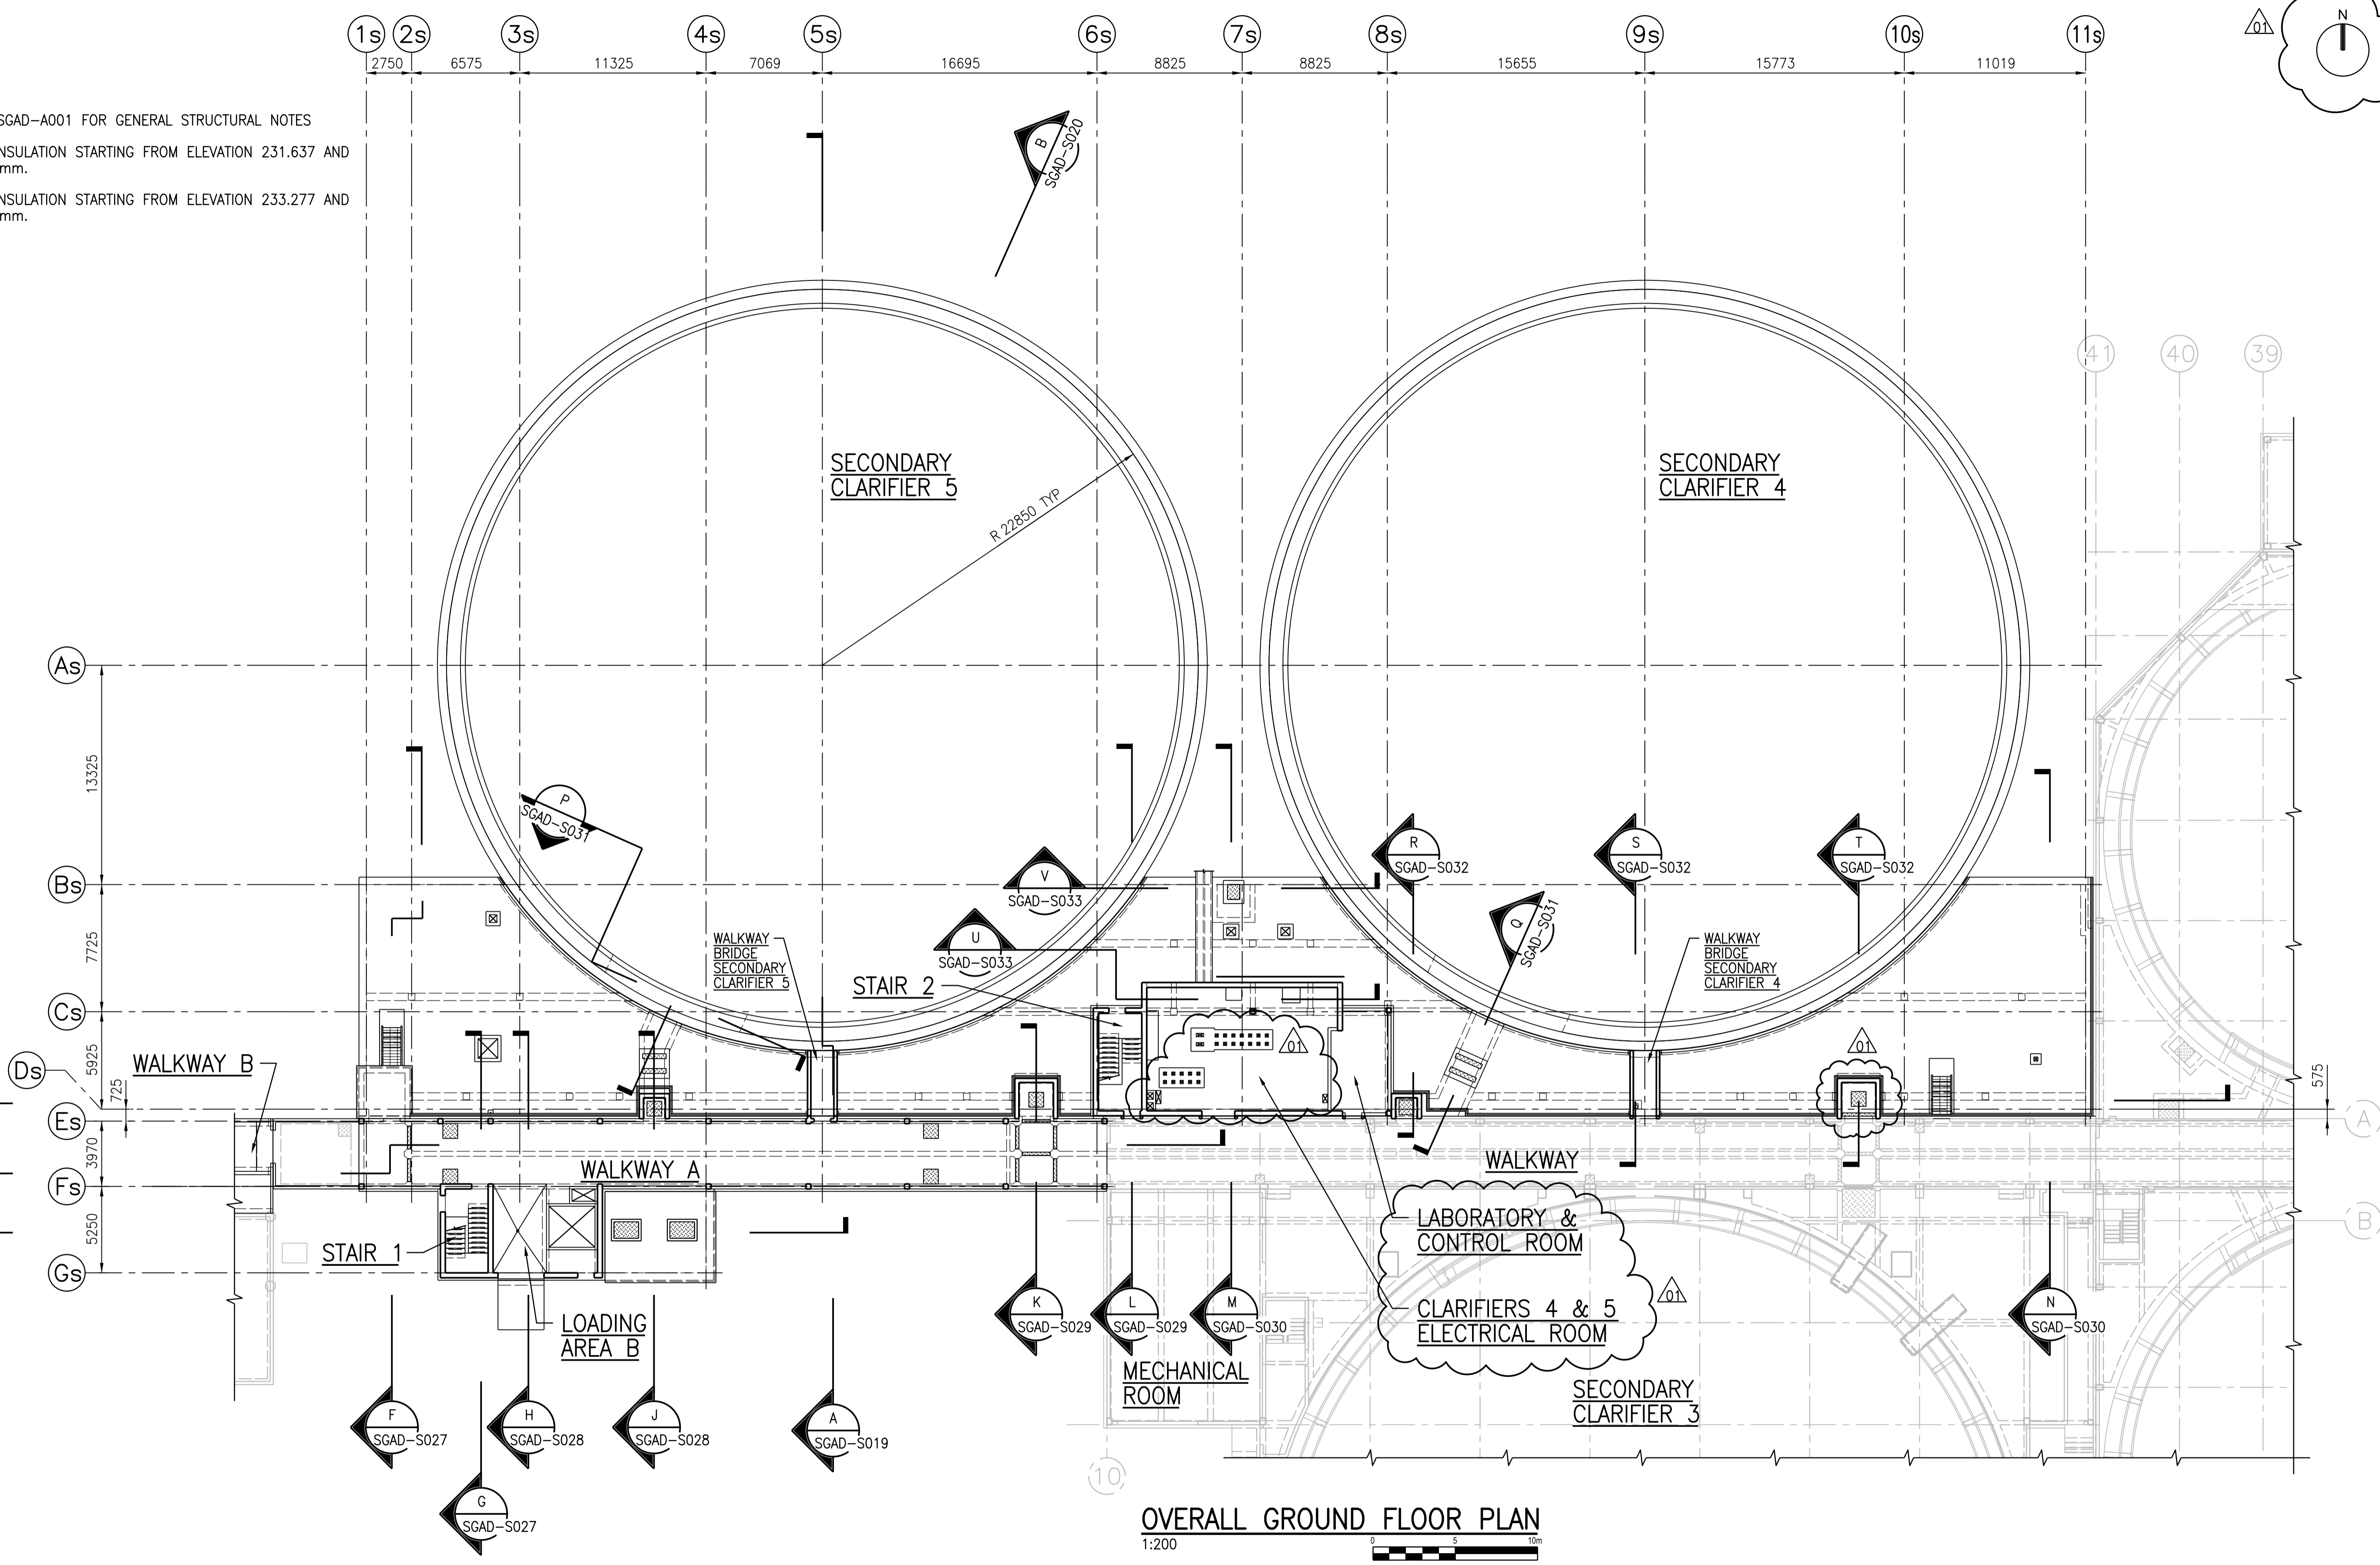


**NOTES:**

1. REFER TO DRAWING SGAD-A001 FOR GENERAL STRUCTURAL NOTES
2. INSTALL PERIMETER INSULATION STARTING FROM ELEVATION 231.637 AND CARRIED DOWN 2200mm.
3. INSTALL PERIMETER INSULATION STARTING FROM ELEVATION 233.277 AND CARRIED DOWN 2900mm.

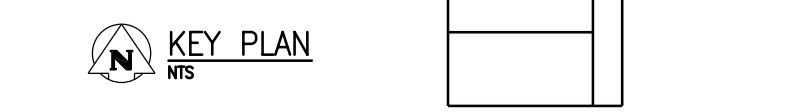

**OVERALL GROUND FLOOR PLAN**  
1:200

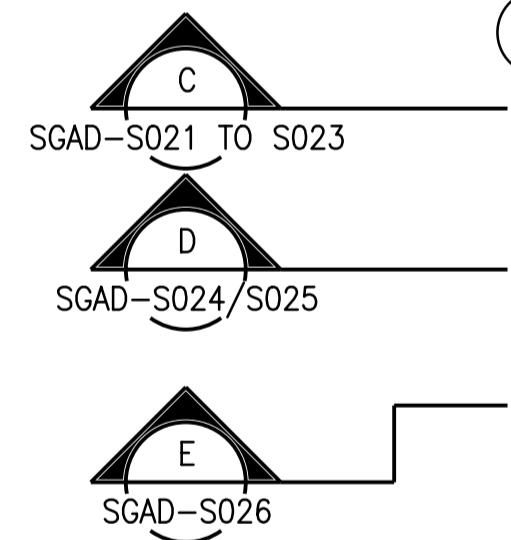

**APEGM**  
Certificate of Authorization  
CH2M HILL Canada Ltd.  
No. 1441

NO.	REVISIONS	DATE	DESIGN	CHECK
01	ISSUED FOR ADD. 2 - B.O. 899-2015	02/2016	G.O.	J.C.
00	ISSUED FOR TENDER - B.O. 899-2015	01/2016	G.O.	J.C.

<b>CH2MHILL</b>		<b>KGS</b>	
SNC-LAVALIN		GROUP OF CONSULTING ENGINEERS	
DESIGNED BY: A. THAKKAR	CHECKED BY: E. LUI	DATE: 2016/01/29	
DRAWN BY: G. OMORI	APPROVED BY: H.T. FREIHAMMER	DATE: 2016/01/29	
SCALE: 1:200		ISSUED FOR CONSTRUCTION	
DATE: 2016/01/29		BY: T. TURZAK	
CONSULTANT NO.: 474248		DATE: 2016/01/29	

ENGINEER'S SEAL  
24/02/2016  
PROVINCE OF MANITOBA  
S.L.E. LUI  
Member 37003  
REGISTERED PROFESSIONAL ENGINEER

<b>THE CITY OF WINNIPEG</b> Winnipeg WATER AND WASTE DEPARTMENT		
SOUTH END WATER POLLUTION CONTROL CENTRE SEWPPC UPGRADING/EXPANSION PROJECT STRUCTURAL SECONDARY CLARIFIERS 4 AND 5 OVERALL GROUND FLOOR PLAN		
CITY DRAWING NUMBER 1-0102-SGAD-S011	SHEET 001	REV. SIZE 01 A1