A1 SIZE – 594mm x 841mm

©CH2M HILL 2015. ALL RIGHTS RESERVED.

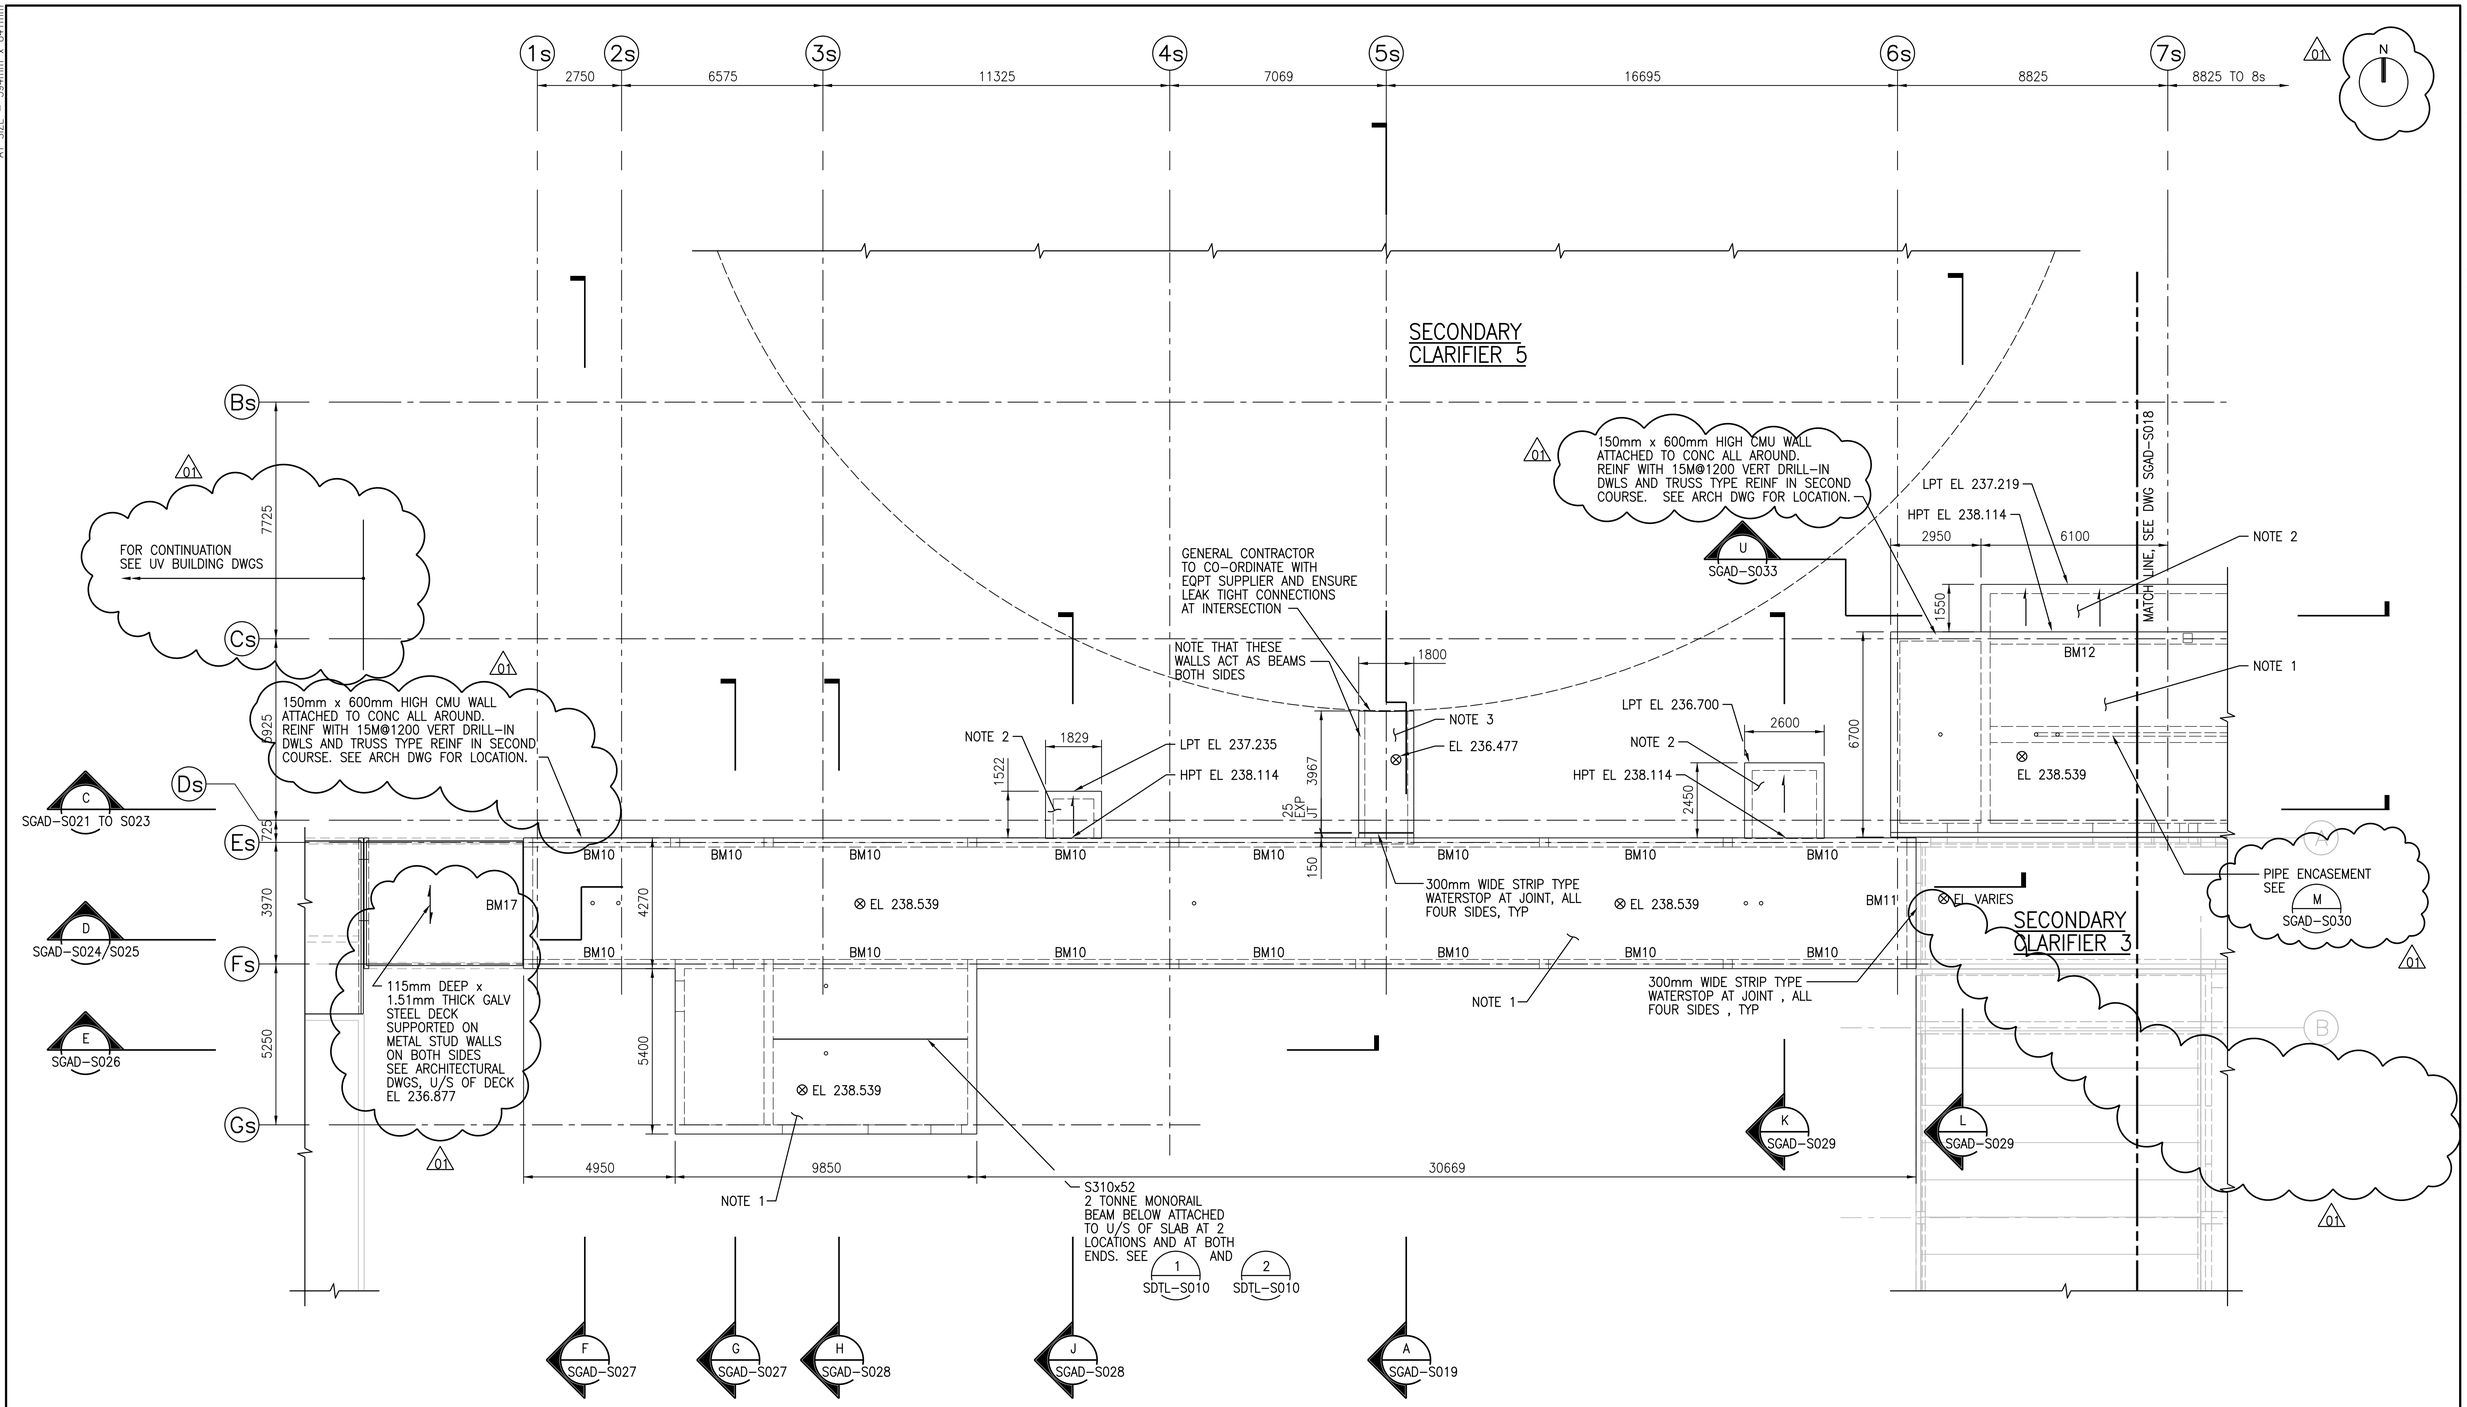

ROOF PLAN – PART A

1:100

NOTE:

1. DESIGN SUPERIMPOSED LL=1KPa
   DESIGN SUPERIMPOSED SNOW LOAD=3KPa
   DESIGN SUPERIMPOSED PIPE HANGER LOAD=1.0KPa
2. DESIGN SUPERIMPOSED SNOW LOAD=5.0KPa
3. DESIGN SUPERIMPOSED LL=1KPa
   DESIGN SUPERIMPOSED SNOW LOAD=5KPa
   DESIGN SUPERIMPOSED PIPE HANGER LOAD=2KPa

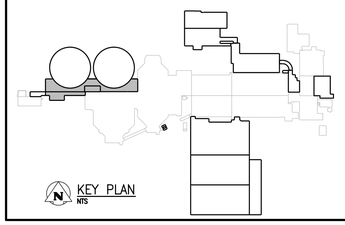

APEGM
Certificate of Authorization
CH2M HILL Canada Ltd.
No. 1441

NO.	REVISIONS	DATE	DESIGN	CHECK
01	ISSUED FOR ADD. 2 – B.O. 899-2015	02/2016	G.O.	J.C.
00	ISSUED FOR TENDER – B.O. 899-2015	01/2016	G.O.	J.C.

CH2MHILL
SNC·LAVALIN
KGS GROUP

DESIGNED BY: A. THAKKAR	CHECKED BY: E. LUI
DRAWN BY: G. OMORI	APPROVED BY: H.T. FREIHAMMER
SCALE: 1:100	ISSUED FOR CONSTRUCTION BY: T. TURZAK
DATE: 2016/01/29	DATE: 2016/01/29
CONSULTANT NO.: 474248	

ENGINEER'S SEAL
24/02/2016
PROVINCE OF MANITOBA
S.L.E. LUI
Member 37003
REGISTERED PROFESSIONAL ENGINEER

Winnipeg
THE CITY OF WINNIPEG
WATER AND WASTE DEPARTMENT

SOUTH END WATER POLLUTION CONTROL CENTRE
SEWPCC UPGRADING/EXPANSION PROJECT
STRUCTURAL
SECONDARY CLARIFIERS 4 AND 5
ROOF PLAN – PART A

CITY DRAWING NUMBER	SHEET	REV.	SIZE
1-0102-SGAD-S017	001	01	A1

PLOT DATE: 2/25/2016
FILE NAME: 1-0102-SGAD-S017.dgn