
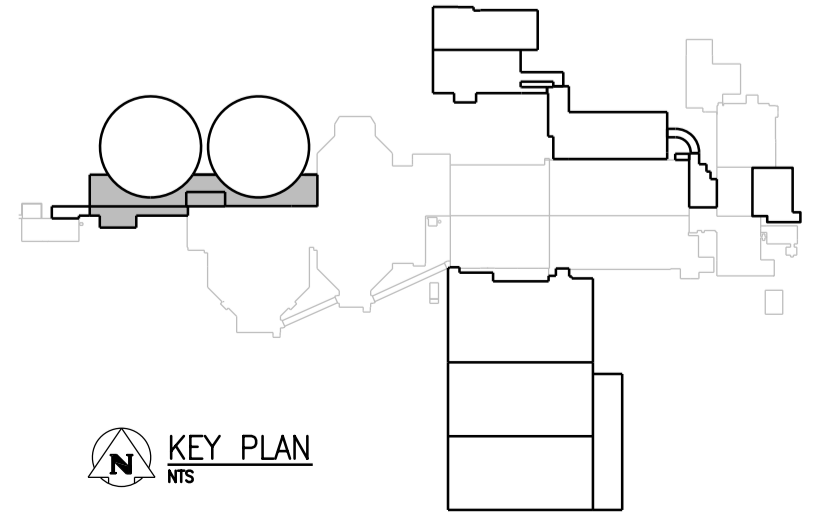


NOTES:

1. ALL THE COLUMNS ALONG THIS LINE ARE LOCATED ON TOP OF PILES. IF THE COLUMN DO NOT FALL ON TOP OF PILE. NOTIFY CONTRACT ADMINISTRATOR IMMEDIATELY FOR FURTHER ACTION BEFORE PROCEEDING, TYP FOR ALL COLUMNS.
2. FOR WEeping TILE SYSTEM RUNNING UNDERSIDE THE SLAB SEE DWG CGAD-S001.
3. DESIGN SUPERIMPOSED LL=15kPa
4. DESIGN SUPERIMPOSED LL=12kPa
5. EXTRA 15-20Mx1500 LONG @200 C TO C BOTTOM LAYER AT COL C1.
6. ONE SIDED FORMWORK WILL BE NECESSARY FOR THIS WALL.

BASEMENT PLAN - PART A

1:100

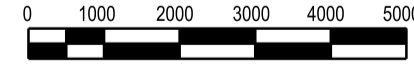

NO.	REVISIONS	DATE	DESIGN	CHECK
02	ISSUED FOR ADD. 4 - B.O. 899-2015	03/2016	G.O. J.C.	
01	ISSUED FOR ADD. 2 - B.O. 899-2015	02/2016	G.O. J.C.	
00	ISSUED FOR TENDER - B.O. 899-2015	01/2016	G.O. J.C.	

CH2MHILL		KCS GROUP	
SNC-LAVALIN			
DESIGNED BY: A. THAKKAR	CHECKED BY: E. LUI	ENGINEER'S SEAL	
DRAWN BY: G. OMORI	APPROVED BY: H.T. FREIHAMMER	March 10, 2016	
SCALE: 1:100	ISSUED FOR CONSTRUCTION	S.E. LUI Member 37203 REGISTERED PROFESSIONAL ENGINEER	
DATE: 2016/01/29	BY: T. TURZAK		
DATE: 2016/01/29	DATE: 2016/01/29		
CONSULTANT NO.: 474248			

THE CITY OF WINNIPEG
Winnipeg WATER AND WASTE DEPARTMENT

SOUTH END WATER POLLUTION CONTROL CENTRE
SEWPPC UPGRADING/EXPANSION PROJECT
STRUCTURAL
SECONDARY CLARIFIERS 4 AND 5
BASEMENT PLAN - PART A

CITY DRAWING NUMBER: 1-0102-SGAD-S004
SHEET: 001
REV: 02
SIZE: A1