


#	date	issued notes
1	2017.01.10	ISSUED FOR ADDENDUM 4
0	2016.12.08	ISSUED FOR CONSTRUCTION

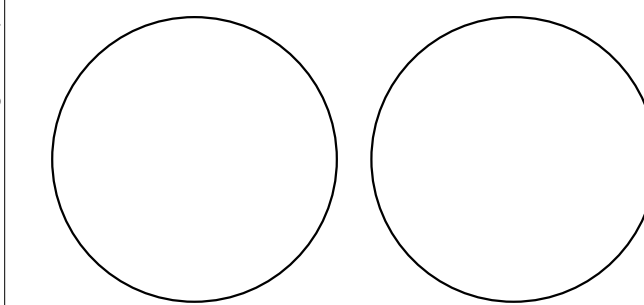

**SEVEN OAKS POOL RENOVATION & ADDITION**

444 ADSUM DRIVE  
WINNIPEG, MB  
CANADA

CITY OF WINNIPEG  
4TH FLOOR - 85 KING ST.  
WINNIPEG, MB

Sections & Details

drawn by: M.B. / AVP  
approved by: FDW

scale: 1 : 20  
date issued: 2017.01.10  
proj. #: W14432  
rev. #: 1

This drawing must not be scaled. The contractor shall verify all dimensions and other data on site prior to commencement of work. All discrepancies, errors, and omissions are to be reported to the architect. Drawings and specifications, as instruments of service, are the property of the architect, the copyright in the same being reserved to him. No reproduction may be made without the permission of the architect, and when made, must bear his name. All prints to be returned to the architect on request.

