


PLAN

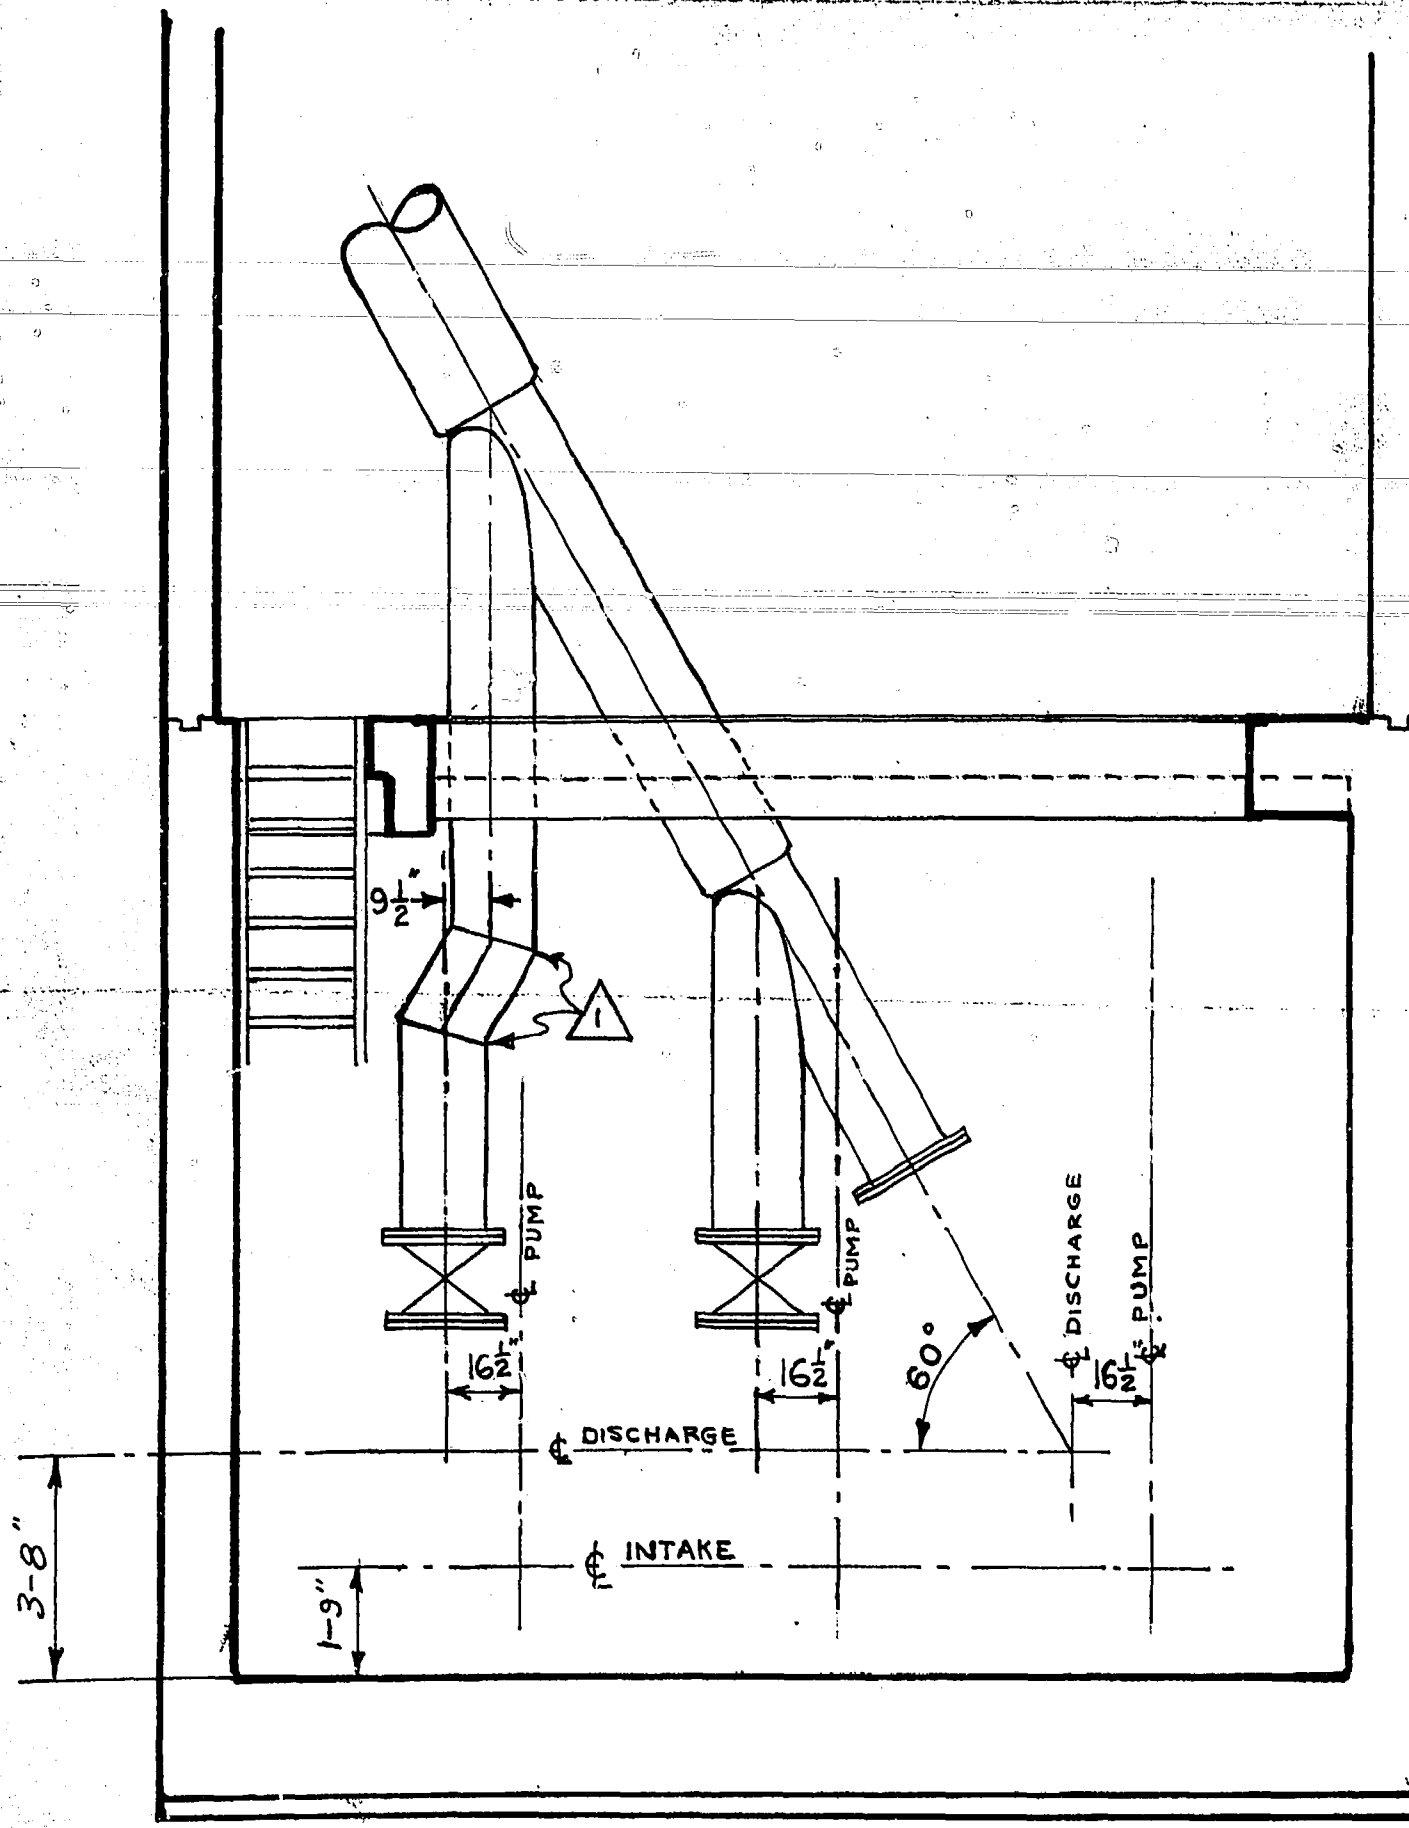

LONG. SEC. (LOOKING WEST)



▲ MITER DESIGN REVISED 14 JAN 64 HB
 THE METROPOLITAN CORPORATION OF GREATER WINNIPEG
WATERWORKS & WASTE DISPOSAL DIVISION
 SEWAGE DISPOSAL DEPT
 REVISED PIPING FOR COMMUNITY
 ROW PUMPIN STATION.
 APPROVED: *M.S. Puklin* CHIEF ENGINEER
 DESIGNED BY: *HB* CHECKED BY: *HB*
 DRAWN BY: *HB* DATE: 9 DEC 63
 1/4" SCALES " = 1'-0"
 DRAWING NO. **S-281**