




	CONCRETE SLAB SCHEDULE							
			REINFORCING BAR DETAILS					
MARK	DEPTH	TUL REINF	TLL REINF	BUL REINF	BLL REINF	ADD'L REINF	REMARKS	
SL-1	750	25M @ 225 o/c	25M @ 225 o/c	25M @ 225 o/c	25M @ 225 o/c		BASE SLAB	
SL-2	300	25M @ 200 o/c	15M @ 200 o/c	15M @ 200 o/c	15M @ 200 o/c		INTERMEDIATE SLAB	
SL-3	600	20M @ 200 o/c	15M @ 200 o/c	15M @ 200 o/c	15M @ 200 o/c		INTERMEDIATE LEVEL PUMP PIPE SLAB	
SL-4	250	15M @ 250 o/c	15M @ 400 o/c	15M @ 400 o/c	15M @ 250 o/c		MAIN LEVEL SLAB	
SL-5	250	15M @ 250 o/c	15M @ 400 o/c	15M @ 400 o/c	15M @ 250 o/c		TRUCK SLAB	
SL-6	300	15M @ 250 o/c	15M @ 400 o/c	15M @ 400 o/c	15M @ 250 o/c		ACCESS LEVEL SLAB	
SL-7	100	-	-	-	-	152 x 152 x MW 9.1/MW 9.1 REINFORCING MESH	PLAZA DECK CONCRETE TOPPING	

CONCRETE WALL SCHEDULE						
			REINFORCING BAF			
MARK	THICKNESS	HORIZONTAL	VERTICAL	ADD'L	REMARKS	
CW-1	700	25M @ 175 o/c E.F.	25M @ 150 o/c E.F.		REFER TO DWG BS-401 FOR DETAILS	
CW-2	700	25M @ 175 o/c E.F.	20M @ 175 o/c E.F.		REFER TO DWG BS-401 FOR DETAILS	
CW-3	450	15M @ 200 o/c E.F.	15M @ 200 o/c l.F. 25M @ 200 o/c O.F.	REFER TO DETAIL	REFER TO DWG BS-401 FOR DETAILS	
CW-4	450	15M @ 200 o/c E.F.	15M @ 200 o/c l.F. 20M @ 200 o/c O.F.	REFER TO DETAIL	REFER TO DWG BS-401 FOR DETAILS	
CW-5	300			REFER TO DETAIL	REFER TO DWG BS-401 FOR DETAILS	
CW-6	450	15M @ 175 o/c E.F.	15M @ 175 o/c E.F.	REFER TO DETAIL	REFER TO DWG BS-401 FOR DETAILS	
CW-7	200	15M @ 200 o/c	15M @ 200 o/c		REFER TO DWG BS-402 FOR DETAILS	

	CONCRETE CURB SCHEDULE					
			REINFORCING BAR DETAILS			
MARK	WIDTH	DEPTH	HORIZONTAL	STIRRUPS	REMARKS	
CURB-1	190	200	2-10M	10M @ 200 o/c		
CURB-2	450	400	3-15M, 1-15M E.F. MID	10M @ 175 o/c		
CURB-3	200	200, MIN.	2-10M	10M @ 200 o/c		
CURB-4	190	100	2-10M	10M @ 200 o/c		
CURB-5	300	200	2-10M	10M @ 200 o/c		
CURB-6	450	200	2-15M	10M @ 200 o/c		

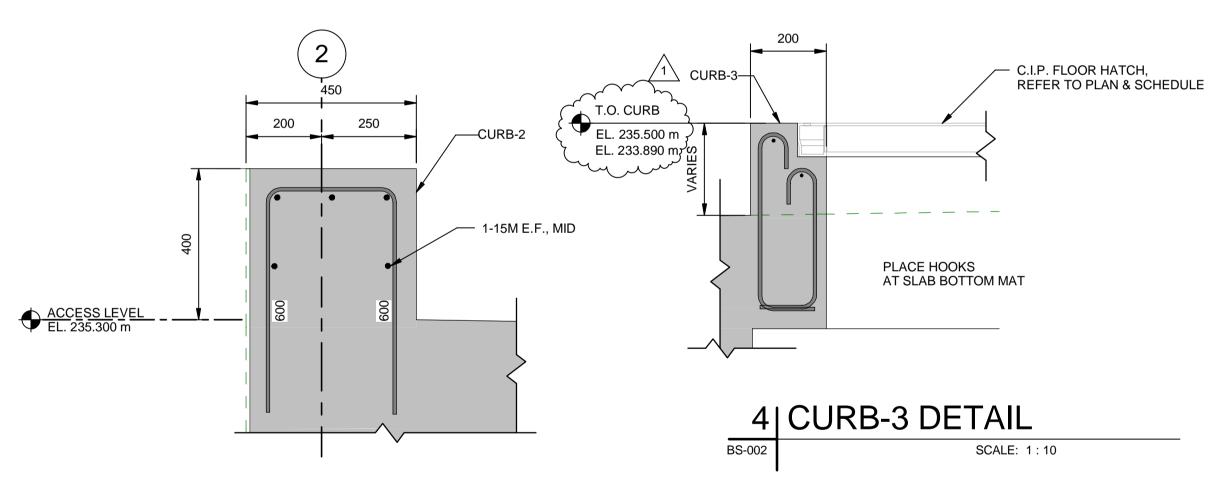

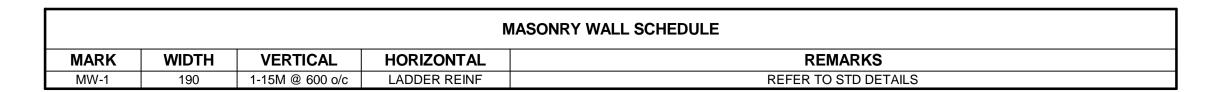

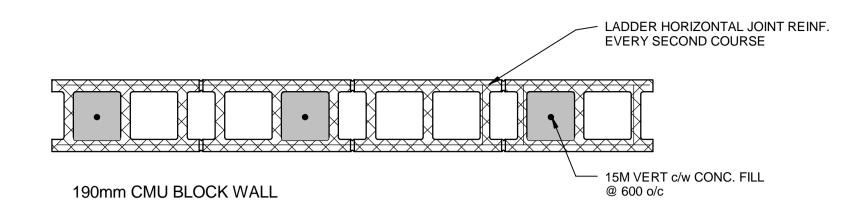


1|STD CMU WALLS DETAIL BS-002 SCALE: 1:10

MASONRY LINTEL SCHEDULE

10M @ 400 o/c

REMARKS


DEPTH TOP REINF BOTTOM REINF STIRRUPS

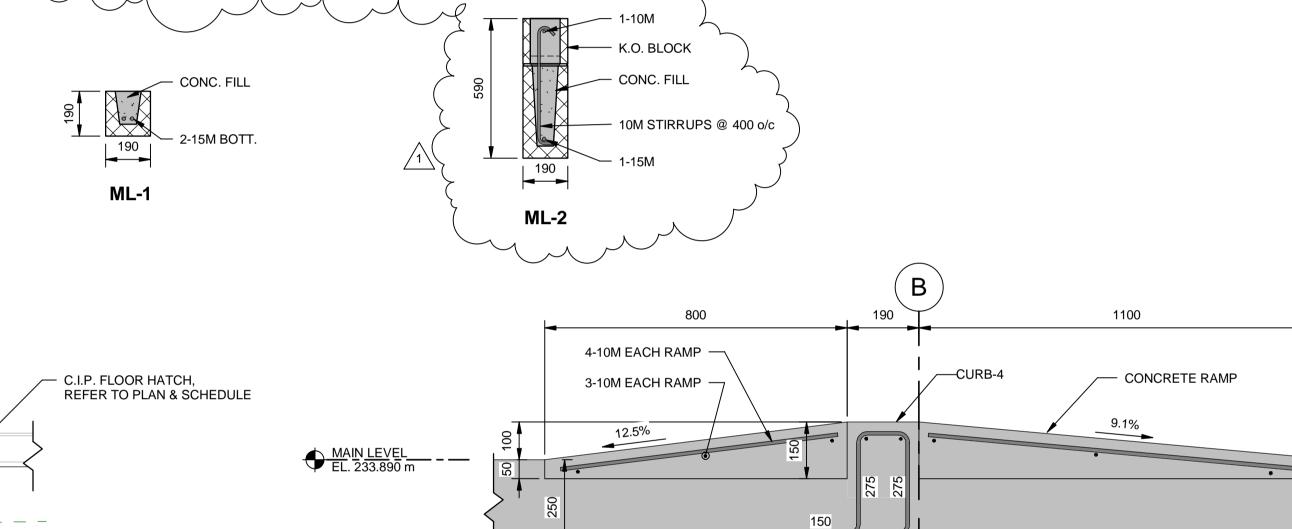


CW-3-----

5 | CURB-4 DETAIL

SCALE: 1:10

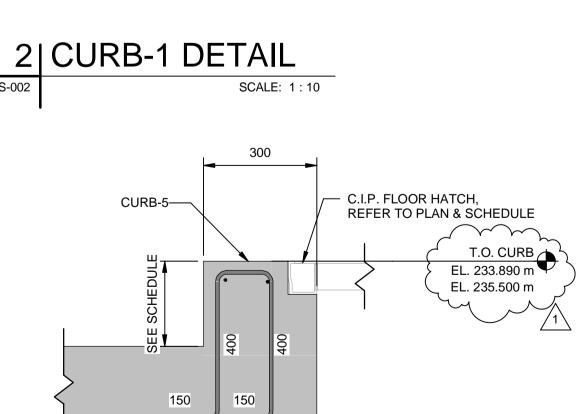


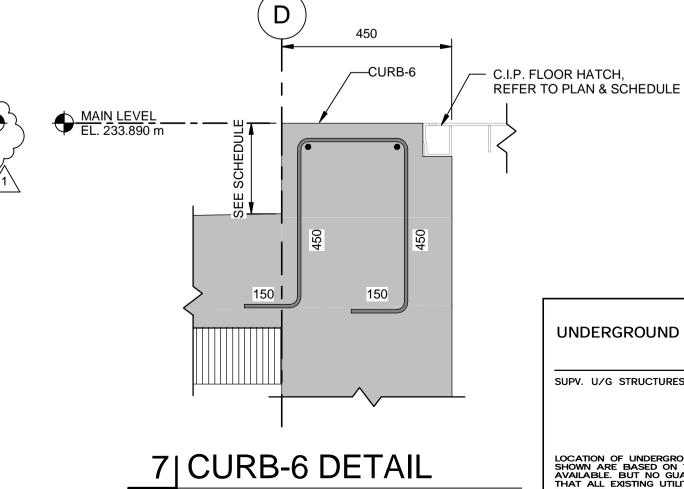

3 | CURB-2 DETAIL

SCALE: 1:10

BS-002

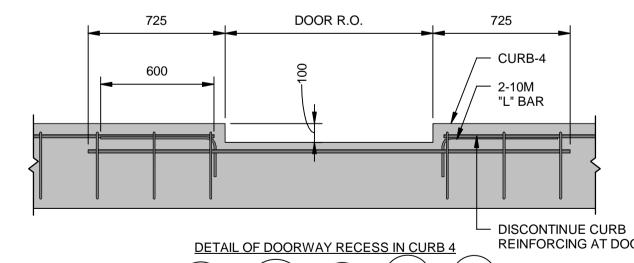

MARK

REINFORCING AT DOORWAY RECESS DETAIL - DOORWAY RECESS 9| IN INTERIOR WALL

06/01/2016

DATE

APEGN Certificate of Authorization AECOM Canada Ltd. No. 4671 Date:_

CONSULTANT PROJECT NUMBER

60321148

09/06/2016

METRIC WHOLE NUMBERS INDICATE MILLIMETRES DECIMALIZED NUMBERS INDICATE METRES

- 150 VOID

__SL-4

6	CURB-5 DETAIL
BS 002	SCALE: 1:10

SCALE: 1:10

DATE SUPV. U/G STRUCTURES

NO. REVISIONS

B.M. ELEV. **AECOM** UNDERGROUND STRUCTURES DESIGNED KK/JT APPROVED DRAWN RELEASED FOR CONSTRUCTION ISSUED FOR ADDENDUM 2 17/02/03 KK AS SHOWN VERTICAL ISSUED FOR TENDER 17/01/09 KK

DATE BY

ENGINEER'S SEAL Winnipeg J.A. THOMPSON Member 30632 PROFESSIONAL

THE CITY OF WINNIPEG PUBLIC WORKS DEPARTMENT

WAVERLEY STREET UNDERPASS AT CN MILE 3.89 RIVERS SUB CITY DRAWING NUMBER CONTRACT 2: UNDERPASS STRUCTURE, RAILWORKS, ROADWORKS, LAND DRAINAGE SEWER, PUMPING STATION

U-239-2016-C2-BS-002 AND LANDSCAPING WORKS CONSULTANT DRAWING NUMBER PUMPING STATION

C2-BS-002 SCHEDULES