


A
39 39
TRAFFIC BARRIER ELEVATION
1:50

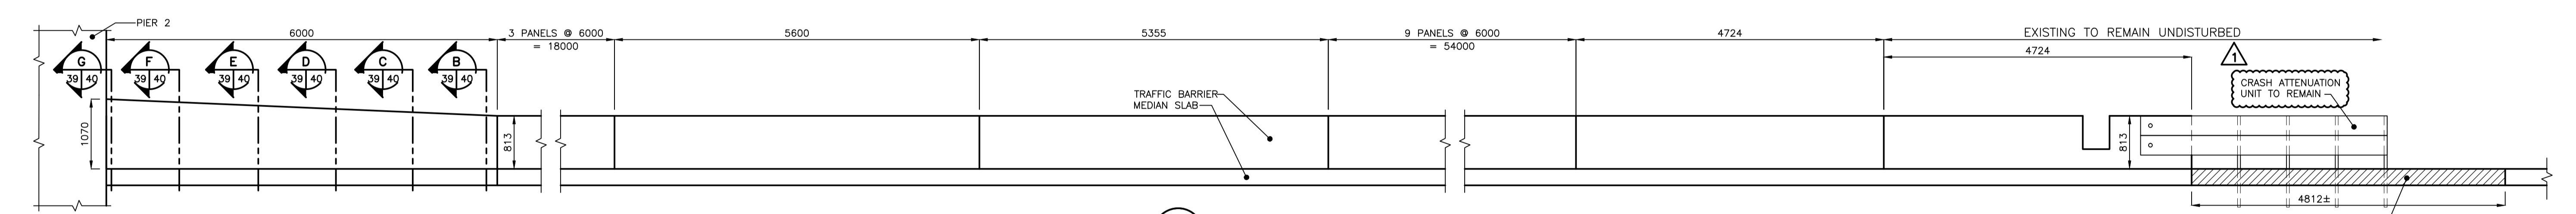

B
39 39
TRAFFIC BARRIER ELEVATION
1:50

LOCATION APPROVED UNDERGROUND STRUCTURES

SUPV. U/G STRUCTURES COMMITTEE DATE

NOTE:
LOCATION OF UNDERGROUND STRUCTURES AS SHOWN ARE BASED ON THE BEST INFORMATION AVAILABLE BUT NO GUARANTEE IS GIVEN THAT ALL EXISTING UTILITIES ARE SHOWN OR THAT THE GIVEN LOCATIONS ARE EXACT. CONFIRMATION OF EXISTENCE AND EXACT LOCATION OF ALL SERVICES MUST BE OBTAINED FROM THE INDIVIDUAL UTILITIES BEFORE PROCEEDING WITH CONSTRUCTION.

NO.	REVISIONS	DATE	BY
1	ISSUED FOR ADDENDUM No. 1	16.07.14	D.J.M.
0	ISSUED FOR TENDER	16.07.04	K.S.A.

B.M. ELEV.

DESIGNED BY: S.Y. CHECKED BY: K.S.A.

DRAWN BY: V.F. APPROVED BY: B.J.W.

HOR. SCALE: AS NOTED VERTICAL: RELEASED FOR CONSTRUCTION: DATE

DATE: 2016.02.19

ENGINEER'S SEAL

CONSULTANT DRAWING NO. S-123

THE CITY OF WINNIPEG
PUBLIC WORKS DEPARTMENT
ENGINEERING DIVISION

2016 REGIONAL STREET PROGRAM
ARCHIBALD STREET
UNDERPASS REHABILITATION
MEDIAN SLAB AND TRAFFIC BARRIER PLAN

SHEET 39 OF 62
CAD FILE DRAWING NUMBER 06880s-119-884.dwg
CITY DRAWING NUMBER U205-16-39

I:\117\11706880\0300_drawing\0302_sched_files\03_structural\06880s-119-884.dwg
 Date: 2016 Jul 14 10:42pm User: P. Prasad, G. G.