

#	date	issued notes
1	2016.08.16	ISSUED FOR ADDENDUM #1
0	2016.07.15	ISSUED FOR CONSTRUCTION

professional seals

project information

SEVEN OAKS POOL RENOVATION & ADDITION
444 ADSUM DRIVE
WINNIPEG, MB
CANADA

client

CITY OF WINNIPEG
4TH FLOOR - 85 KING ST.
WINNIPEG, MB


drawing information

Main Floor Framing Plan

drawn by: M.B. / AVP
approved by: FDW


scale: As indicated
date issued: 2016.07.12
proj. #: W14432
rev. #: 1

SEVEN OAKS POOL RENOVATION & ADDITION
BID OPPORTUNITY NO. 645-2016

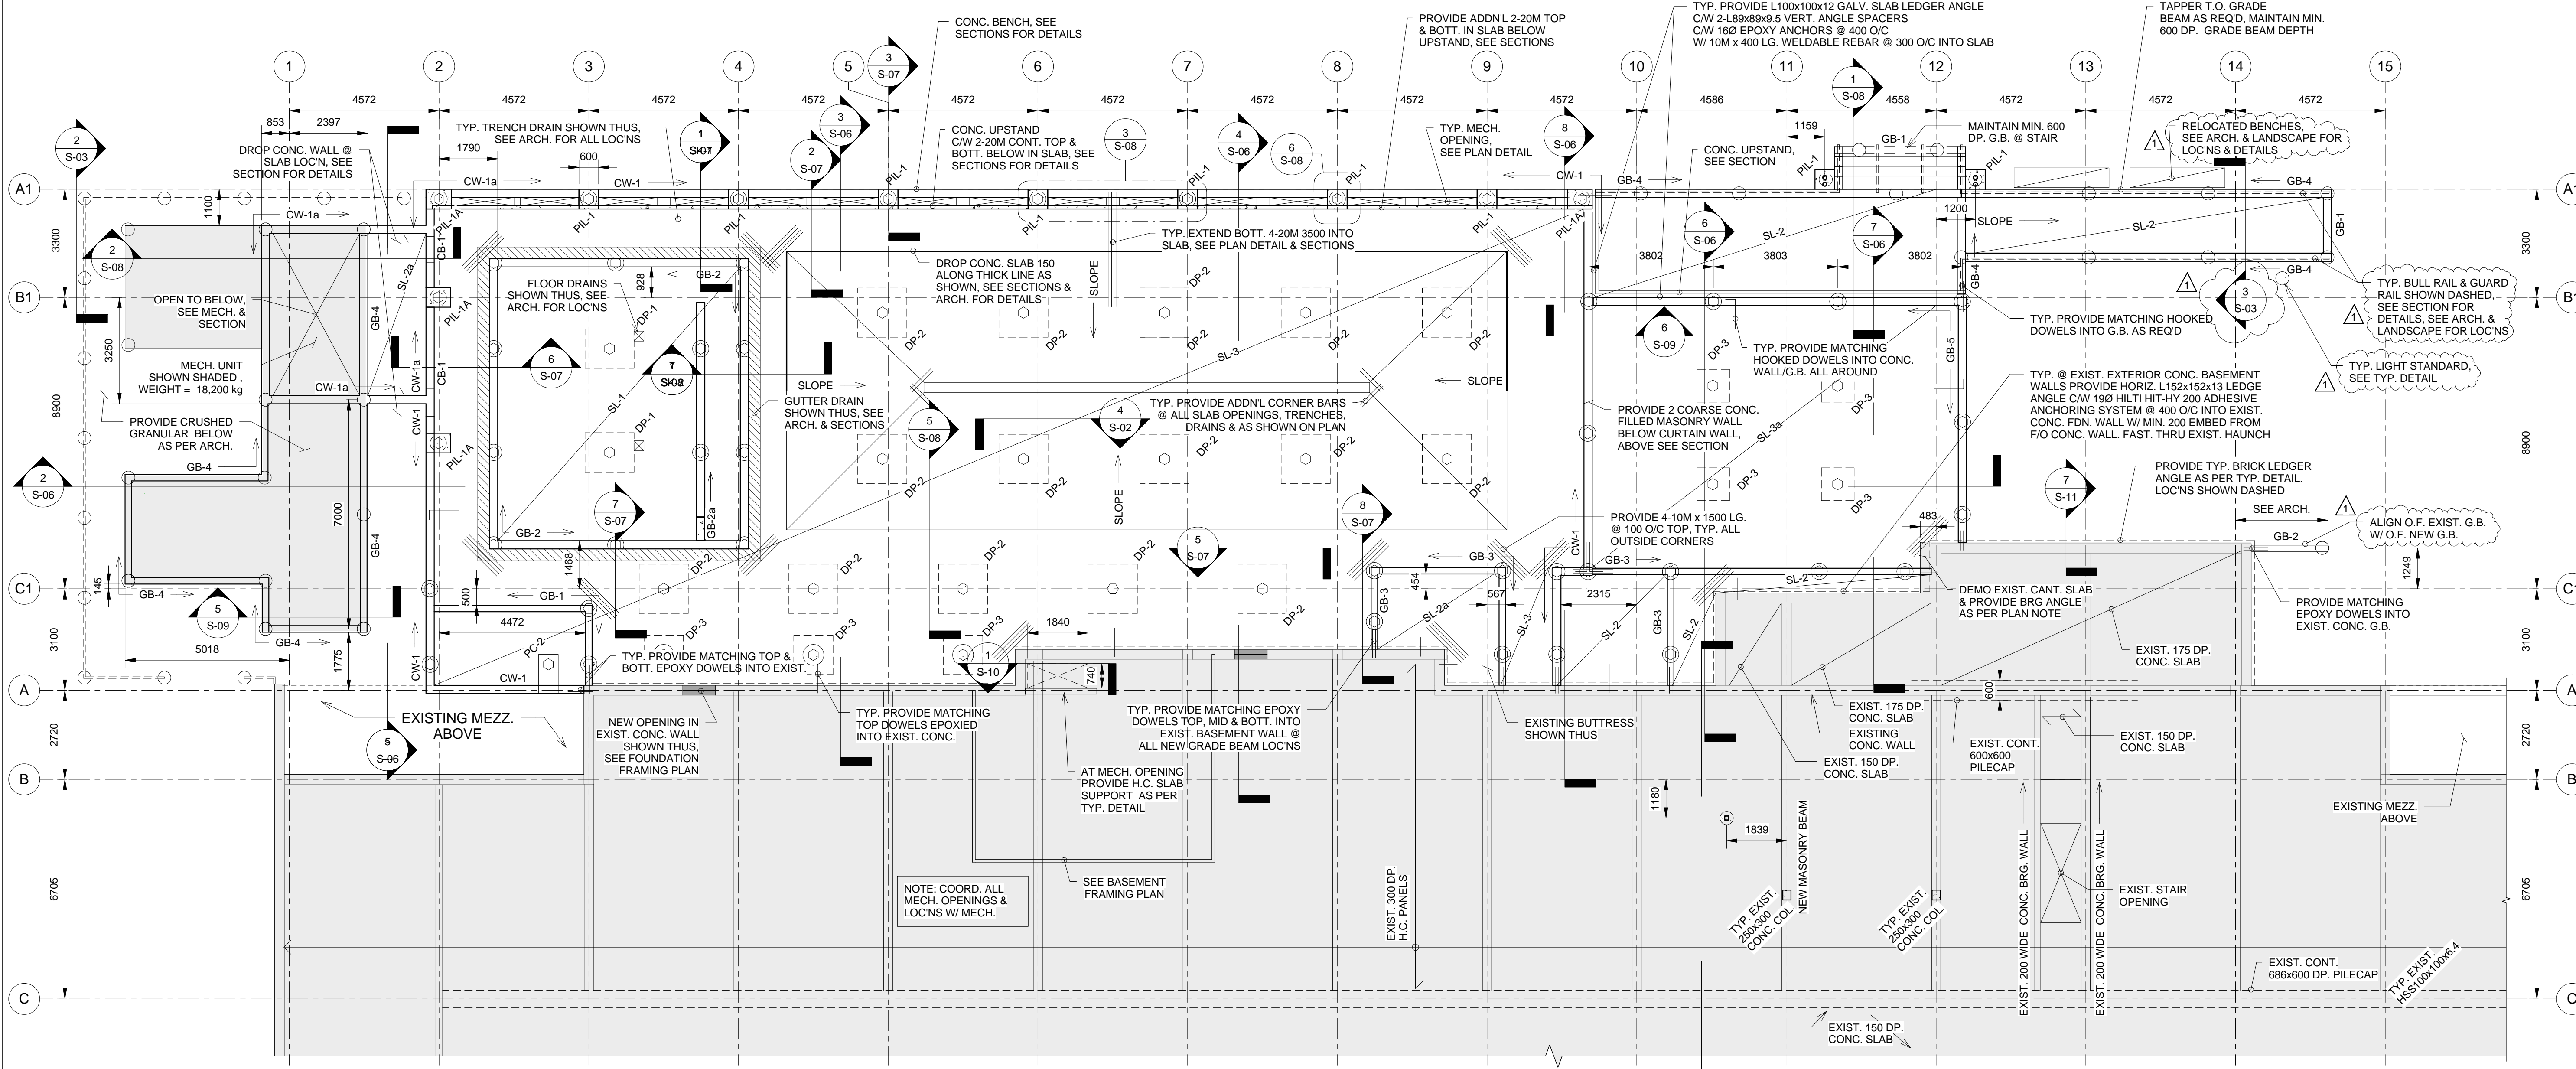


1 Main Floor Framing Plan
S-03
1 : 100

DESIGN LOADS:
DEAD LOAD: 4.2 kPa
LIVE LOAD: 4.8 kPa

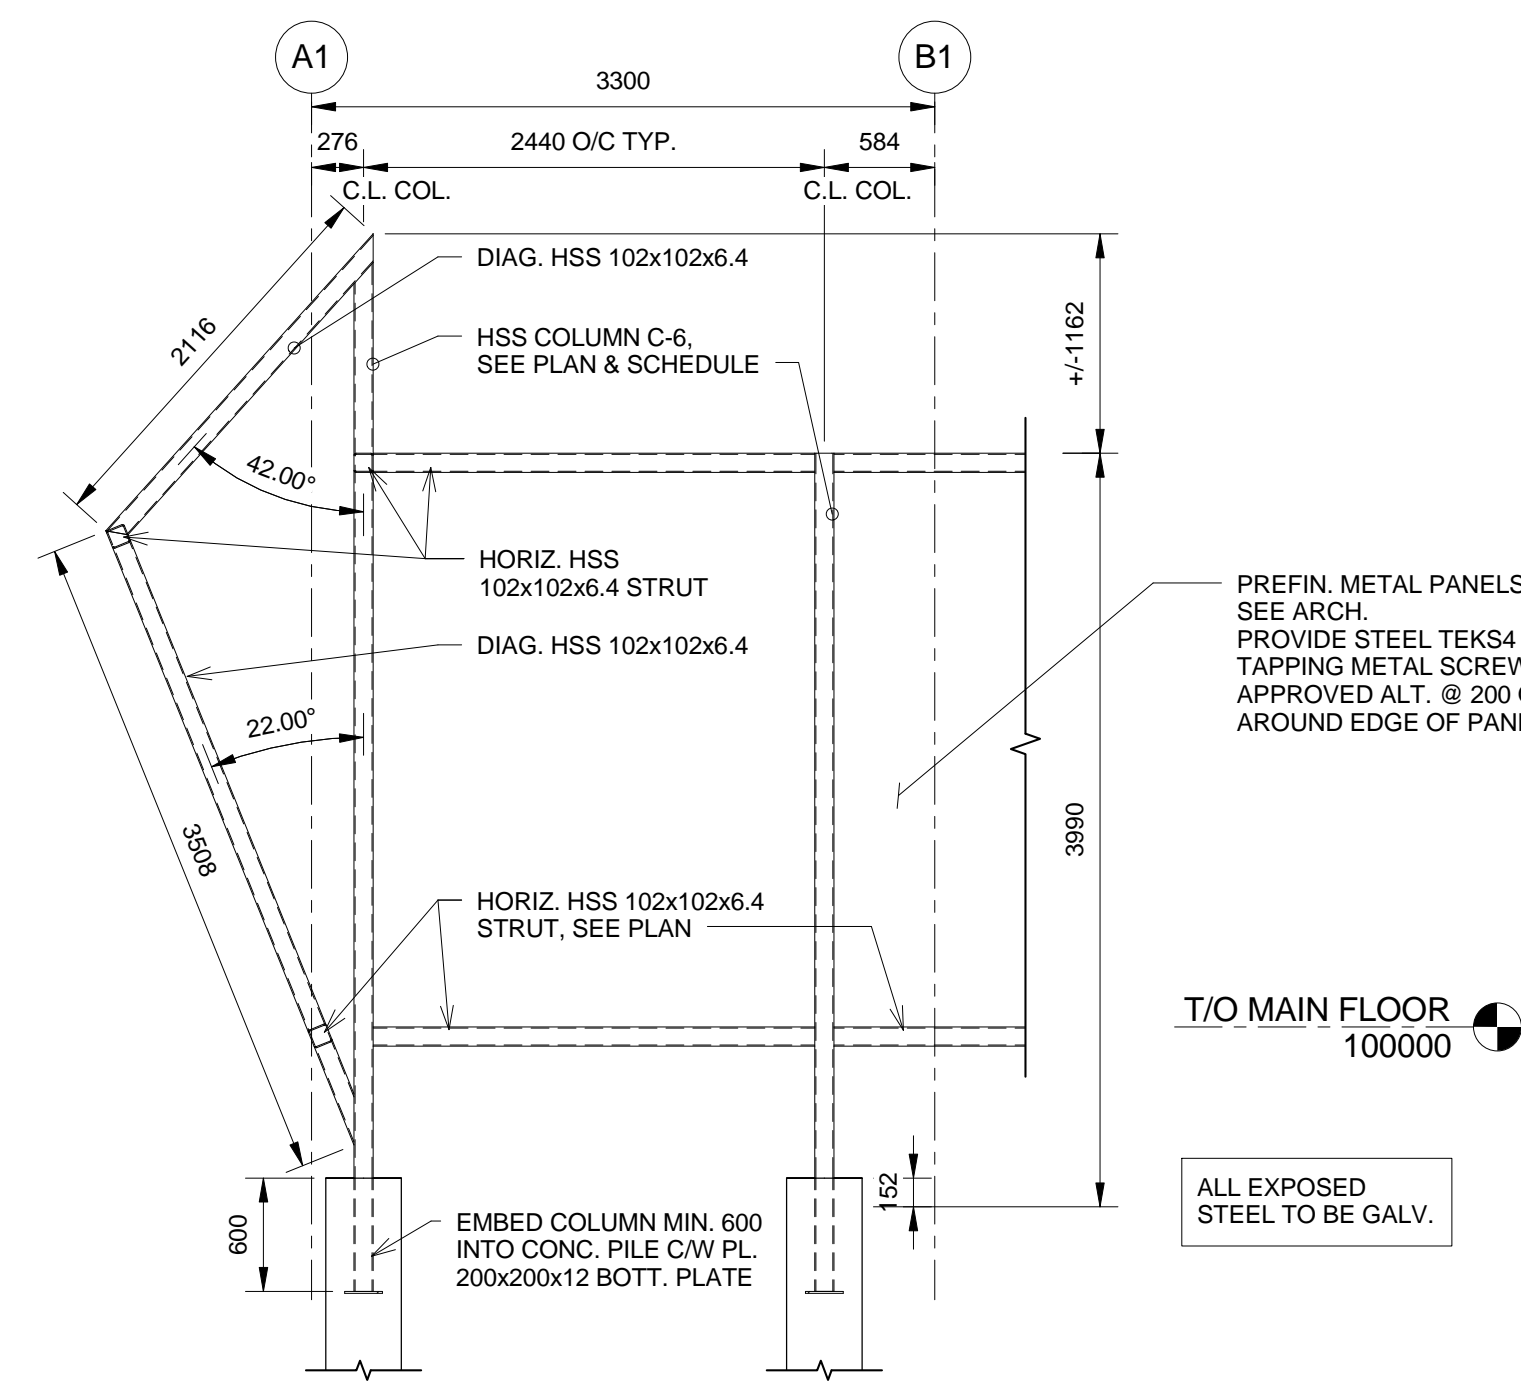

2 Section
S-03
1 : 40

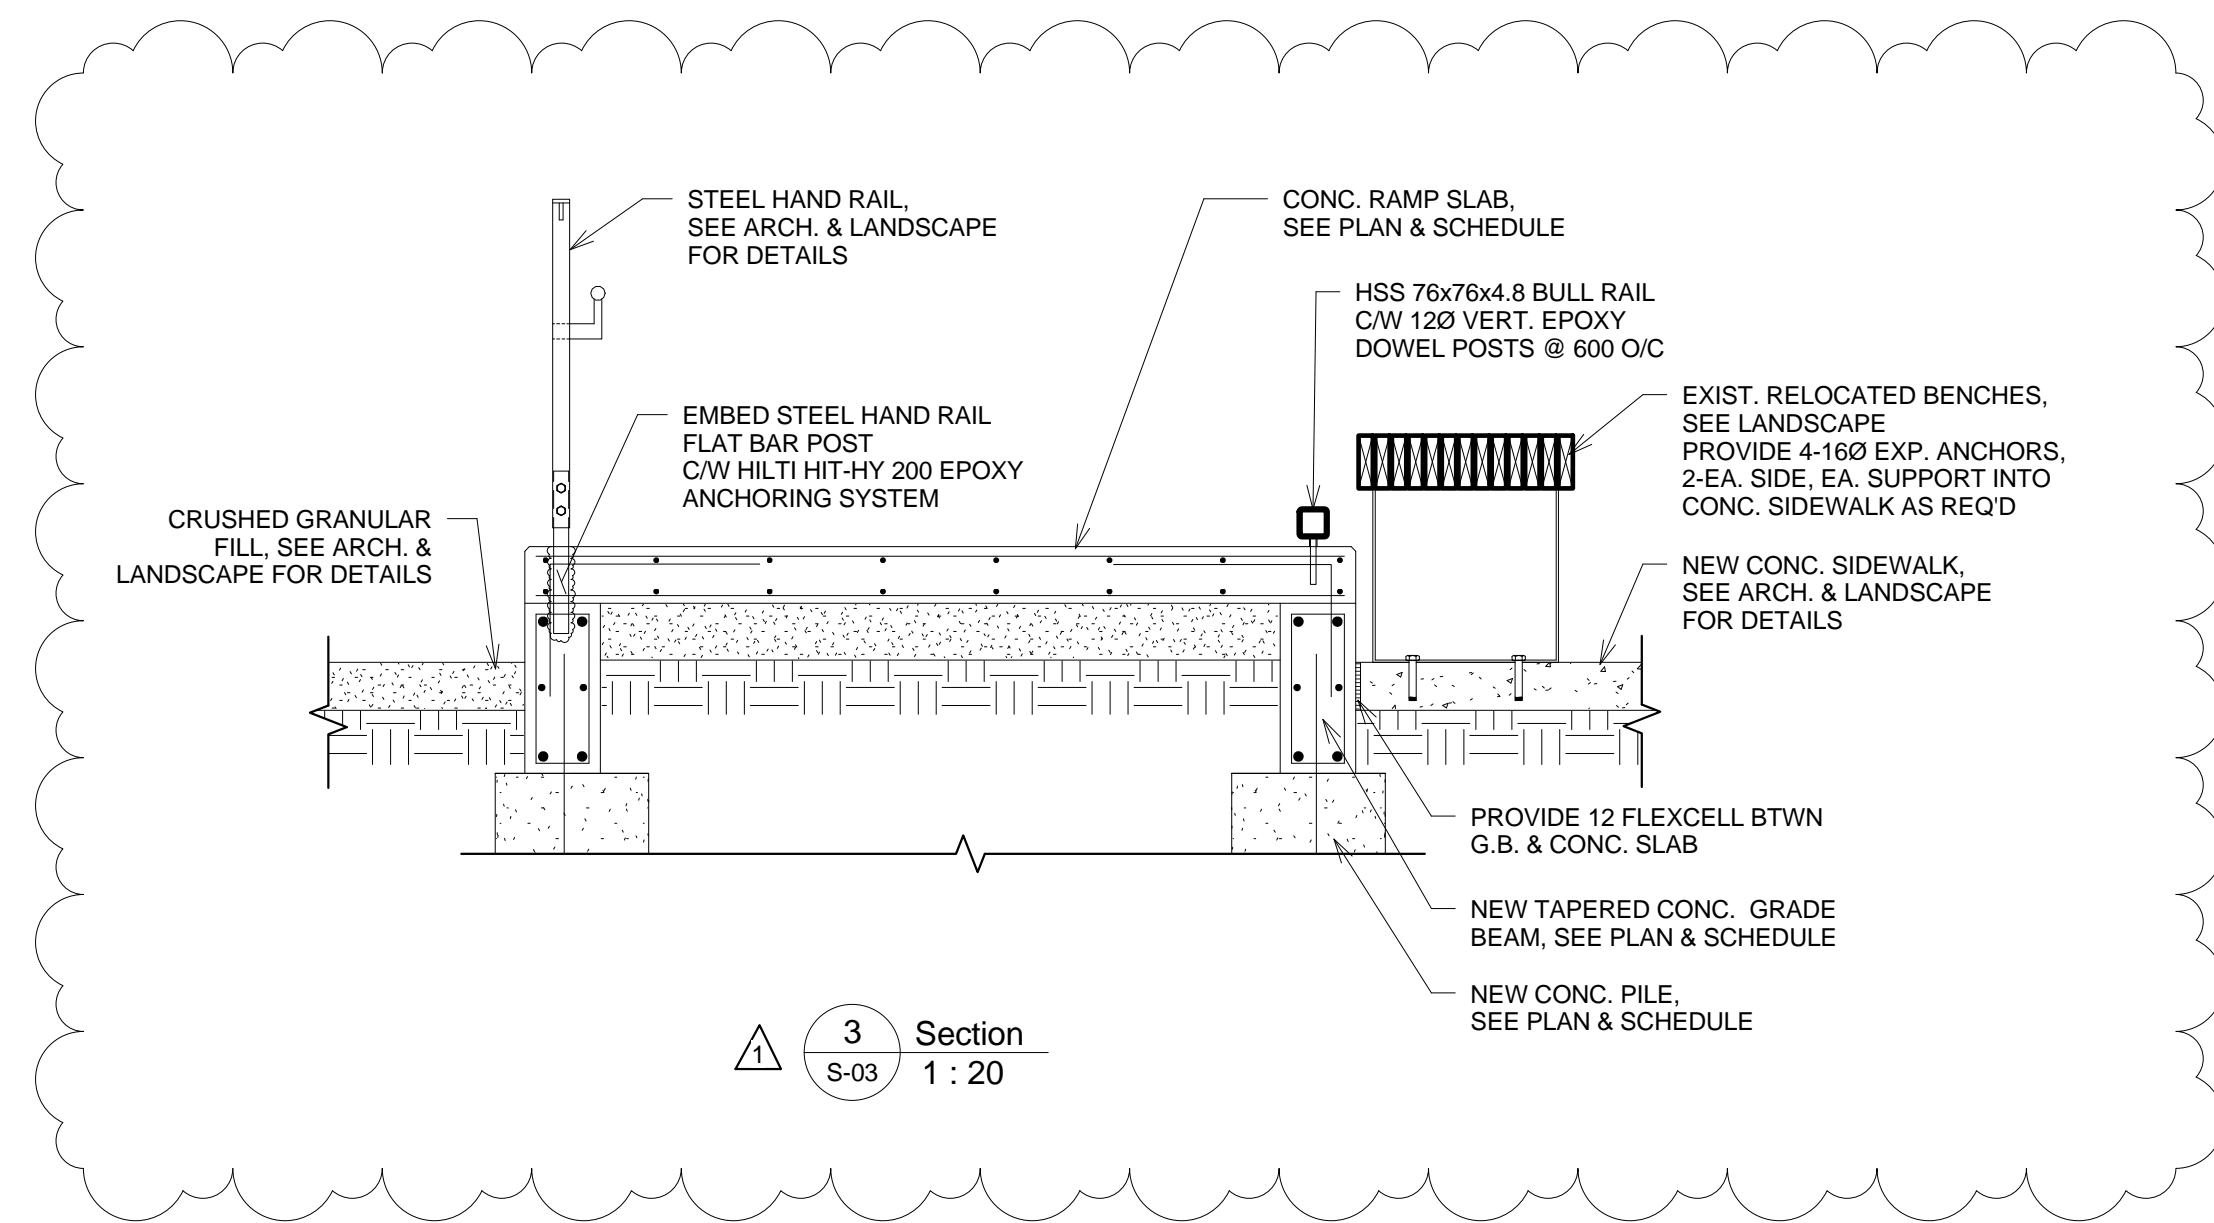

3 Section
S-03
1 : 20

This drawing must not be scaled. The contractor shall verify all dimensions and other data on site prior to commencement of work. All discrepancies, errors, and omissions are to be reported to the architect. Drawings and specifications, as instruments of service, are the property of the architect. No reproduction may be made without the permission of the architect, and when made, must bear his name. All rights to be returned to the architect on request.