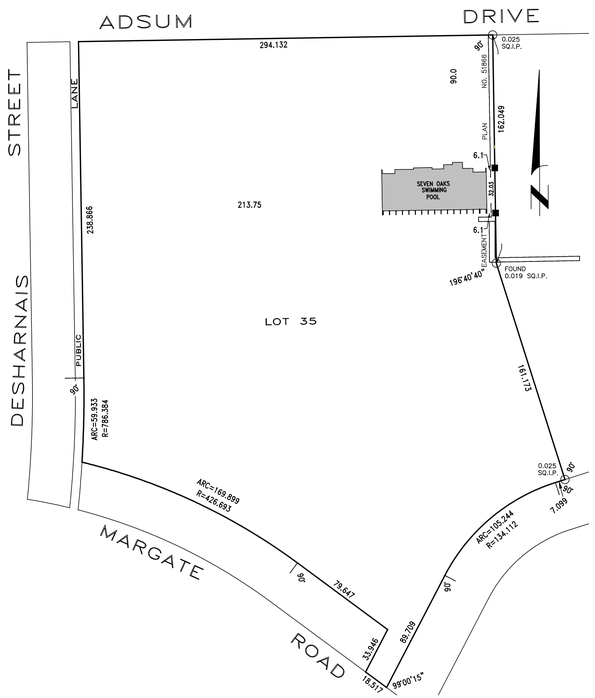

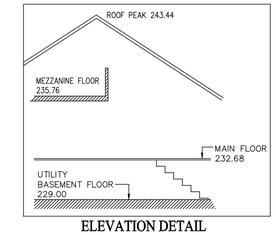

ELEVATION DETAIL

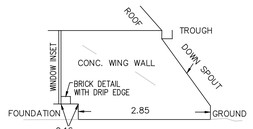

WING WALL DETAIL
N.T.S.

PLAN OF TOPOGRAPHIC SURVEY

ISSUED BY

LANKHOUT
LAND SURVEYING AND GEOMATICS

581 Main Street
OAKBANK, MANITOBA
ROE 1JO

PHONE: (204) 444-5870
FAX: (204) 444-5871
ron.lankhout@mts.net

OUR FILE NO. 16-04-1406
FIELD BOOK: 52/52

DATED MAY 5, 2016
REV.1 MAY 11, 2016 (SERVICES)
REV.2 JULY 18, 2016 (CB INFO)

CITY OF WINNIPEG

RE: SEVEN OAKS SWIMMING POOL - 444 ADSUM DRIVE, WINNIPEG, MANITOBA

CERTIFICATE OF TITLE: 2033955 (SEARCHED APRIL 29, 2016)

REGISTERED OWNER: THE CITY OF WINNIPEG

LEGAL DESCRIPTION: FIRSTLY: LOT 81, BLOCK 1, PLAN 12296 W.L.T.O. IN LOTS 6 TO 11 O.T.M. PARISH OF KILDONAN
SECONDLY: LOT 35, BLOCK 3, PLAN 12296 W.L.T.O. IN LOTS 6 TO 11 O.T.M. PARISH OF KILDONAN

ENCUMBRANCES: INSTRUMENT NUMBER 236127, 238222, 1363260, 1761947, 3015493 AND 3035254 ARE REGISTERED AGAINST AGAINST THE ABOVE CERTIFICATE OF TITLE. ENCUMBRANCES NOTED HEREIN ARE FOR INFORMATION PURPOSES ONLY AND HAVE NOT BEEN INVESTIGATED AS TO ITS INTENT OR EXTENT.

NOTE: STAKED ONLY A PORTION OF SAID LOT 35

PRODUCED FOR (CLIENT): CITY OF WINNIPEG; (ARCHITECT: PRAIRIE ARCHITECTS INC.)

GENERAL NOTES:

1.) ALL PLANS REFERRED TO ARE ON RECORD IN THE WINNIPEG LAND TITLES OFFICE.
2.) IRON POSTS FOUND ON THE GROUND ARE DESCRIBED AND SHOWN THUS ○
3.) ALL UNDERGROUND STRUCTURES HAVE NOT BEEN INVESTIGATED, LANKHOUT LAND SURVEYING AND GEOMATICS ASSUMES NO LIABILITY IN THEIR INTENT OR EXTENT.
4.) THIS SURVEY WAS MADE ON THE 20TH AND 21ST DAYS OF APRIL, 2016
5.) LOCATIONS OF UNDERGROUND STRUCTURES SHOWN ARE BASED ON INFORMATION AVAILABLE AS PROVIDED BY THE CITY OF WINNIPEG'S UNDERGROUND STRUCTURES DEPARTMENT. NO GUARANTEE IS GIVEN THAT ALL EXISTING UTILITIES ARE SHOWN OR THAT GIVEN INDICATIONS ARE EXACT.
CONFIRMATIONS OF STRUCTURES AND EXACT LOCATION OF ALL SERVICES MUST BE OBTAINED BEFORE CONSTRUCTION OR DEVELOPMENT

EXISTING ELEVATIONS ARE REFERRED TO GEODETIC DATUM AND INDICATED THUS 232.46
ELEVATIONS ARE REFERRED TO CITY OF WINNIPEG BENCHMARK – ZONE 15 – No.53 ELEV.=231.409
DISTANCES AND GEODETIC ELEVATIONS ARE IN METRES.

LEGEND

WOOD GUARD POSTS (BOLLARDS) SHOWN THUS ■
MANHOLES SHOWN THUS Ⓜ
LAMP STANDARD SHOWN THUS
LIGHT ON BUILDING/STRUCTURES SHOWN THUS
FIRE HYDRANT SHOWN THUS
WATER VALVE SHOWN THUS
CATCH BASIN SHOWN THUS

CONIFEROUS TREE SHOWN THUS
DECIDUOUS TREE SHOWN THUS
FENCES SHOWN THUS
UNDERGROUND HYDRO LOCATE LINES SHOWN THUS — HYD/UG —
UNDERGROUND TELEPHONE (MTS) LOCATE LINES SHOWN THUS — TEL/UG —
LAND DRAINAGE SYSTEM LINES SHOWN THUS — LDS —
WATER SERVICE LINES SHOWN THUS — WM —
SIGN SHOWN THUS —
UNDERGROUND SHAW LINES SHOWN THUS FROM PLAN — TV —
SHAW DIV DARK FIBRE SHOWN THUS FROM PLAN — FOC —

COPY

Ron Lankhout

Ron Lankhout, Manitoba Land Surveyor

© LANKHOUT LAND SURVEYING & GEOMATICS 2016
All rights reserved. No person may copy, reproduce, store, transmit, distribute or alter this document in whole or in part.

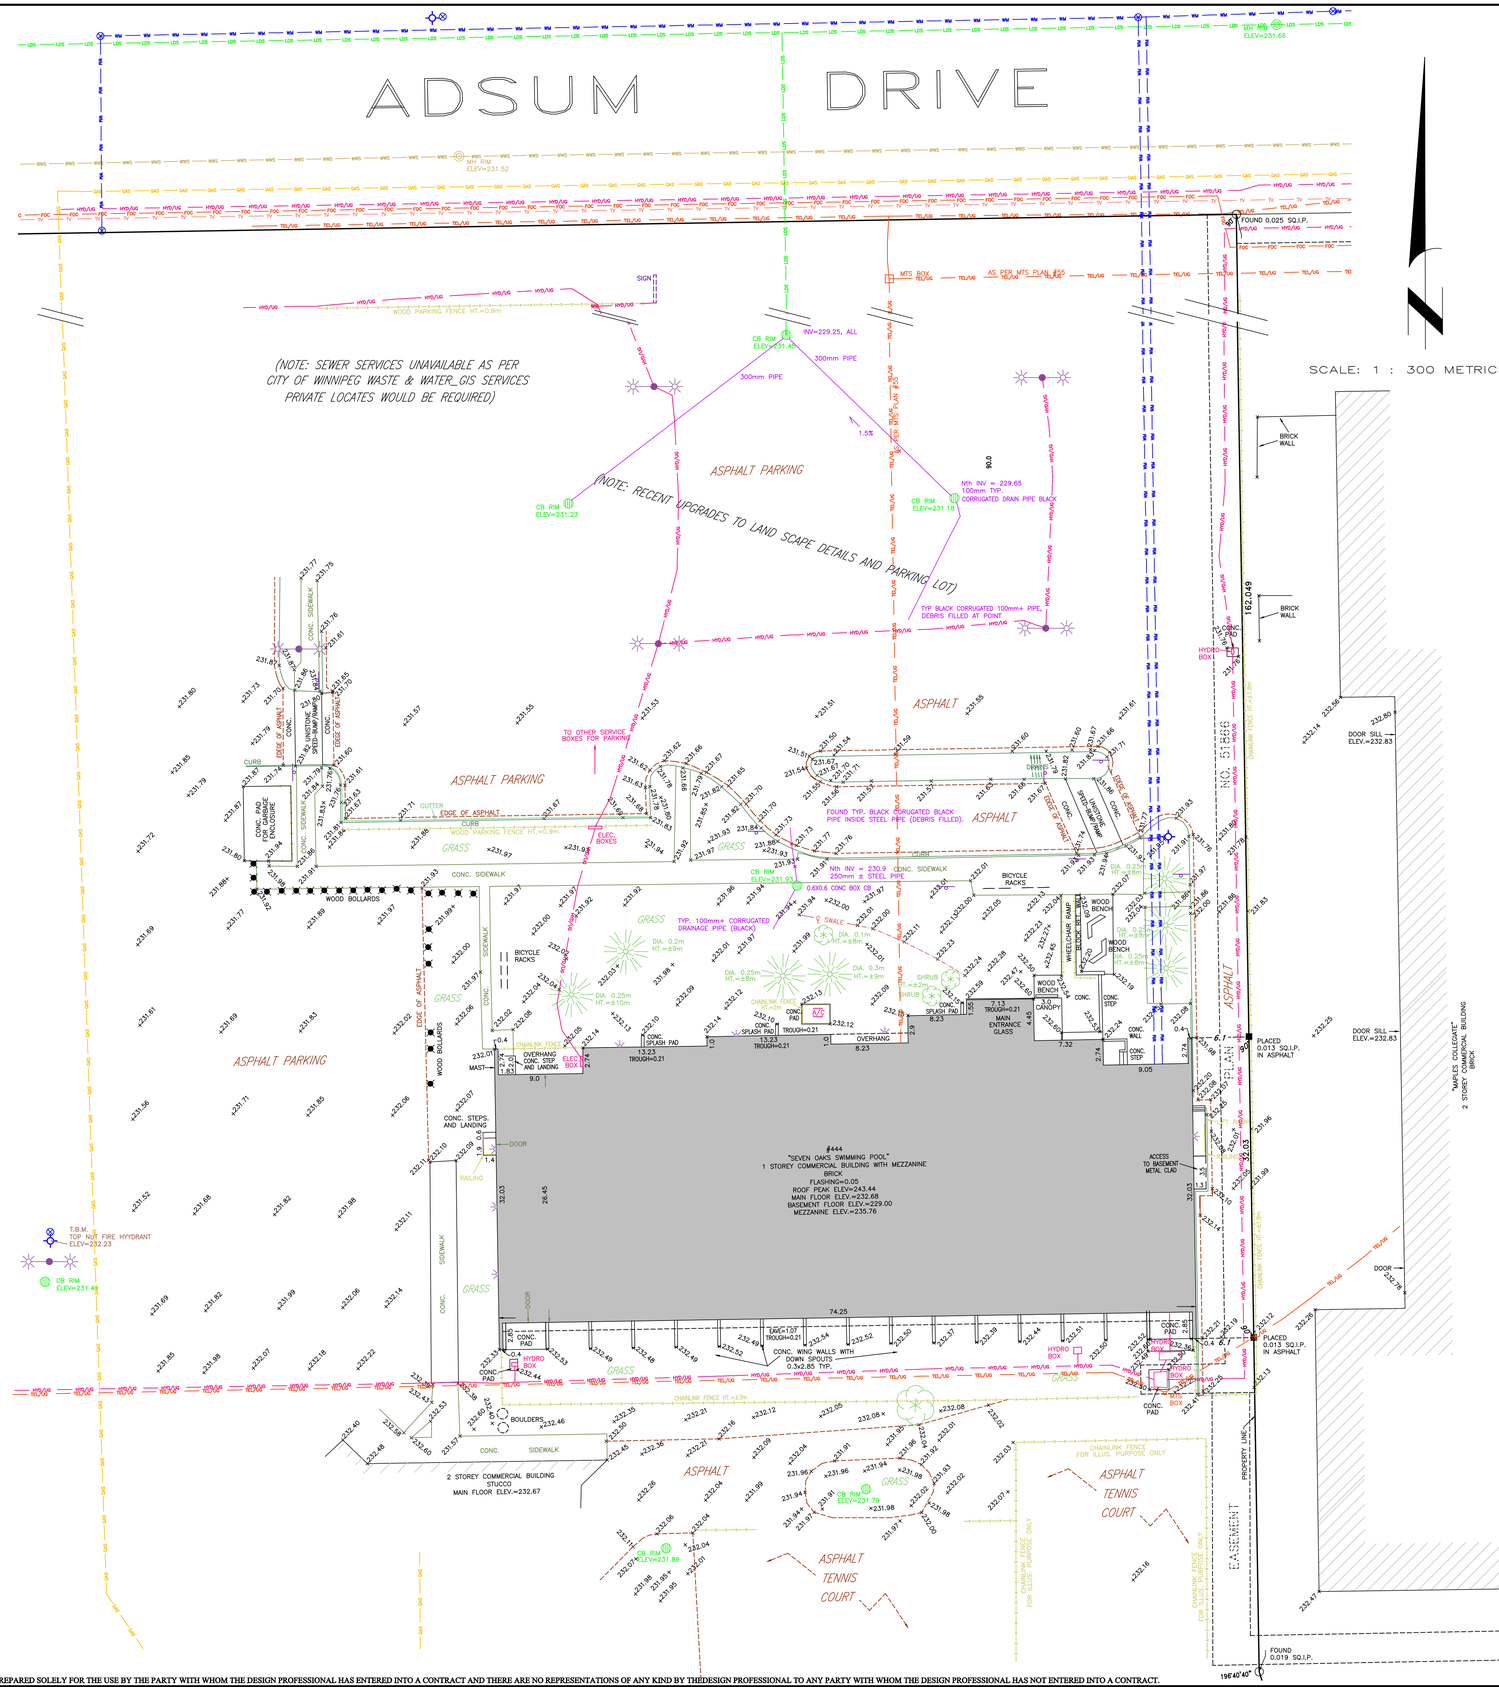
ADSUM
DRIVE
SCALE: 1 : 300 METRIC
(NOTE: SEWER SERVICES UNAVAILABLE AS PER CITY OF WINNIPEG WASTE & WATER_GIS SERVICES PRIVATE LOCATES WOULD BE REQUIRED)
(NOTE: RECENT UPGRADES TO LAND SCAPE DETAILS AND PARKING LOT)
ASPHALT PARKING
ASPHALT
GRASS
CONC. SIDEWALK
WOOD BOLLARDS
WOOD PARKING FENCE HT.=0.9m
CHAINLINK FENCE HT.=±3m
TYP. 100mm+ CORRUGATED DRAINAGE PIPE (BLACK)
TYP. BLACK CORRUGATED 100mm+ PIPE, DEBRIS FILLED AT POINT
FOUND TYP. BLACK CORRUGATED PIPE INSIDE STEEL PIPE (DEBRIS FILLED).
CB RIM ELEV=231.45
INV=229.25, ALL 300mm PIPE
CB RIM ELEV=231.23
CB RIM ELEV=231.18
Nth INV = 229.65 100mm TYP. CORRUGATED DRAIN PIPE BLACK
CB RIM ELEV=231.93
Nth INV = 230.9 250mm ± STEEL PIPE
0.6X0.6 CONC BOX CB
CB RIM ELEV=231.79
CB RIM ELEV=231.89
T.B.M. TOP NUT FIRE HYDRANT ELEV=232.23
CB RIM ELEV=231.43
"SEVEN OAKS SWIMMING POOL" 1 STOREY COMMERCIAL BUILDING WITH MEZZANINE BRICK
FLASHING=0.05
ROOF PEAK ELEV=243.44
MAIN FLOOR ELEV.=232.68
BASEMENT FLOOR ELEV.=229.00
MEZZANINE ELEV.=235.76
444
2 STOREY COMMERCIAL BUILDING STUCCO
MAIN FLOOR ELEV.=232.67
"MAPLES COLLEGIATE" 2 STOREY COMMERCIAL BUILDING BRICK
BRICK WALL
DOOR SILL ELEV.=232.83
PLACED 0.013 SQ.I.P. IN ASPHALT
FOUND 0.025 SQ.I.P.
FOUND 0.019 SQ.I.P.
196°40'40"
PROPERTY LINE
EASEMENT
ASPHALT TENNIS COURT
CHAINLINK FENCE FOR ILLUS. PURPOSE ONLY
BICYCLE RACKS
WHEELCHAIR RAMP
MAIN ENTRANCE GLASS
ACCESS TO BASEMENT - METAL CLAD
HYDRO BOX
SIGN
MTS BOX
AS PER MTS PLAN
162.049
90.0
74.25
26.45
32.03
9.05
8.23
7.32
13.23 TROUGH=0.21
7.13 TROUGH=0.21
OVERHANG 8.23
CANOPY 3.0
CONC. STEPS AND LANDING
CONC. SPLASH PAD
CONC. PAD
CONC. STEP
CONC. WALL
RAILING
DOOR
CONC. WING WALLS WITH DOWN SPOUTS 0.3x2.85 TYP.
ERIE=1.07 TROUGH=0.21
TO OTHER SERVICE BOXES FOR PARKING
EDGE OF ASPHALT
CURB
GUTTER
CONC. PAD FOR GARBAGE ENCLOSURE
ELEC. BOXES
DRIVE
BOULDERS
SHRUB
DIA. 0.2m HT.=±9m
DIA. 0.1m HT.=±8m
DIA. 0.25m HT.=±8m
DIA. 0.3m HT.=±9m
DIA. 0.25m HT.=±10m
DIA. 0.25m HT.=±8m
WOOD BENCH
CONC. SPLASH PAD
CONC. PAD
CONC. STEP
CONC. WALL
CONC. CURB
CONC. SIDEWALK
CONC. STEPS AND LANDING
CONC. PAD
CONC. SPLASH PAD
TROUGH=0.21
OVERHANG
CONC. STEP AND LANDING
ELEC. BOX
MAST
SWALE
CONC. PAD
HYDRO BOX
CONC. PAD
CONC. PAD
CONC. PAD