


NOTE  
 1. FIELD RUN AND RECONNECT EXISTING 150-FSW FROM 250-FSW NEAR GRID 10S TO EXISTING HVAC UNIT S622-FE AND 100 DIA BACKWASH LINE TO EXISTING 300-PD FROM HVAC UNIT S622-FE. APPROX LENGTH OF 150 DIA FSW @ 35M PLUS FITTINGS. APPROX LENGTH OF 100 DIA BACKWASH LINE @ 50M PLUS FITTINGS. MATERIAL TO MATCH EXISTING. REFER TO EXISTING CLIENT DRAWING SEP-447 PROVIDED WITH THIS PACKAGE.

**LOWER LEVEL PLAN - PART B**  
 1:50

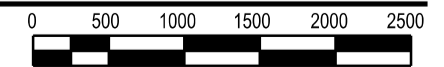

**APEGM**  
 Certificate of Authorization  
 CH2M HILL Canada Ltd.  
 No. 1441

SEE NOTE 1

NO.	REVISIONS	DATE	DESIGN	CHECK
05	ISSUED FOR ADDENDUM 3 - 976-2016	2017/06/21	B.C.	J.C.
04	ISSUED FOR CONSTRUCTION - 976-2016	2017/04/05	B.C.	J.C.
03	ISSUED FOR CONSTR - B.O. 899-2015	04/2016	B.C.	J.C.
02	ISSUED FOR 90% PRELIMINARY REVIEW	04/2016	B.C.	J.C.
01	ISSUED FOR ADD. 4 - B.O. 899-2015	03/2016	B.C.	J.C.
00	ISSUED FOR TENDER - B.O. 899-2015	01/2016	B.C.	J.C.

**CH2MHILL**  
 SNC-LAVALIN  
 DESIGNED BY: F. ABSI  
 CHECKED BY: B. EDGAR  
 DRAWN BY: B. COOPER  
 APPROVED BY: H.T. FREIHAMMER  
 SCALE: 1:50  
 DATE: 2017/04/05  
 CONSULTANT NO.: 474248

ENGINEER'S SEAL  
 21 JUNE 2017  
**F. J. ABSI**  
 Member  
 38875  
 REGISTERED PROFESSIONAL ENGINEER

**THE CITY OF WINNIPEG**  
 WATER AND WASTE DEPARTMENT  
 SOUTH END WATER POLLUTION CONTROL CENTRE  
 SEWPCU UPGRADING/EXPANSION PROJECT  
 PROCESS  
 SECONDARY CLARIFIERS 4 AND 5  
 LOWER LEVEL PLAN - PART B  
 CITY DRAWING NUMBER: 1-0102-PGAD-S003  
 SHEET: 001  
 REV: 05  
 SIZE: A1

