


B SECTION
1:100
PGAD-T003

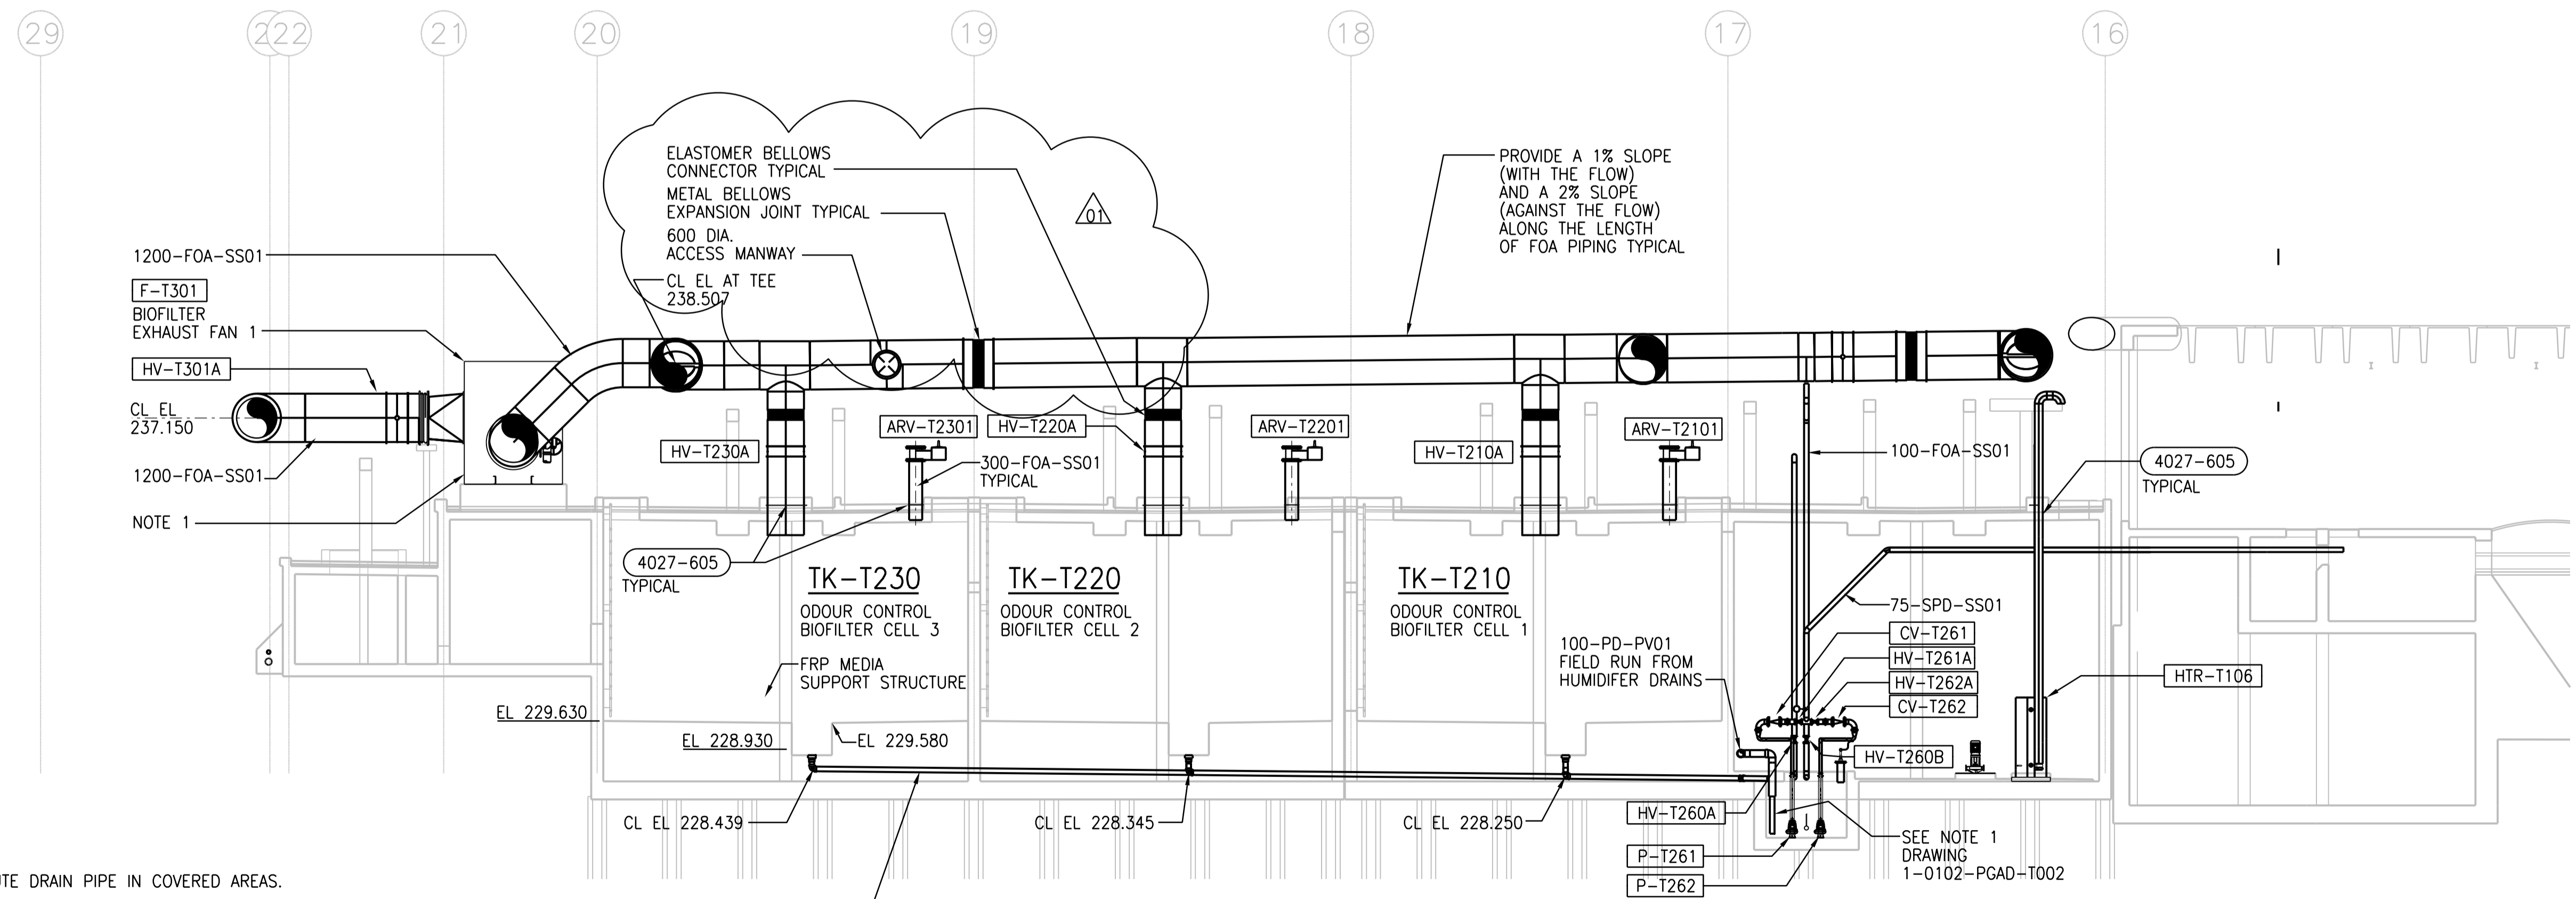

C SECTION
1:100
PGAD-T003

NOTE 1: FIELD ROUTE DRAIN PIPE IN COVERED AREAS.

100-PD-PV01
EL VARIES, SLOPE
@ 1% TYPICAL

APEGM
Certificate of Authorization
CH2M HILL Canada Ltd.
No. 1441

NO.	REVISIONS	DATE	DESIGN	CHECK
01	ISSUED FOR ADDENDUM 3 - 976-2016	2017/06/21	B.C.	J.C.
00	ISSUED FOR CONSTRUCTION - 976-2016	2017/04/05	S.S.	J.C.

CH2MHILL		ENGINEER'S SEAL	
SNC-LAVALIN		21 JUNE 2017	
DESIGNED BY: F ABSI	CHECKED BY: B EDGAR		
DRAWN BY: B COOPER	APPROVED BY: H.T. FRIEHAMMER		
SCALE: 1:100	ISSUED FOR CONSTRUCTION BY: J. SHUMKA		
DATE: 2017/04/05		DATE: 2017/04/05	
CONSULTANT NO.: 474248			

THE CITY OF WINNIPEG
Winnipeg WATER AND WASTE DEPARTMENT
SOUTH END WATER POLLUTION CONTROL CENTER
SEWPCC UPGRADING/EXPANSION PROJECT
PROCESS BIOFILTERS
SECTION B AND C

CITY DRAWING NUMBER 1-0102-PGAD-T005	SHEET 001	REV. 01	SIZE A1
---	--------------	------------	------------